
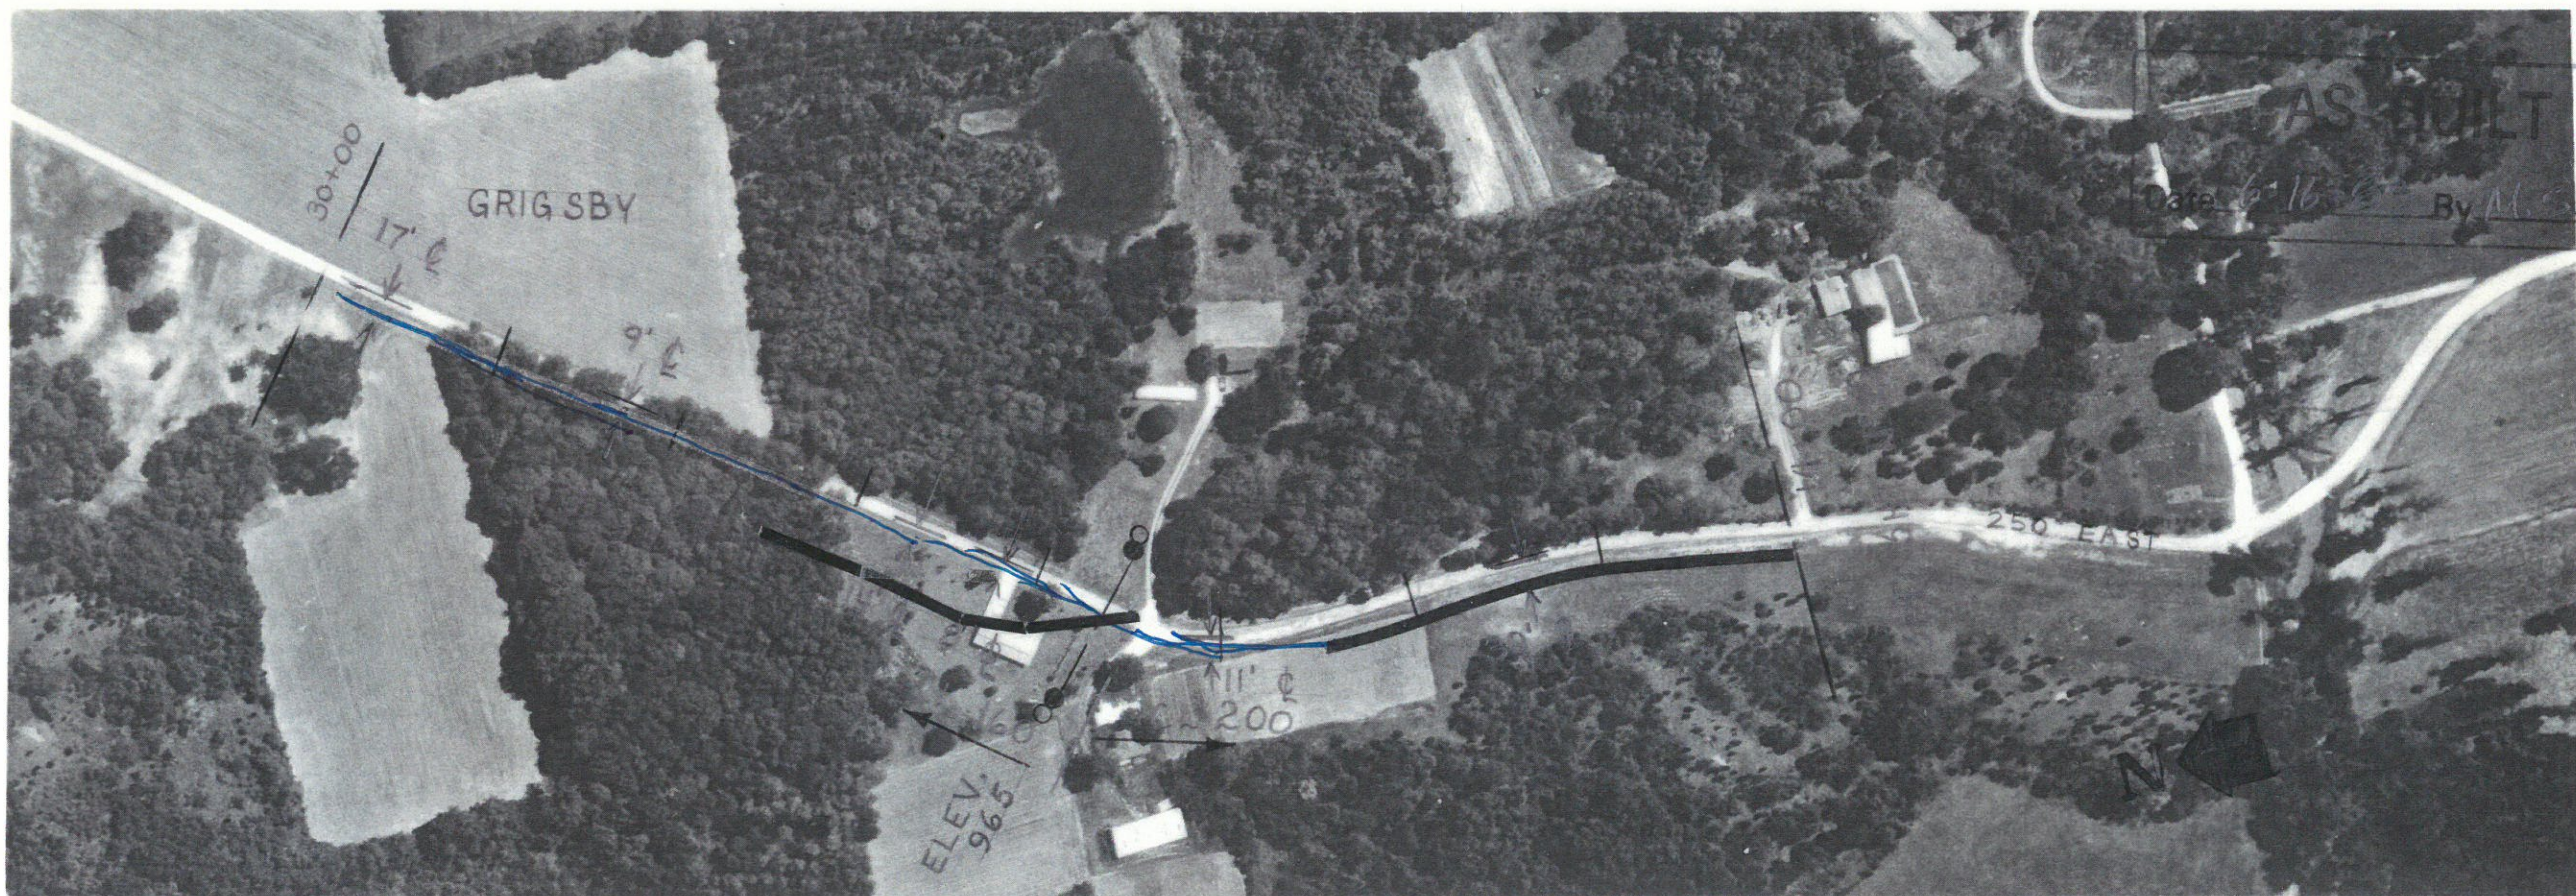


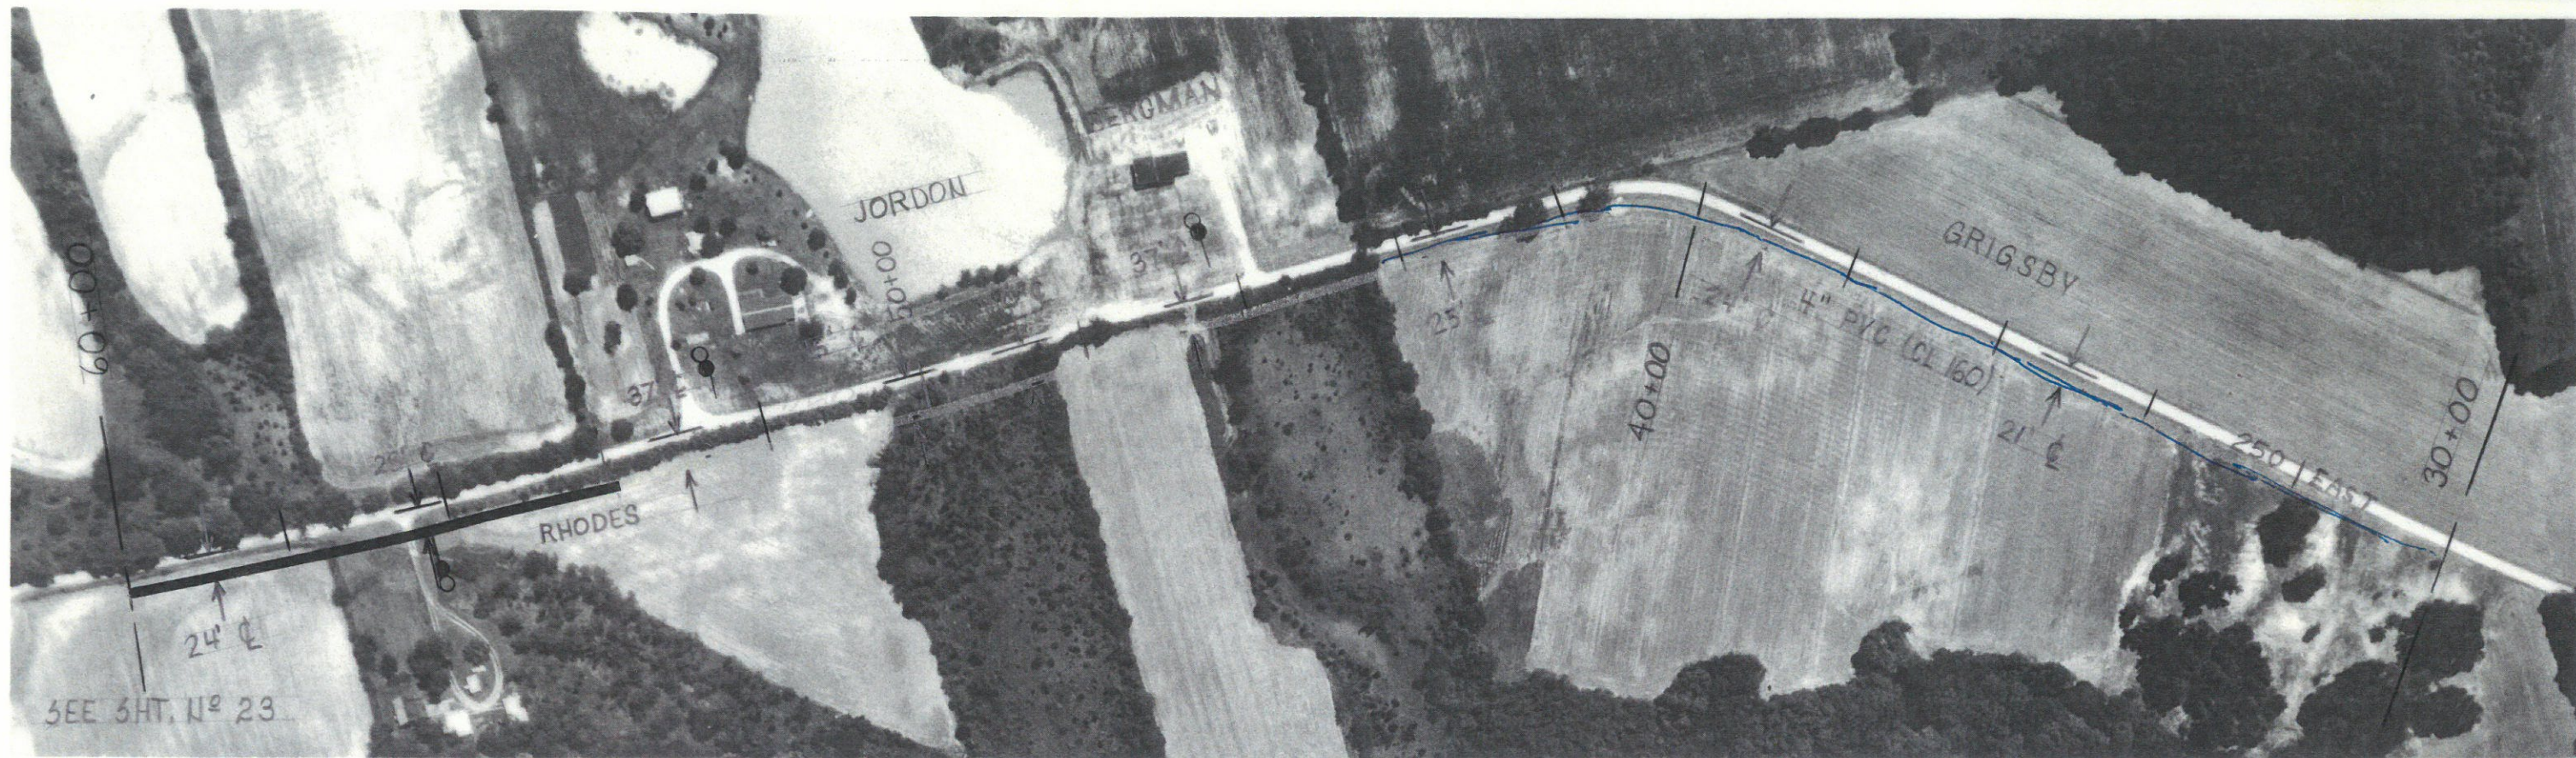

AS BUILT
Date 6/16/82 By M. Severs

4#3 END

DRAWN BY	CHECKED BY	SIECO, INC. CONSULTING ENGINEERS ARCHITECTS. PLANNERS	ELROD WATER CO, INC.	REVISED: CO. A-2 8/25/82 PH	JOB N°.	SHT. 21A
DATE	DATE					
	CERTIFIED BY					
	DATE			DIVISION: LINE 12	SCALE: 1"=200'	OF