
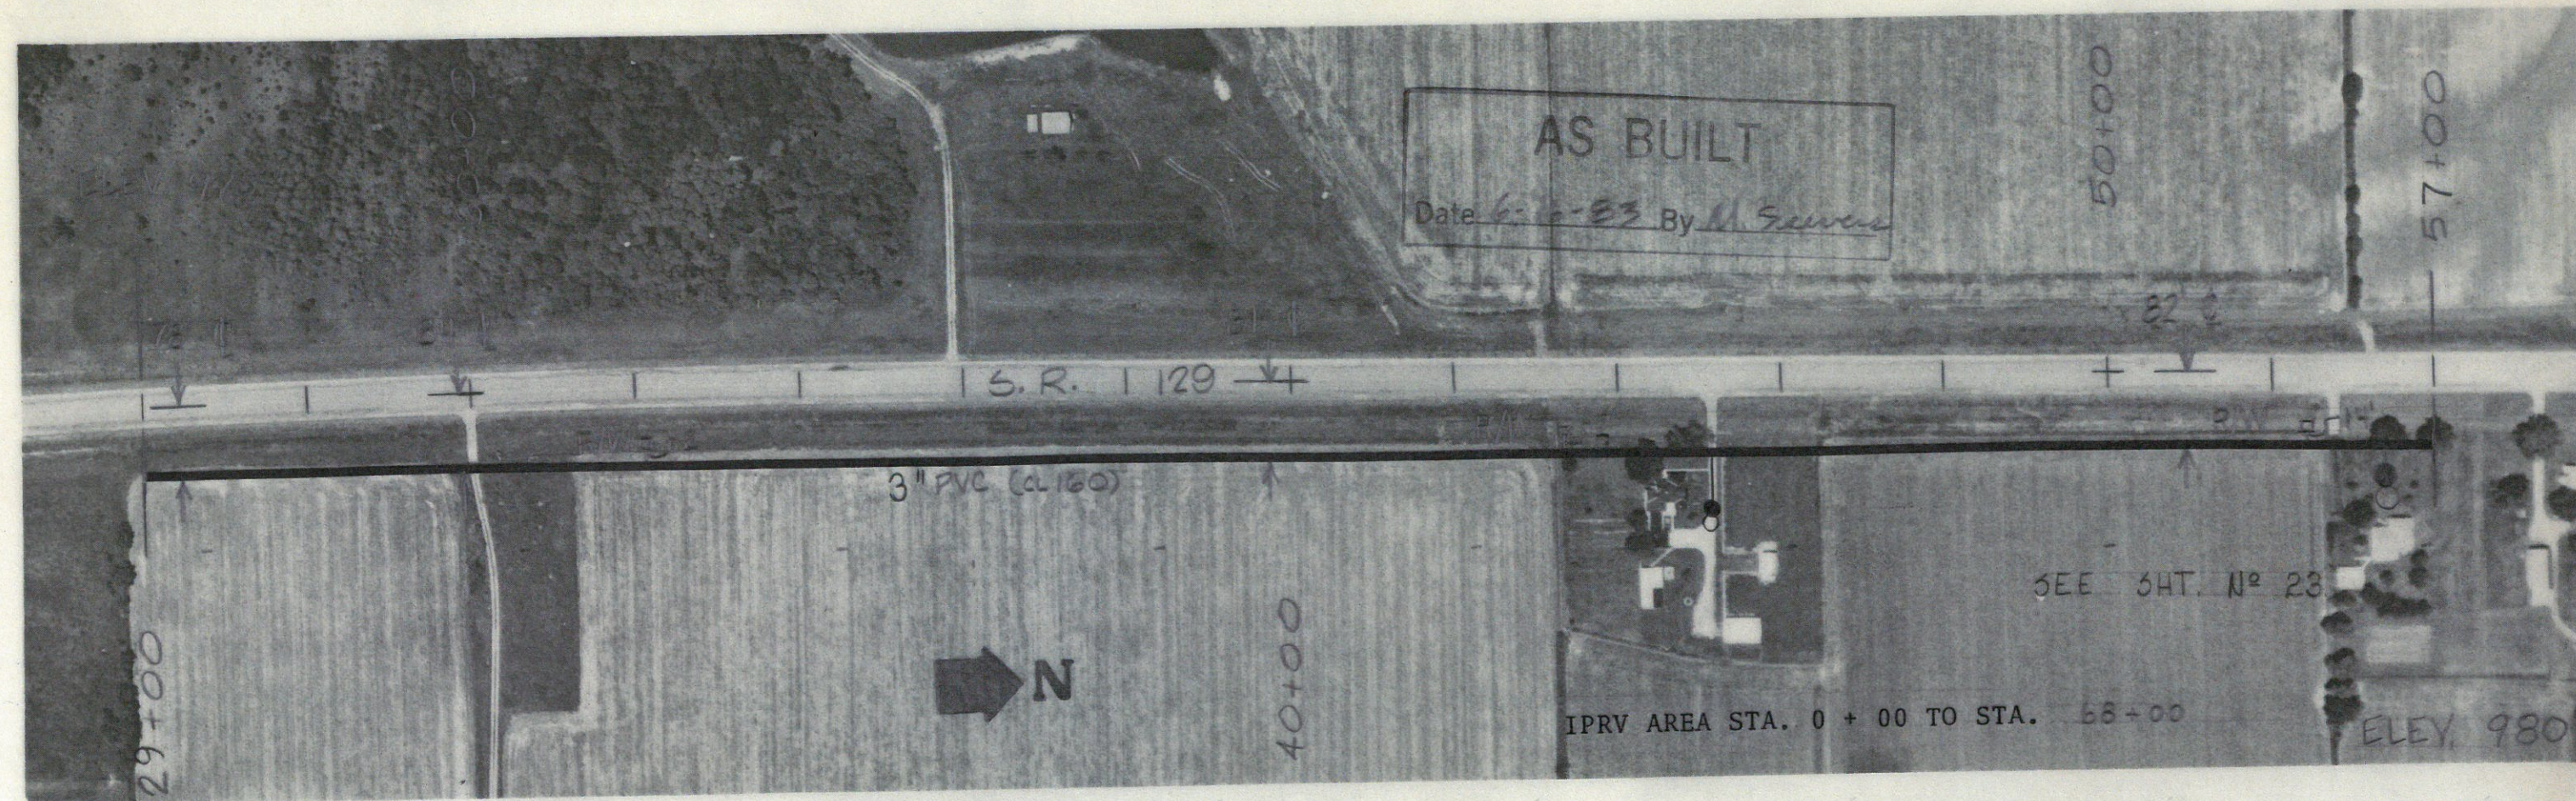


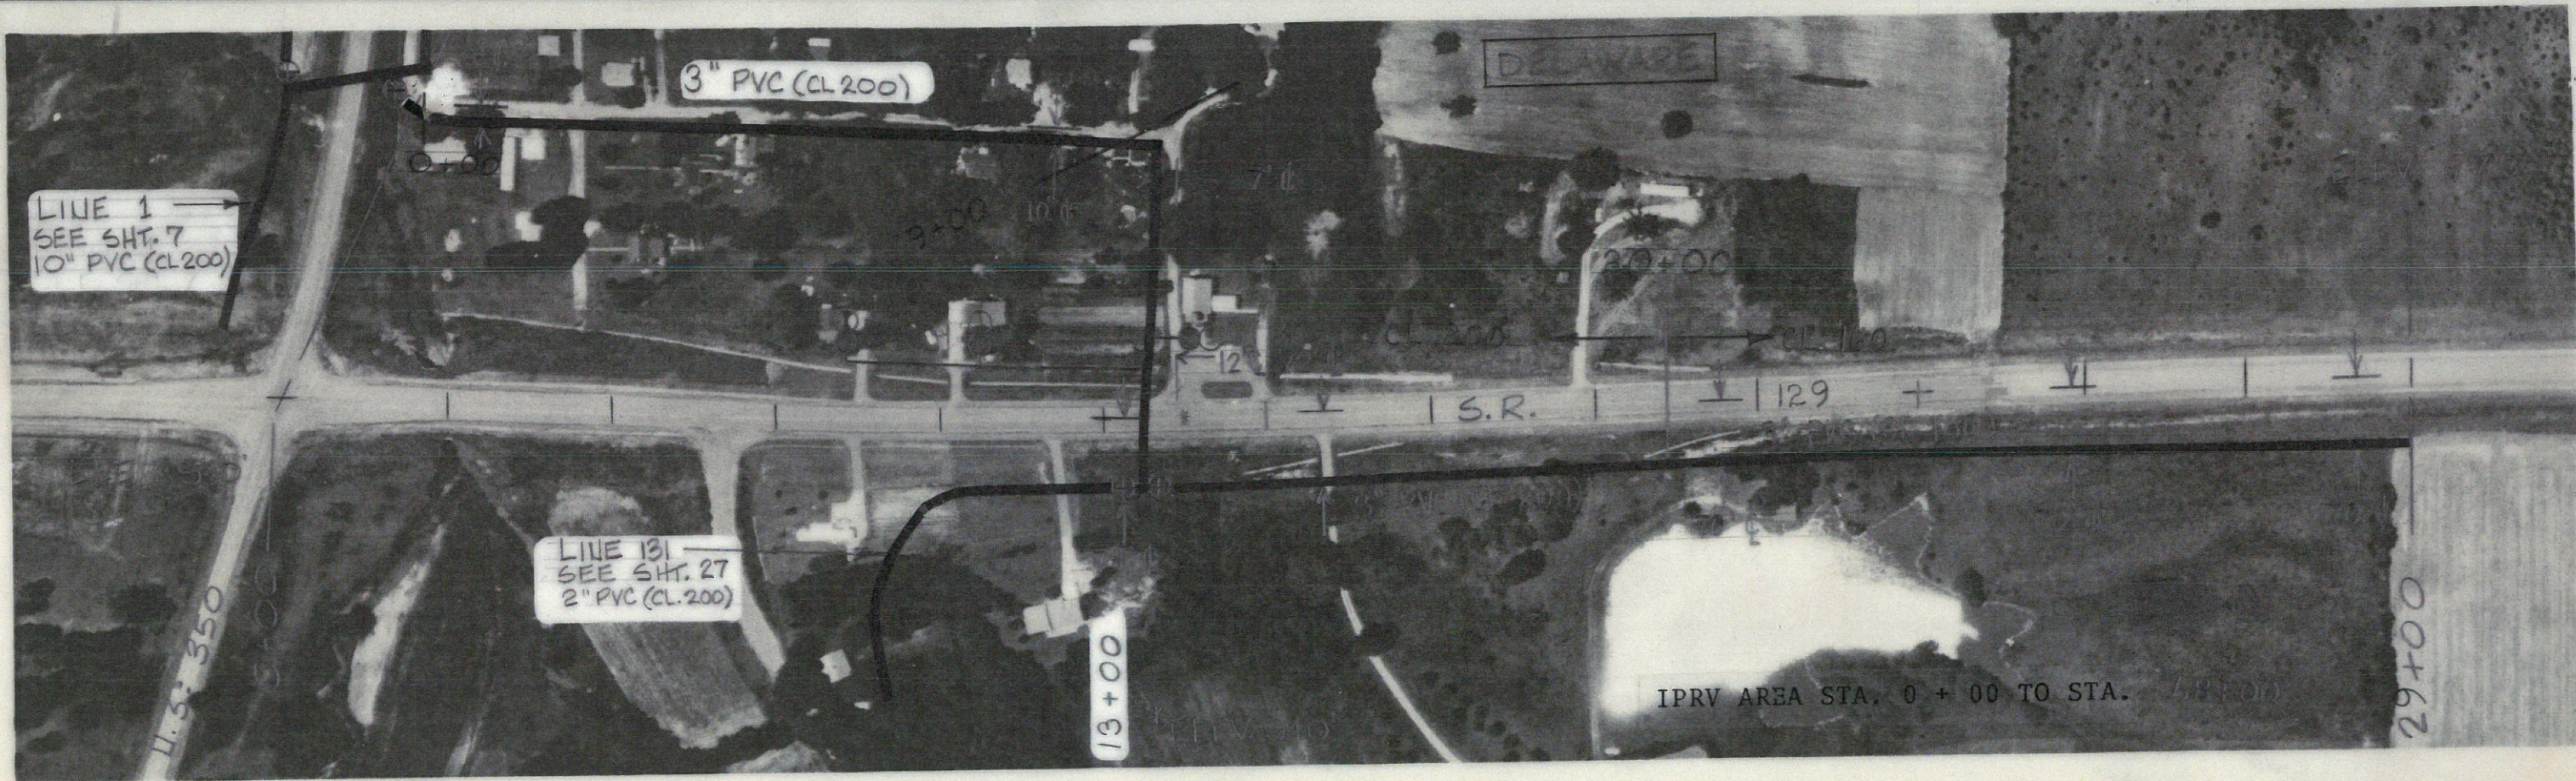

DRAWN BY	WDD	CHECKED BY	David H. H.	SIECO, INC. CONSULTING ENGINEERS ARCHITECTS.. PLANNERS	ELROD WATER CO, INC.	REVISED	C.O. A-2	8/25/82	PH	JOB NO.	61140	SHT.	22
DATE	7-24-79	DATE	1-31-80			DIVISION:	LINE 13	SCALE:	1"=200'	OF	89		
		CERTIFIED BY	JPM										
		DATE											