
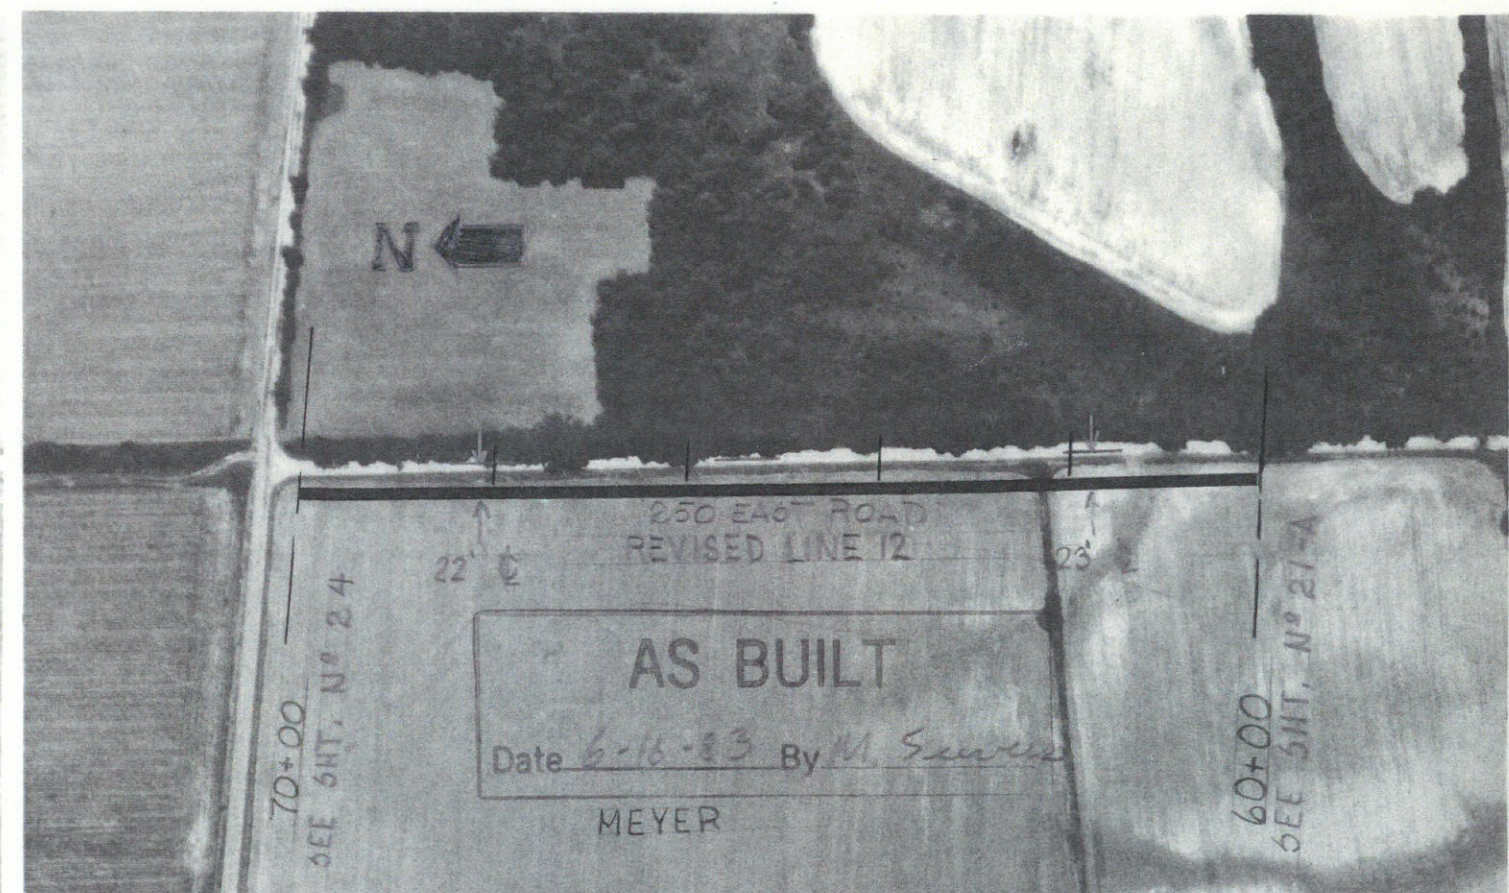
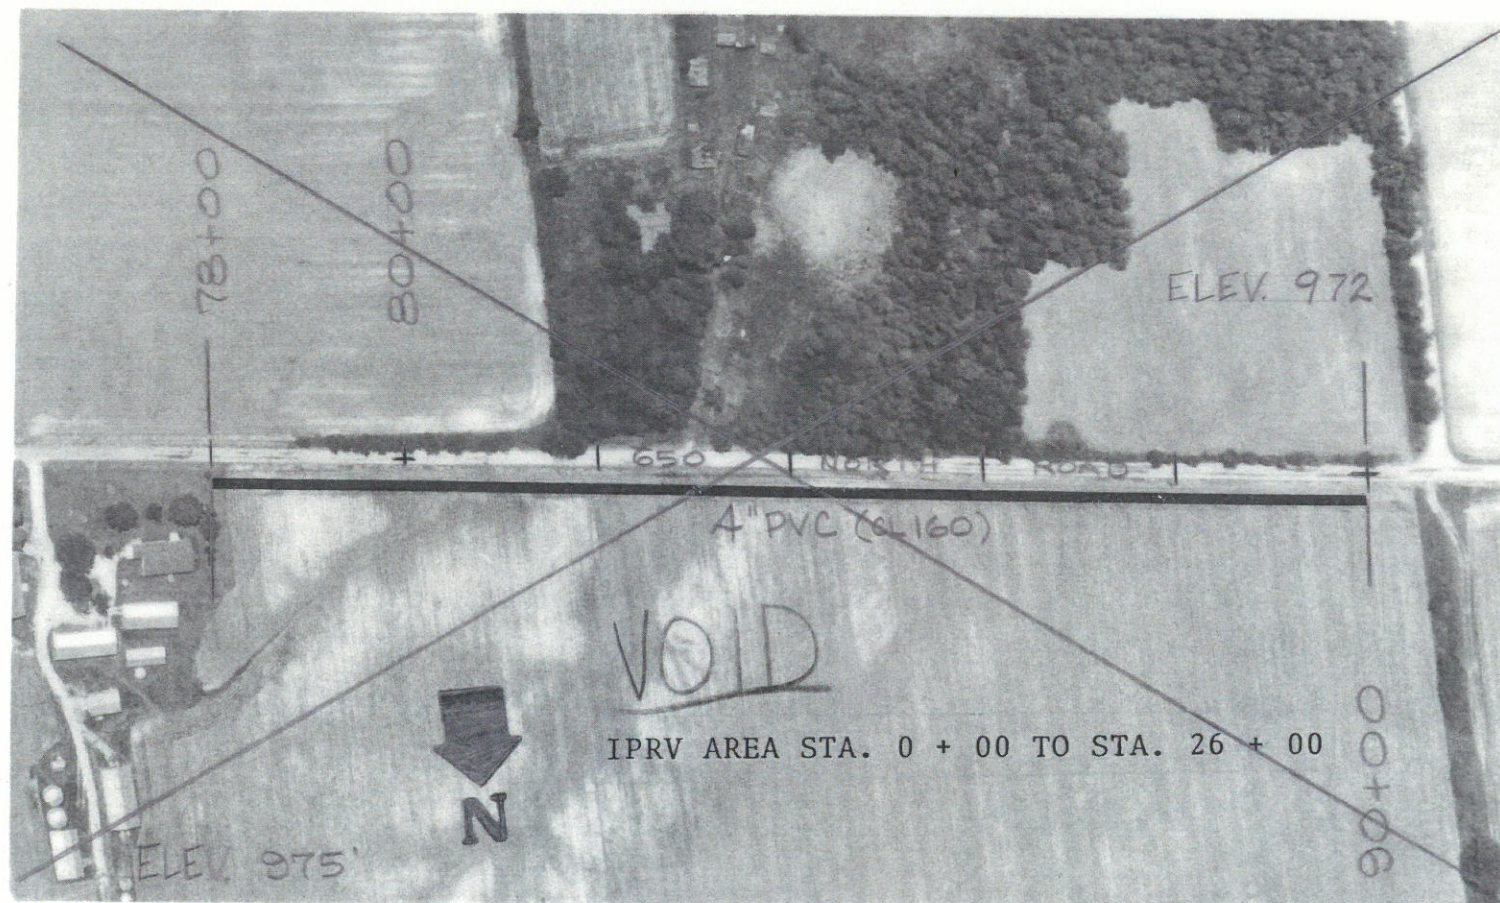
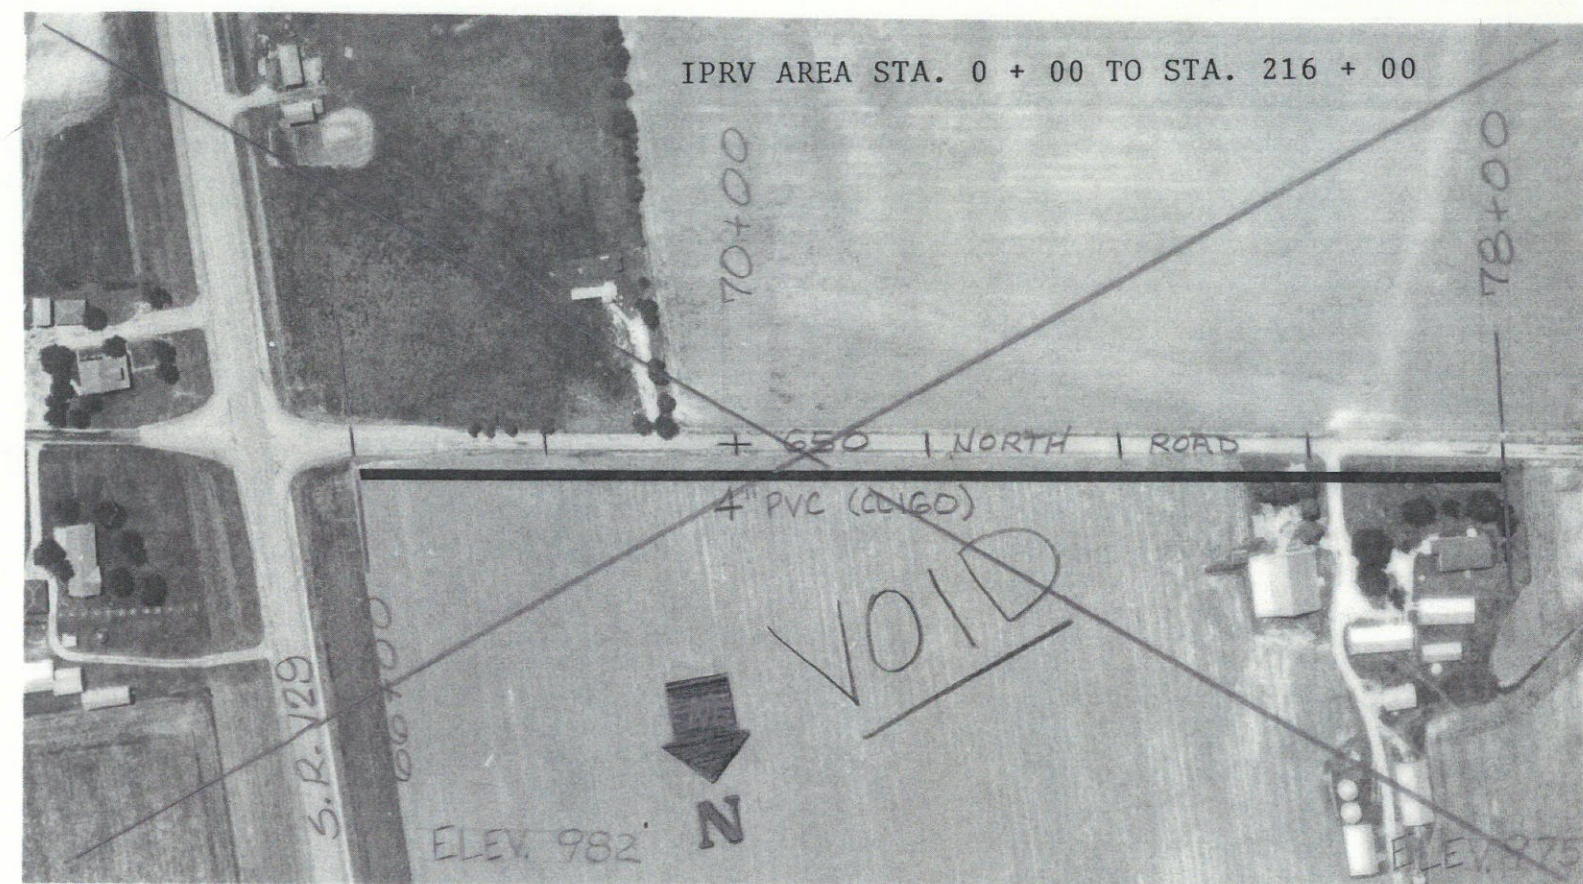


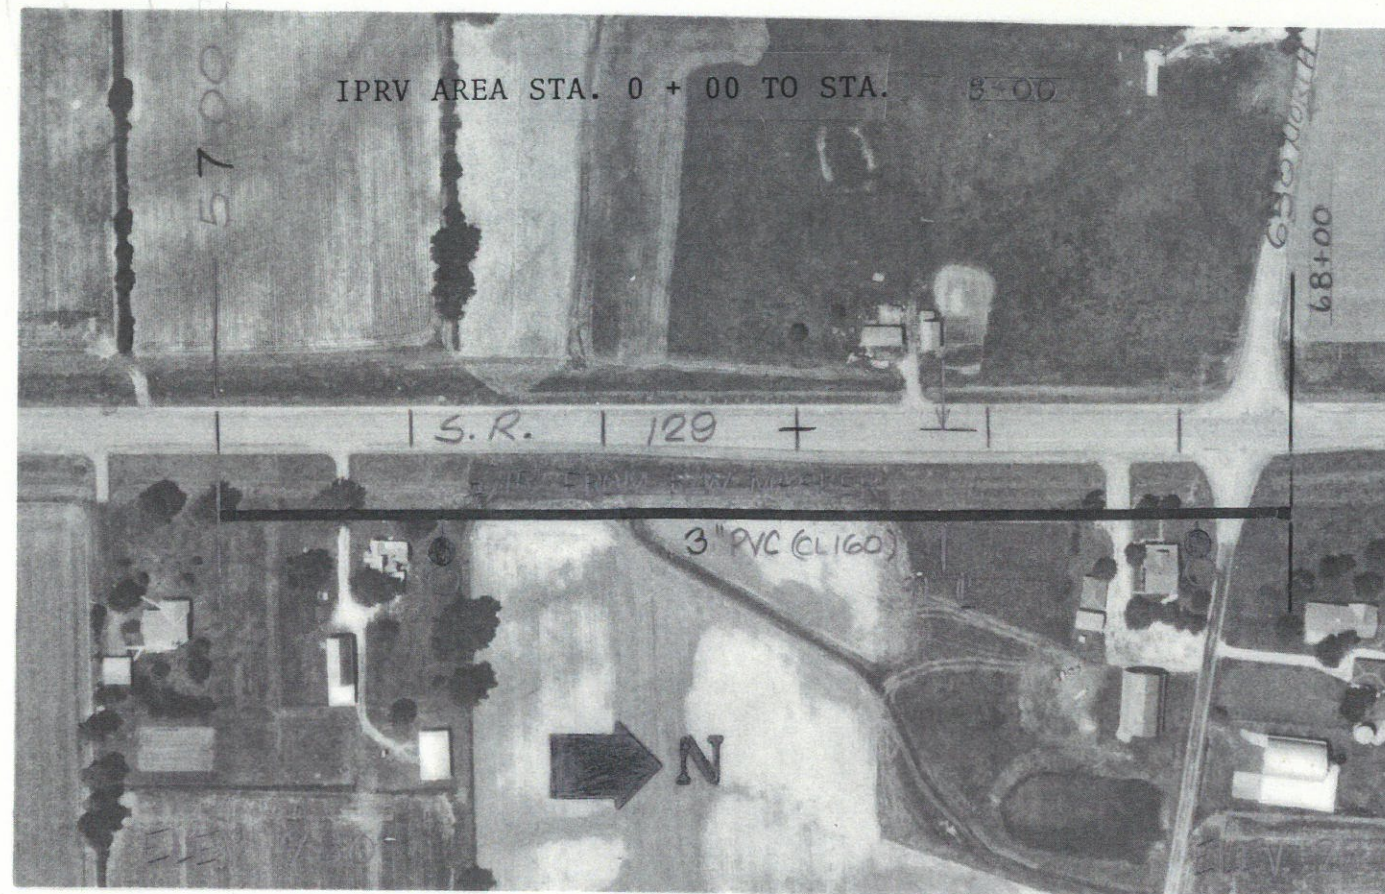

DRAWN BY	WDM	CHECKED BY	David
DATE	7-24-79	DATE	1-21-80
		CERTIFIED BY	AM
		DATE	

SIECO, INC.
CONSULTING ENGINEERS
ARCHITECTS, PLANNERS

ELROD WATER CO, INC.

REVISED: C.O.A-2 8/25/82 PH
DIVISION: LINE 13 & LINE 12

JOB NO.	61140	SHT.	23
SCALE:	1"=200'	OF	89