



N

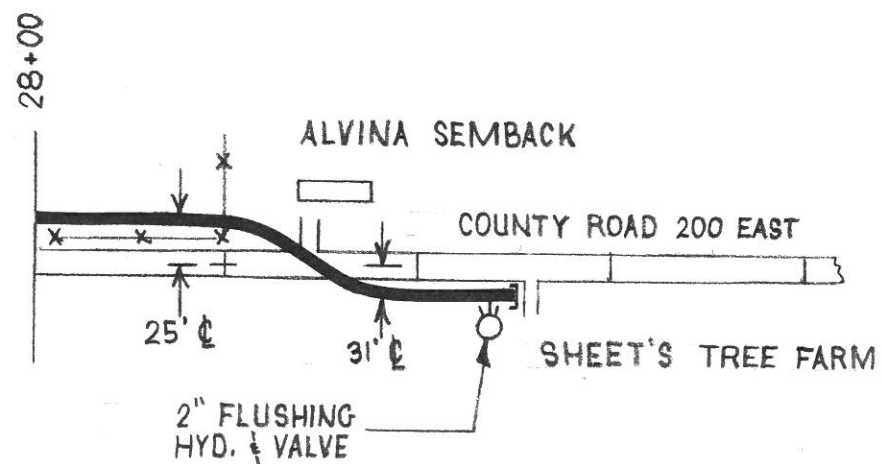

AS BUILT

Date 6-16-83 By M. Seewers

 CONSULTING ENGINEERS, ARCHITECTS, PLANNERS	JOB	61140
	SHEET NO.	24B
	SCALE	1" = 200'
	DATE	3-16-83
	DRAWN	M. SEEVERS
	CHECKED	
	APPROVED	
CERTIFIED		
ELROD WATER COMPANY, INC. RIPLEY CO., IND. LINE 121		