


AS BUILT
Date 6-16-83 By M. S.

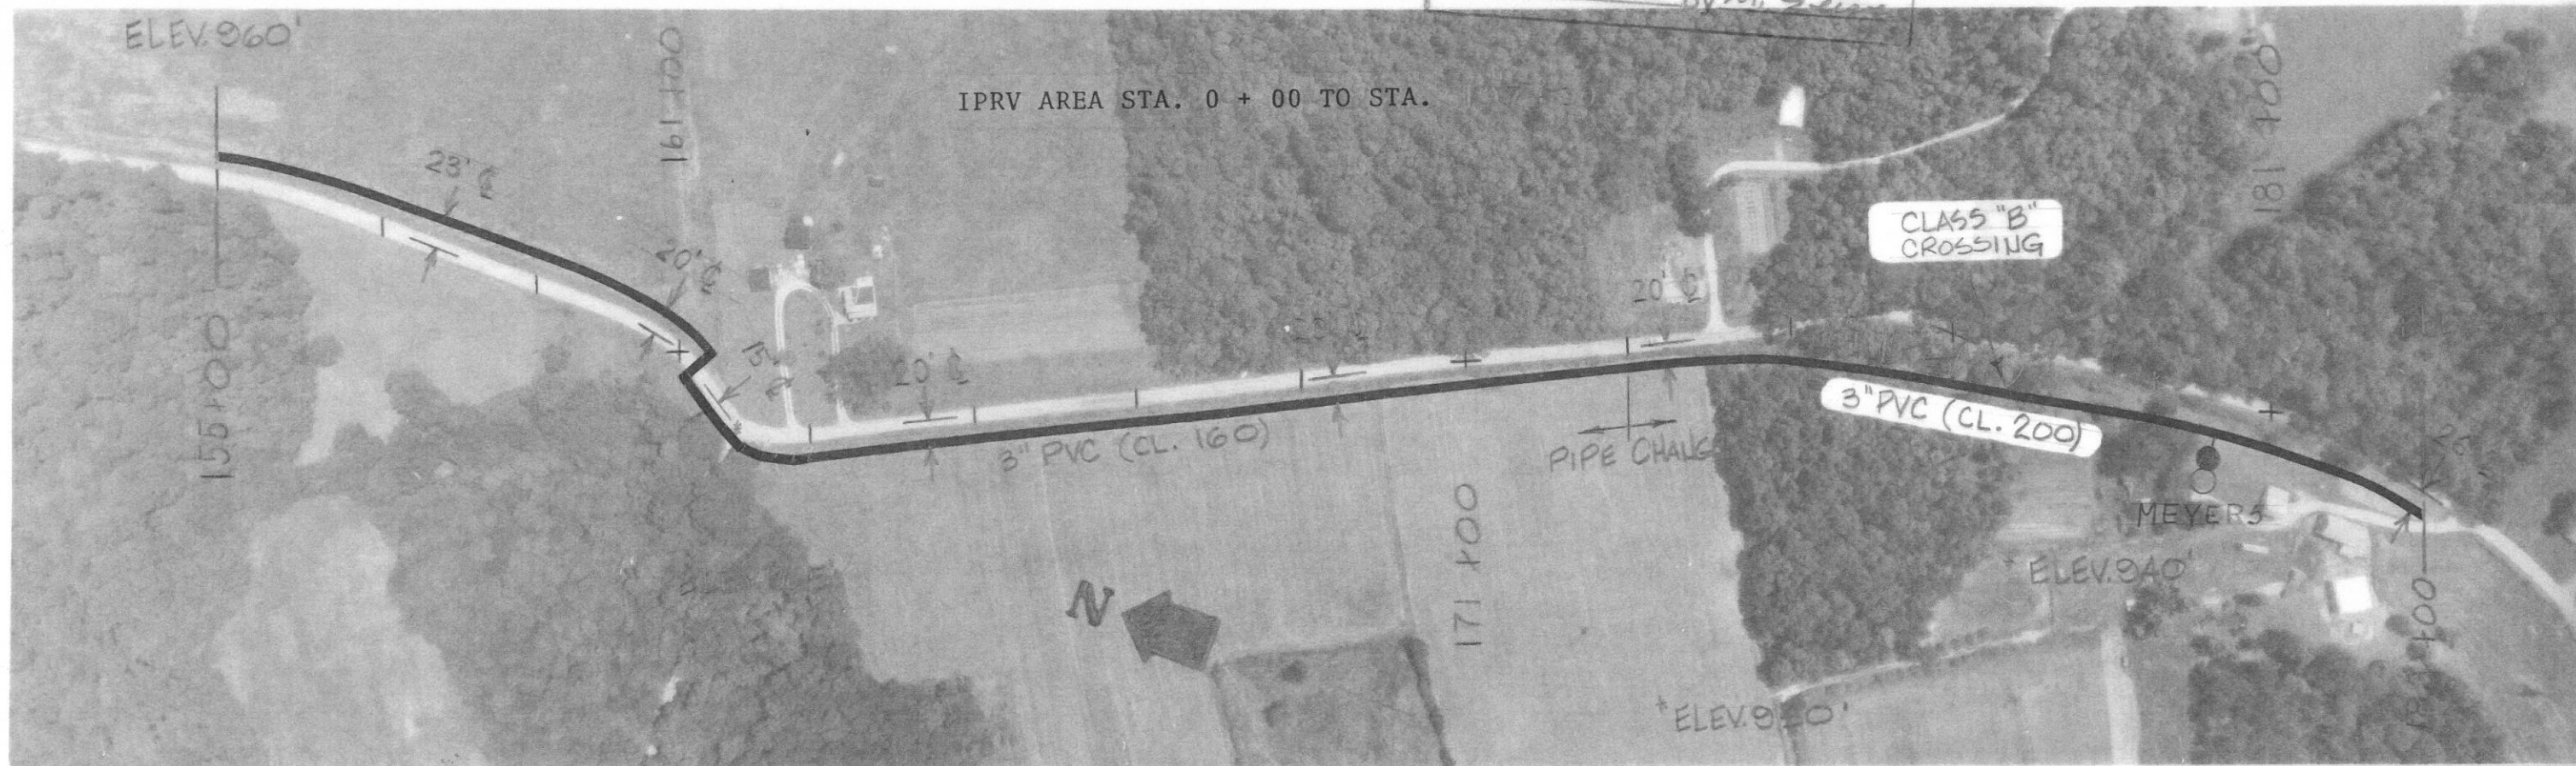

| | | | | | | | | | | | |
|----------|---------|--------------|----------------------|--|--|------------------------------|--|---------|---------|-----|----|
| DRAWN BY | WDJ | CHECKED BY | David J. [Signature] | SIECO, INC. CONSULTING ENGINEERS, ARCHITECTS, PLANNERS | | REVISED: C.O. A-2 8/27/82 PH | | JOB NO. | 61140 | SHT | 25 |
| DATE | 7-24-79 | DATE | 1-31-80 | | | | | SCALE | 1"=200' | OF | 89 |
| | | CERTIFIED BY | [Signature] | ELROD WATER CO, INC. | | DIVISION: LINE 12 | | | | | |
| | | DATE | | | | | | | | | |