
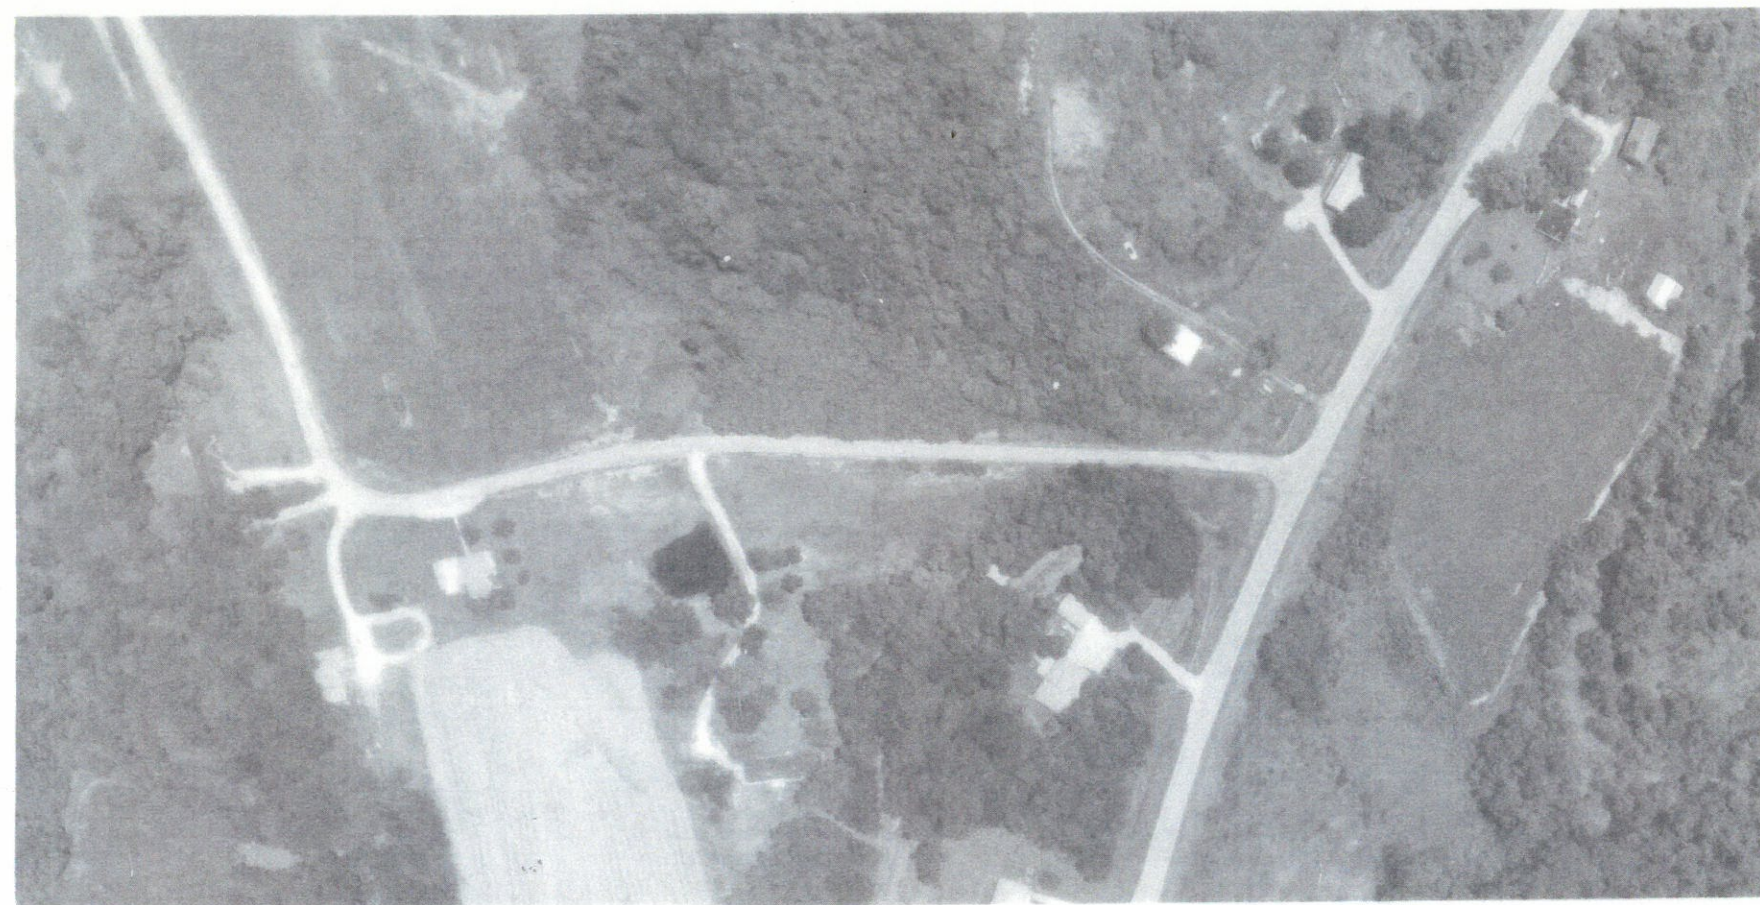
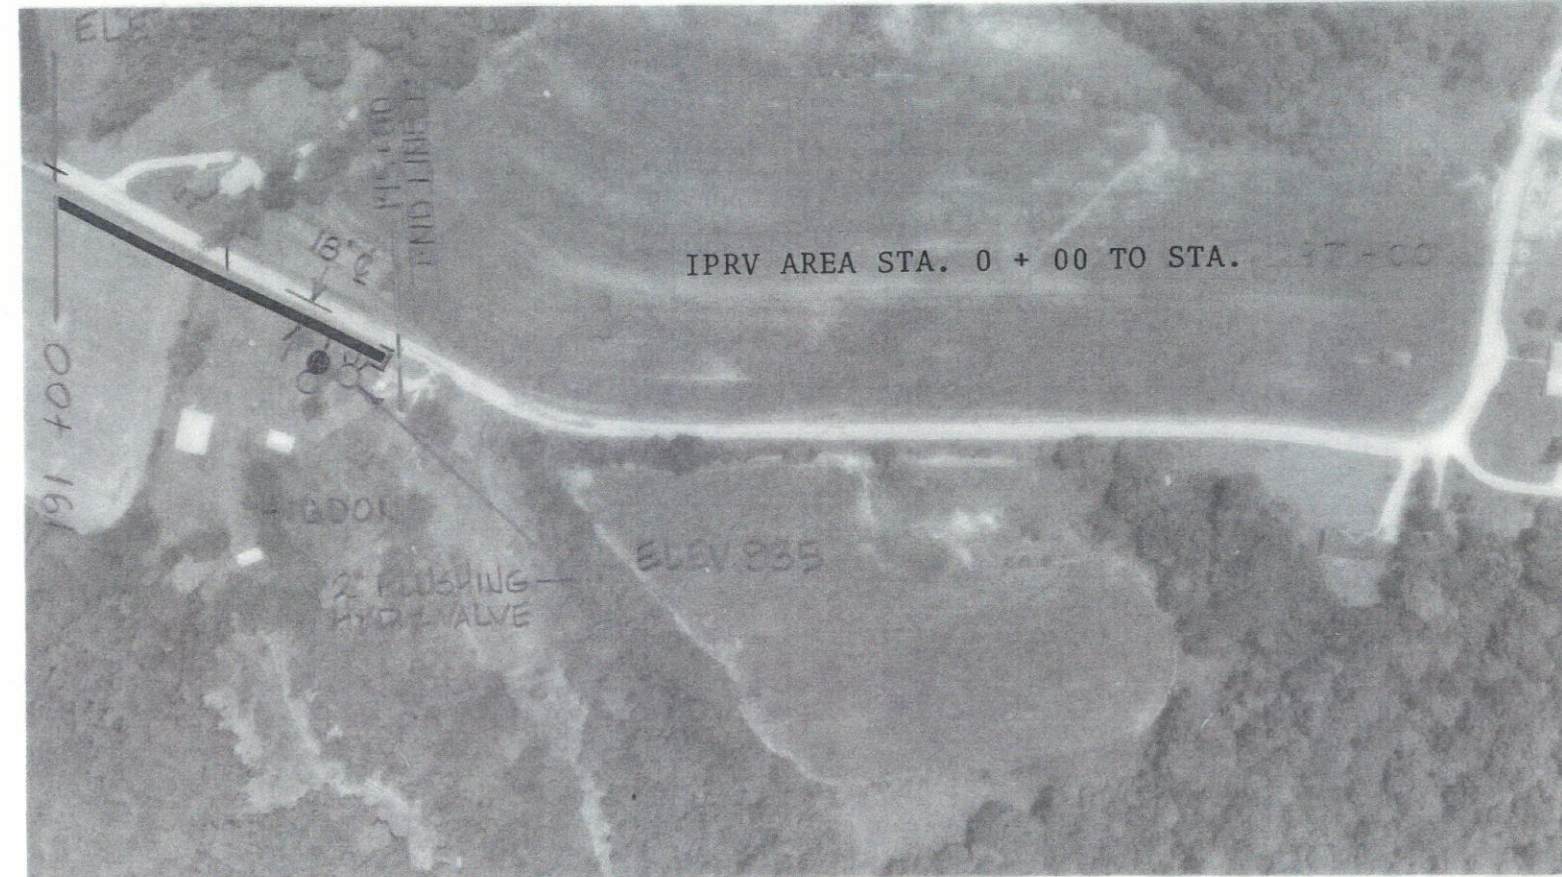


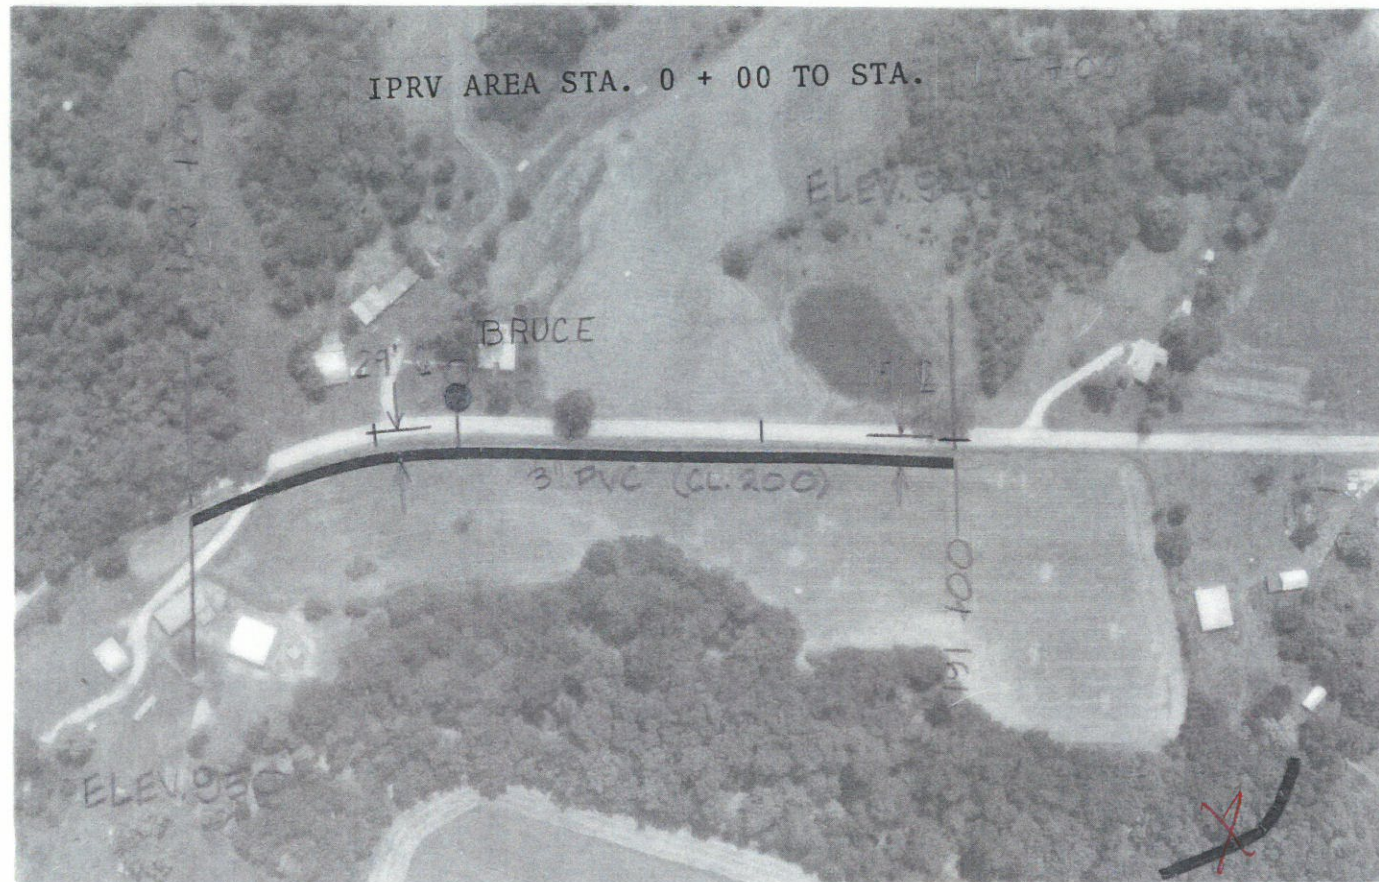

AS BUILT

Date 6-16-83 By M. Sewers

DRAWN BY	WDJ	CHECKED BY	David H. H.
DATE	11-20-78	DATE	1-21-80
		CERTIFIED BY	JMA
		DATE	

SIECO, INC.
CONSULTING ENGINEERS,
ARCHITECTS, PLANNERS

ELROD WATER CO, INC.

REVISE: C.O. A-2 8/27/82 PH
DIVISION: LINE 12

JOB NO.	61140	SHT.	26
SCALE	1"=200'	OF	89