
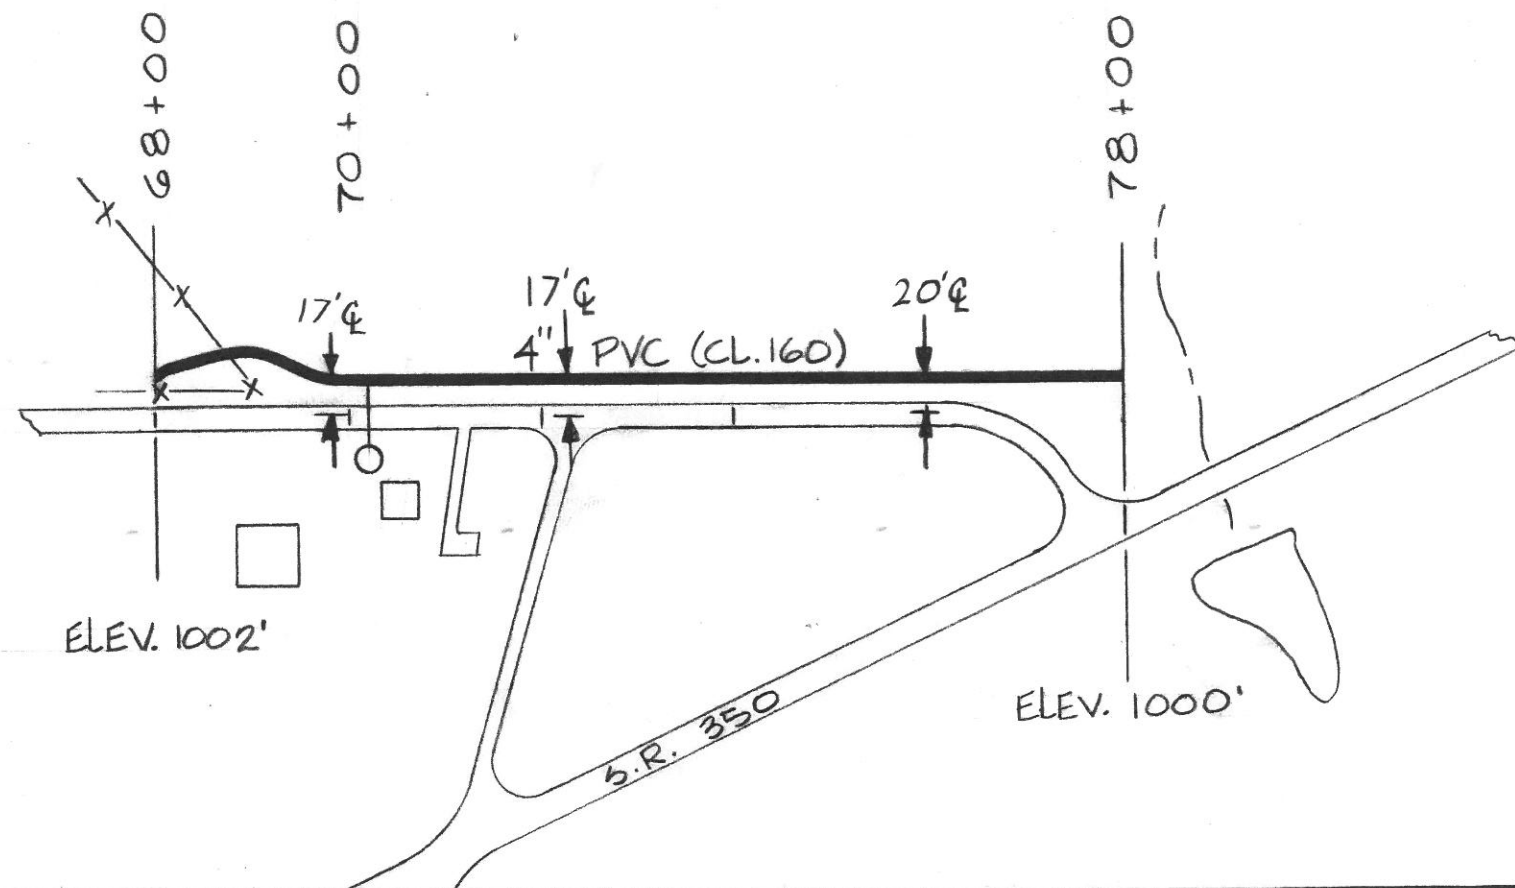
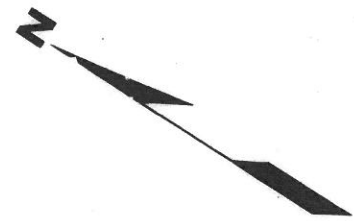
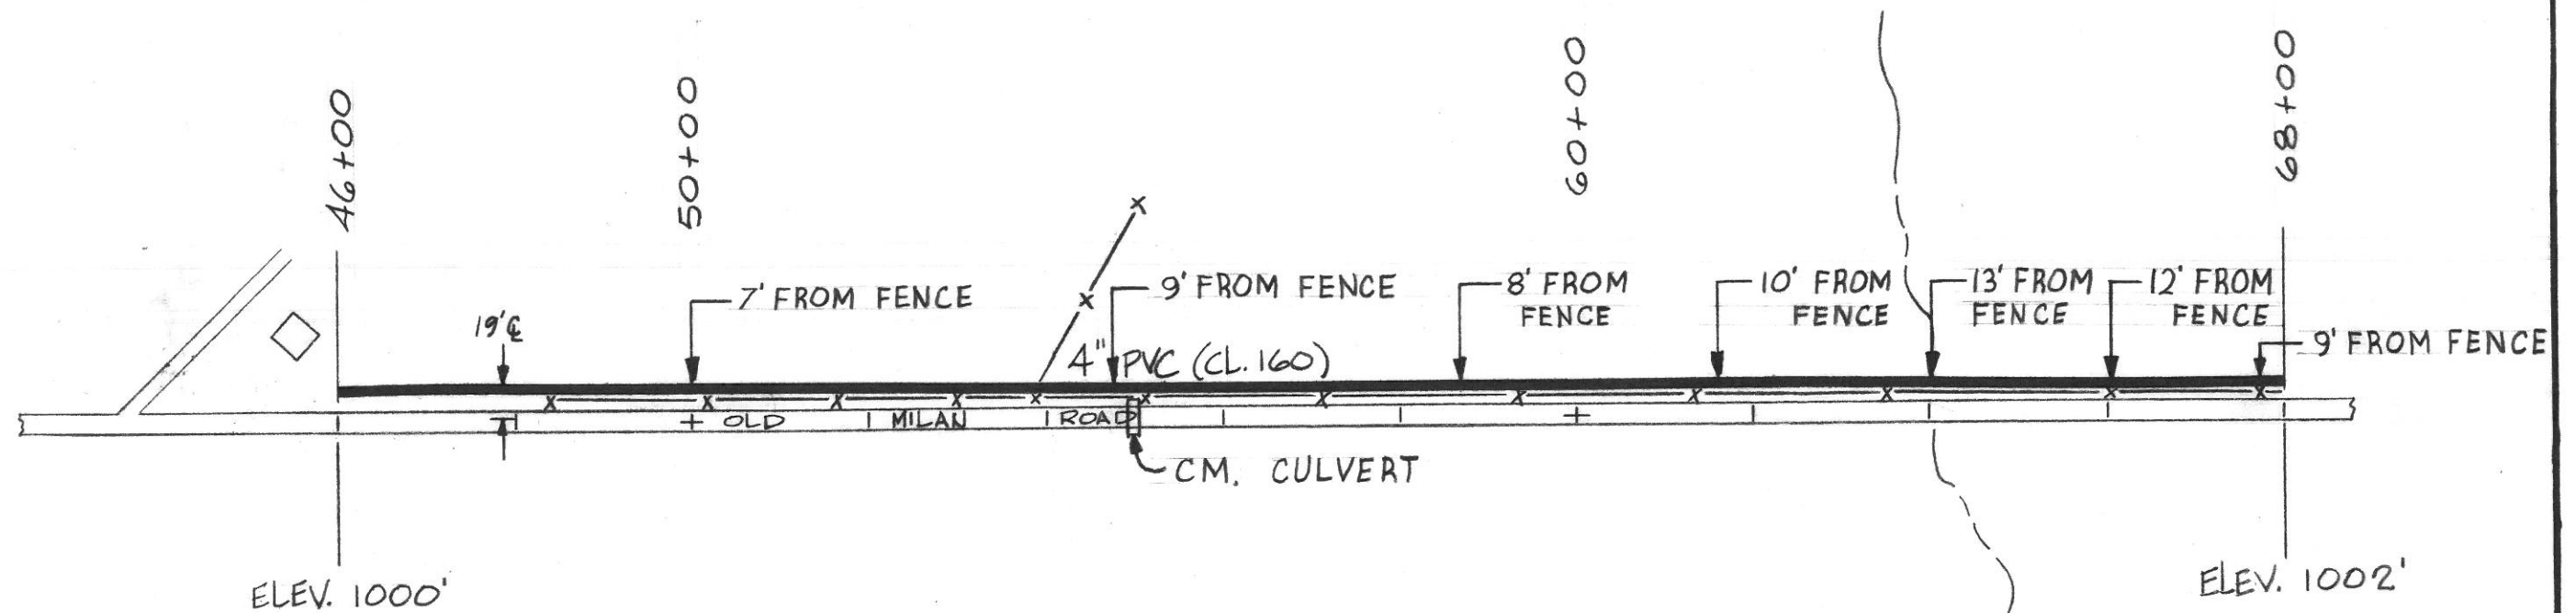


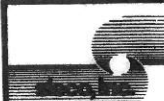

AS BUILT
 Date 6-16-83 By M. Sewer

 CONSULTING ENGINEERS, ARCHITECTS, PLANNERS Columbus, Indiana Madison, Indiana Delaware, Ohio	JOB	61140
	SHEET NO	30 OF 89
	SCALE	1" = 200'
	DATE	10-2-80
	DRAWN	W.D. JETT
	CHECKED	David Jett
	APPROVED	
	CERTIFIED	
ELROD WATER COMPANY, INC. RIPLEY CO., IND. LINE 15		