
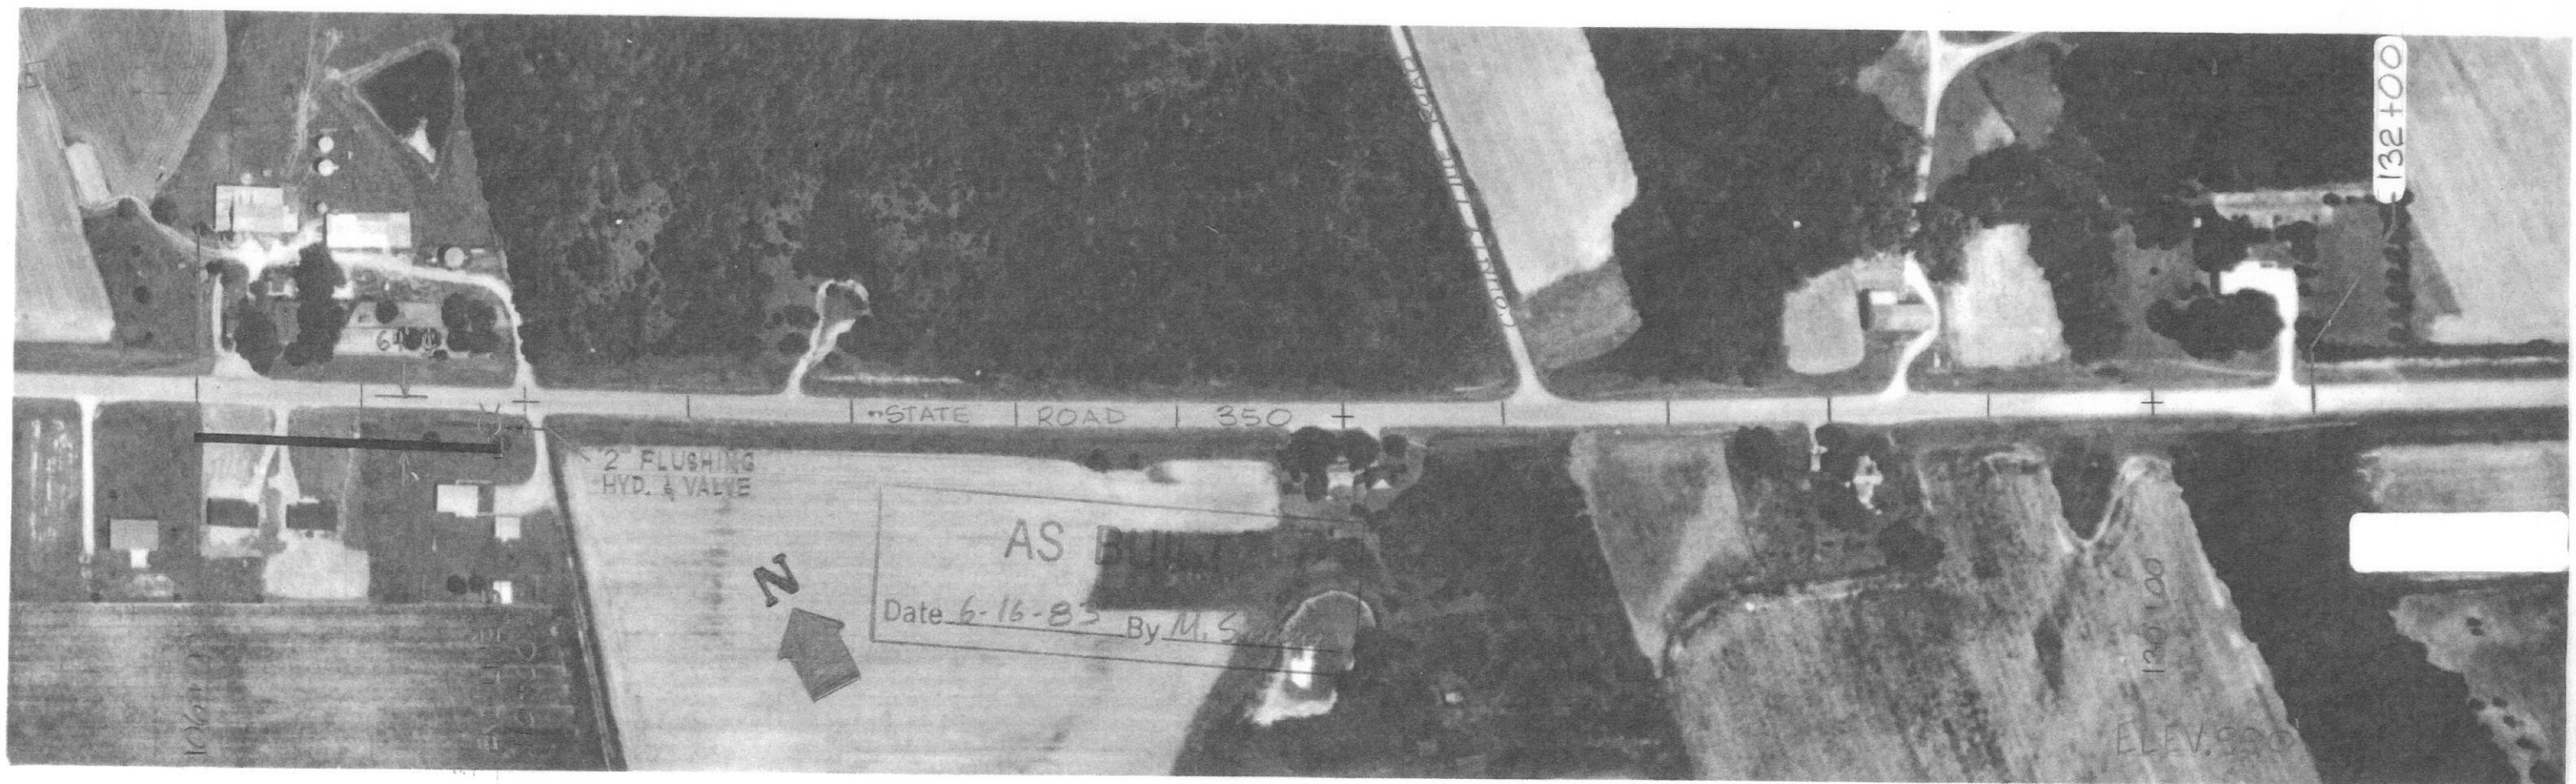


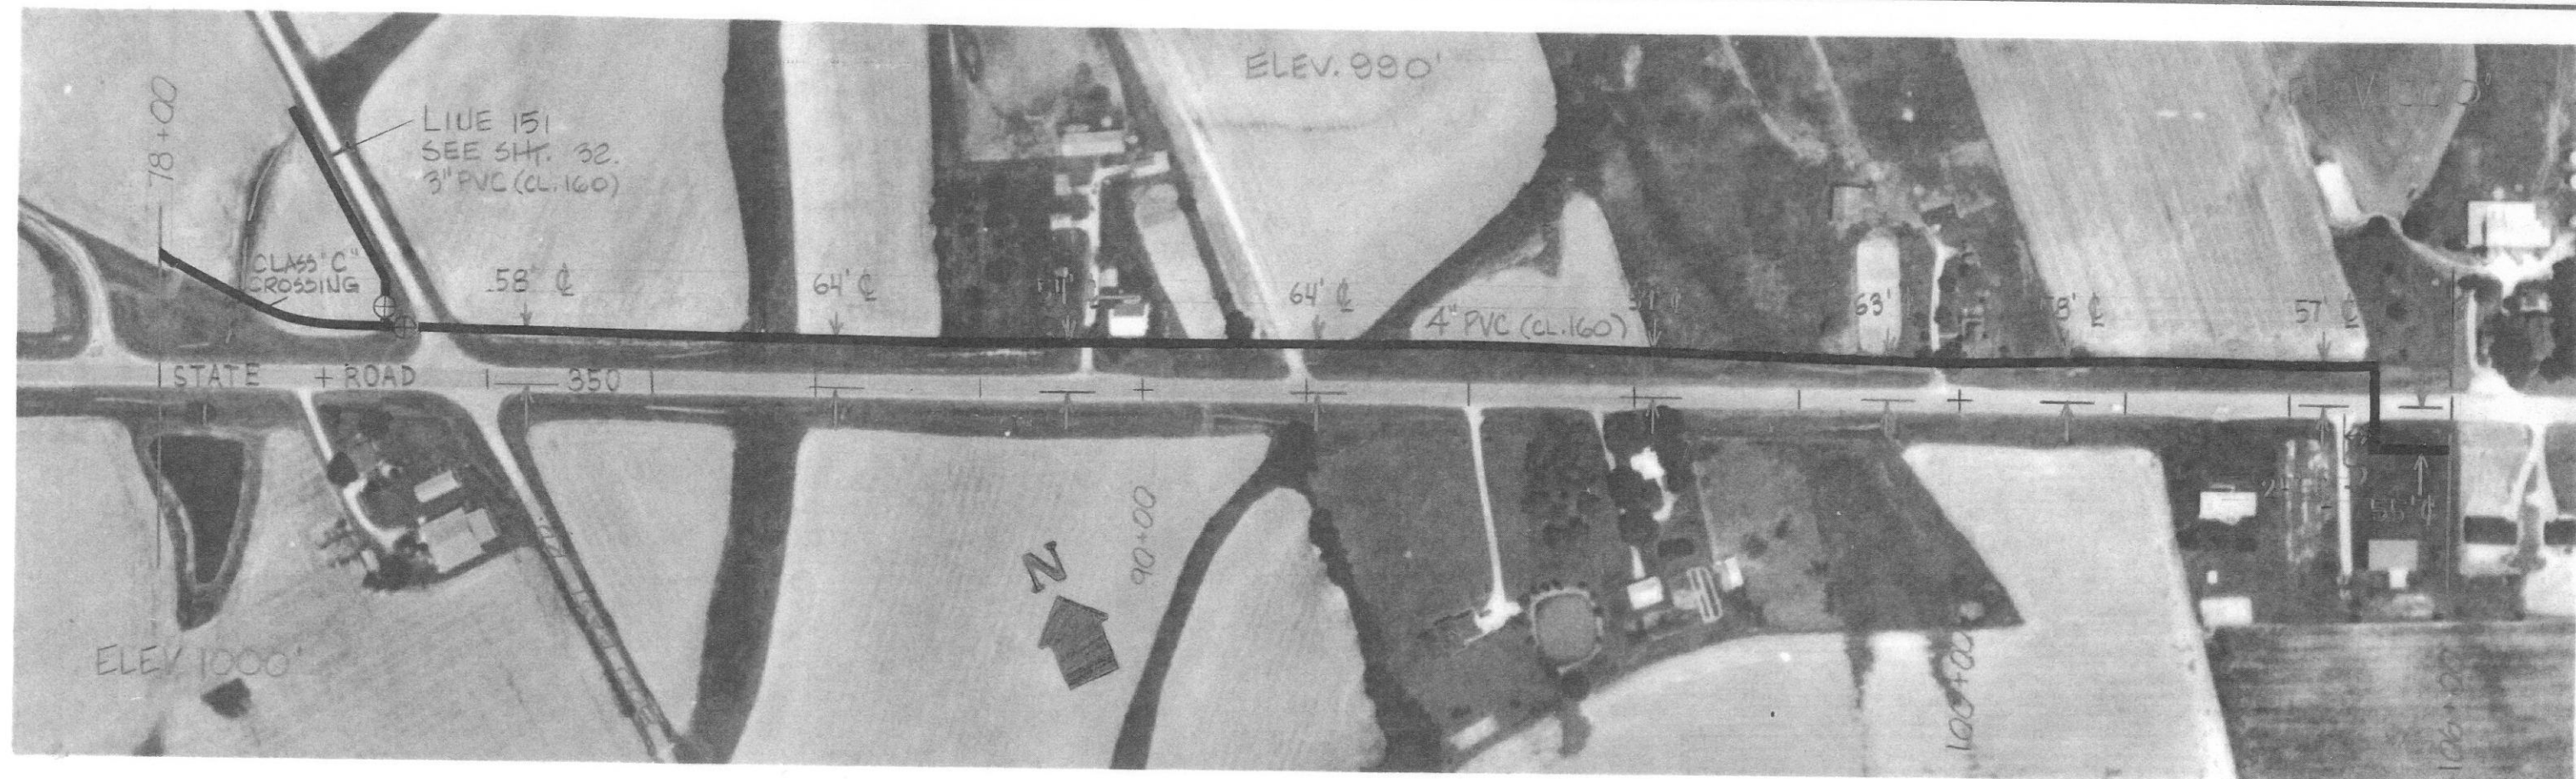

DRAWN BY DATE	BY 7-25-79	CHECKED BY DATE	BY 1-31-80	SIECO, INC. CONSULTING ENGINEERS ARCHITECTS. PLANNERS	ELROD WATER CO, INC.	DIVISION: LINE 15	JOB NO. 61140	SHT. 31
							SCALE: 1"=200'	OF 89