
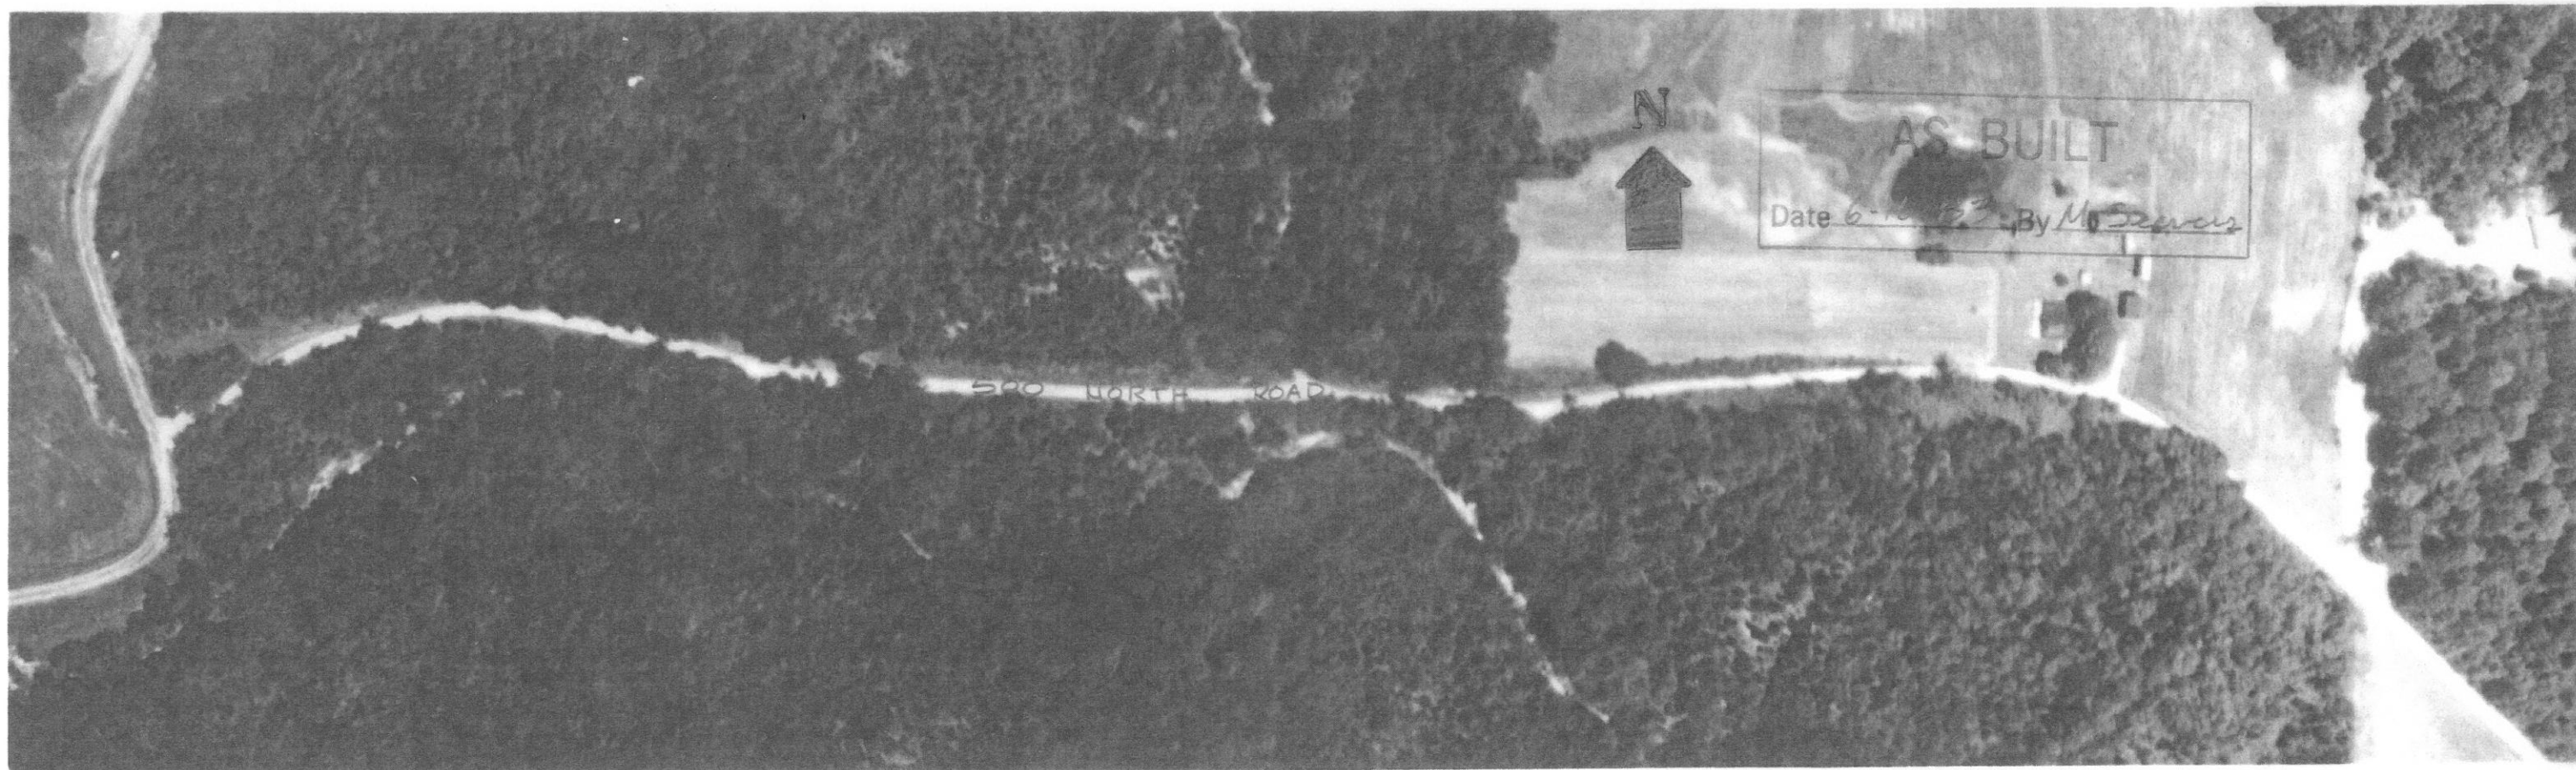


IPRV AREA STA. 63 + 00 TO STA. 78 + 00

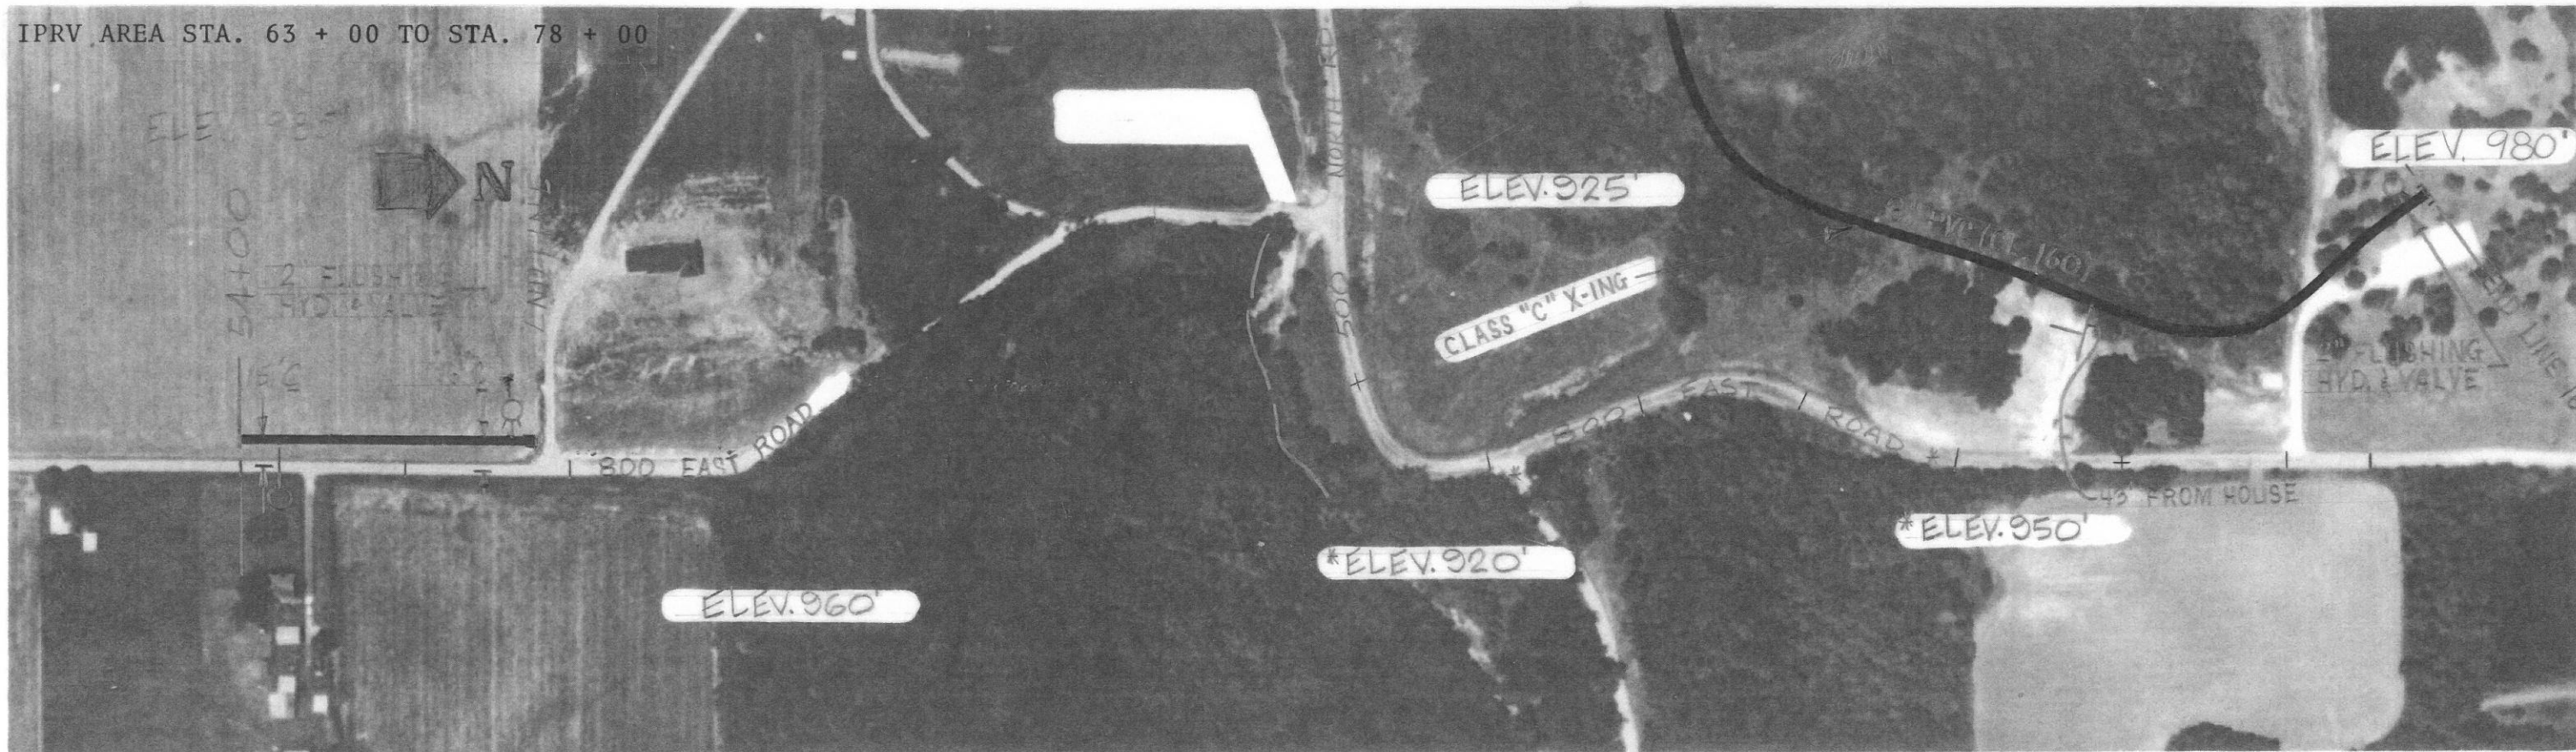

DRAWN BY	WDJ	CHECKED BY	David J. H.	SIECO, INC. CONSULTING ENGINEERS ARCHITECTS, PLANNERS	ELROD WATER CO, INC.	DIVISION	LINE 151	JOB NO.	61140	SHEET	33
DATE	7-26-79	DATE	1-31-80					SCALE	1"=200'	OF	89
		CERTIFIED BY									