
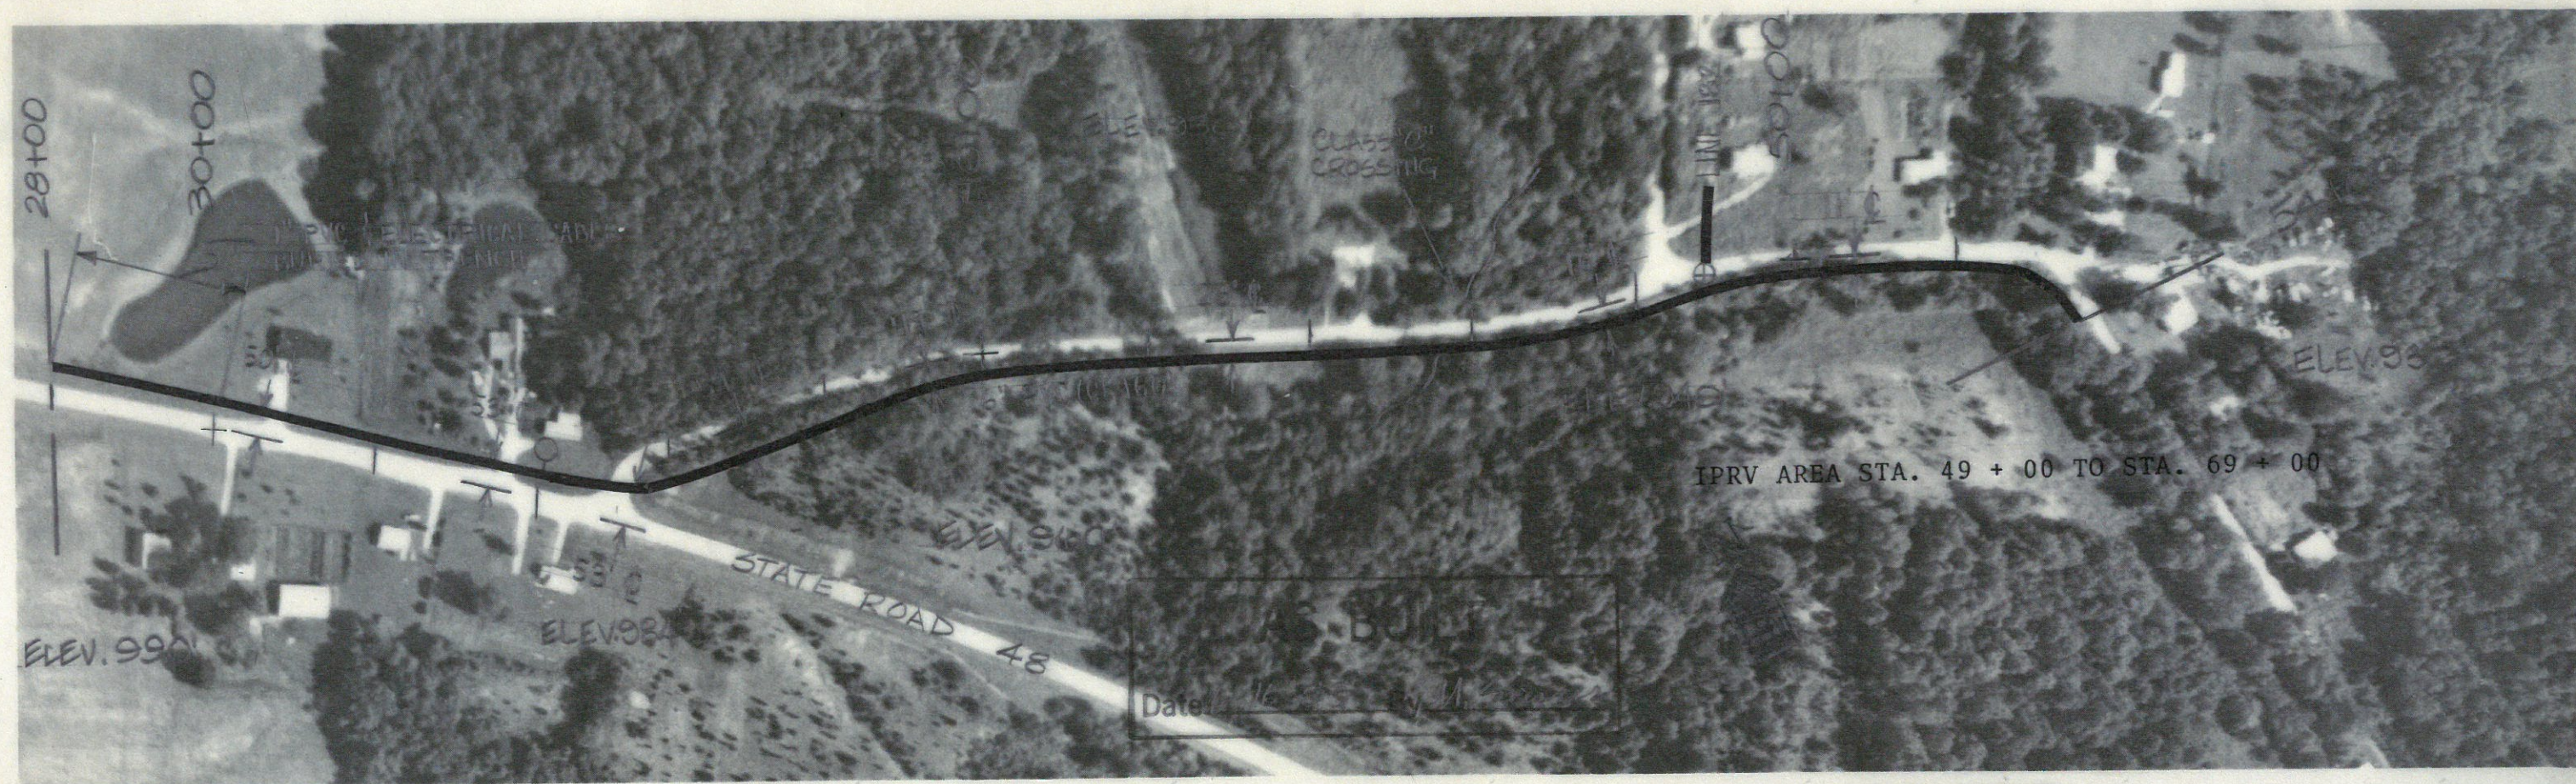


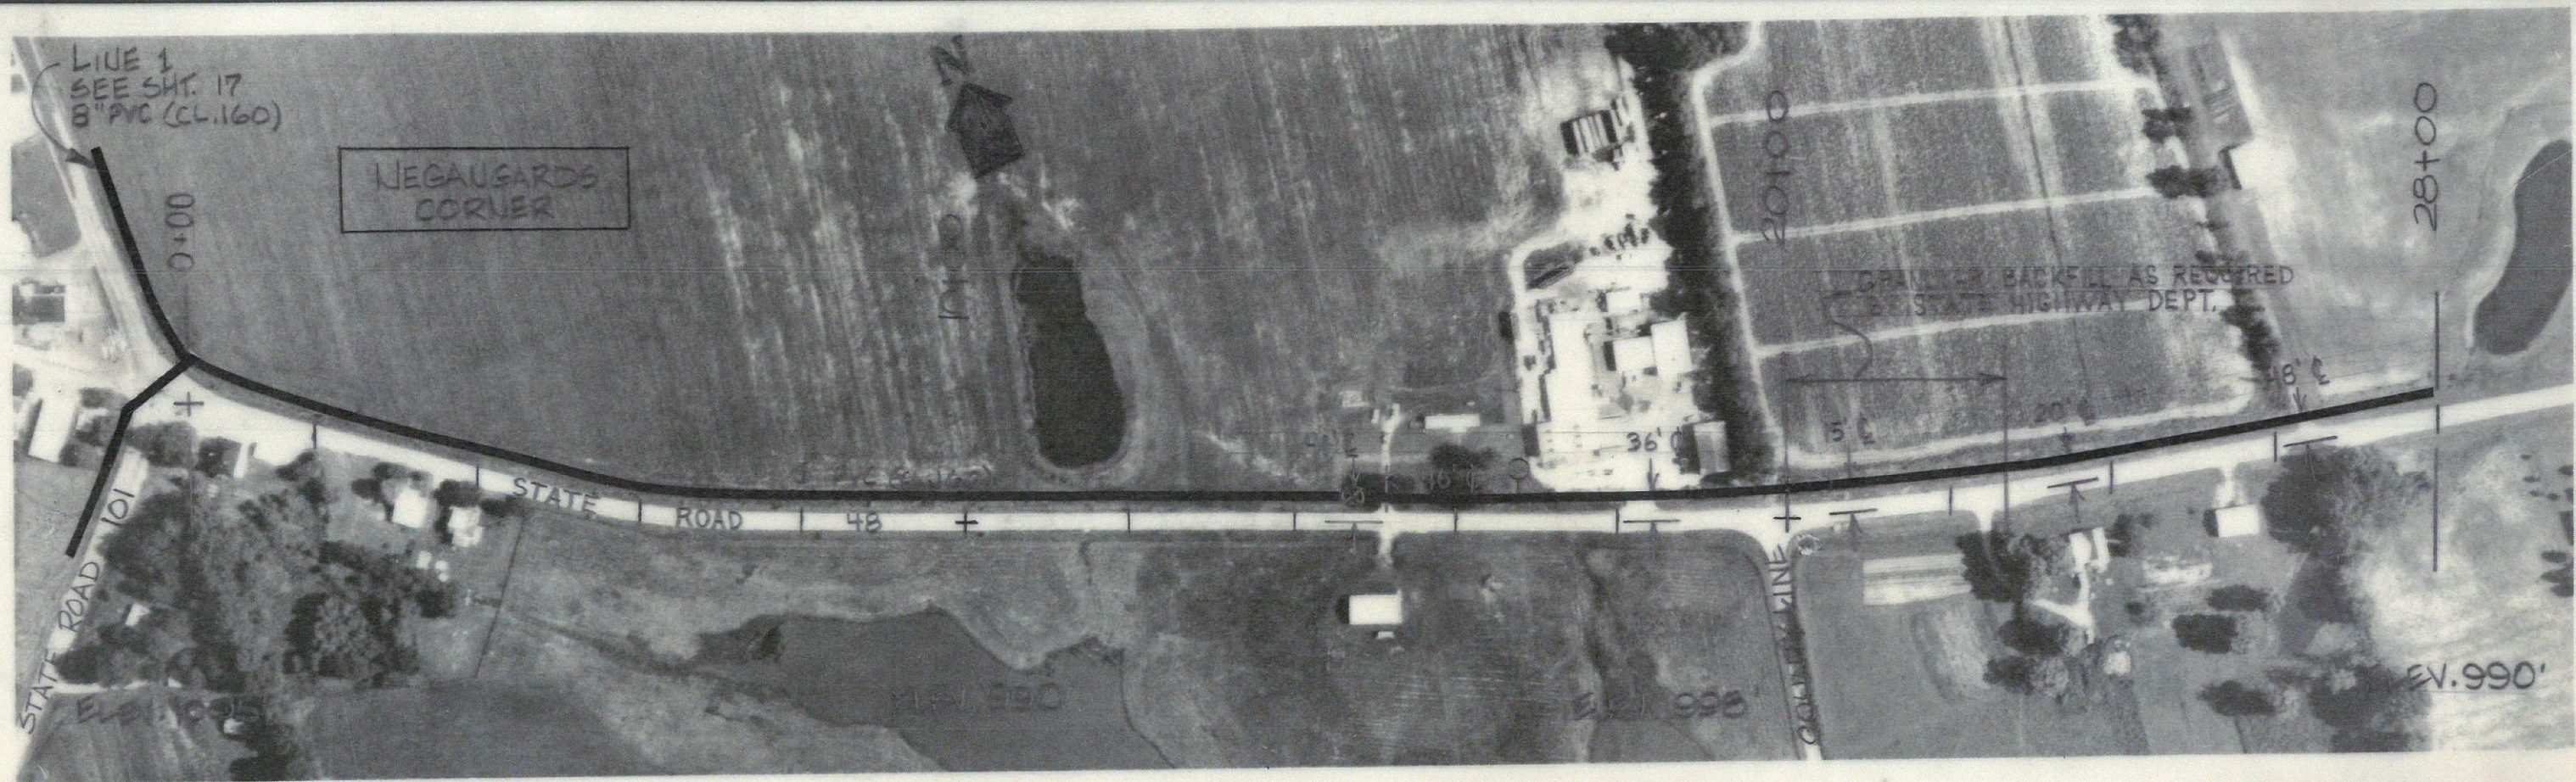

DRAWN BY	WDG	CHECKED BY	David [Signature]	SIECO, INC. CONSULTING ENGINEERS, ARCHITECTS, PLANNERS	ELROD WATER CO, INC.	REVISED: C.O. A-1 DIVISION: LINE 18	JOB NO.	SHT.
DATE	8-1-70	DATE	1-21-80				61140	36
		CERTIFIED BY					SCALE:	OF
		DATE					1"=200'	89