
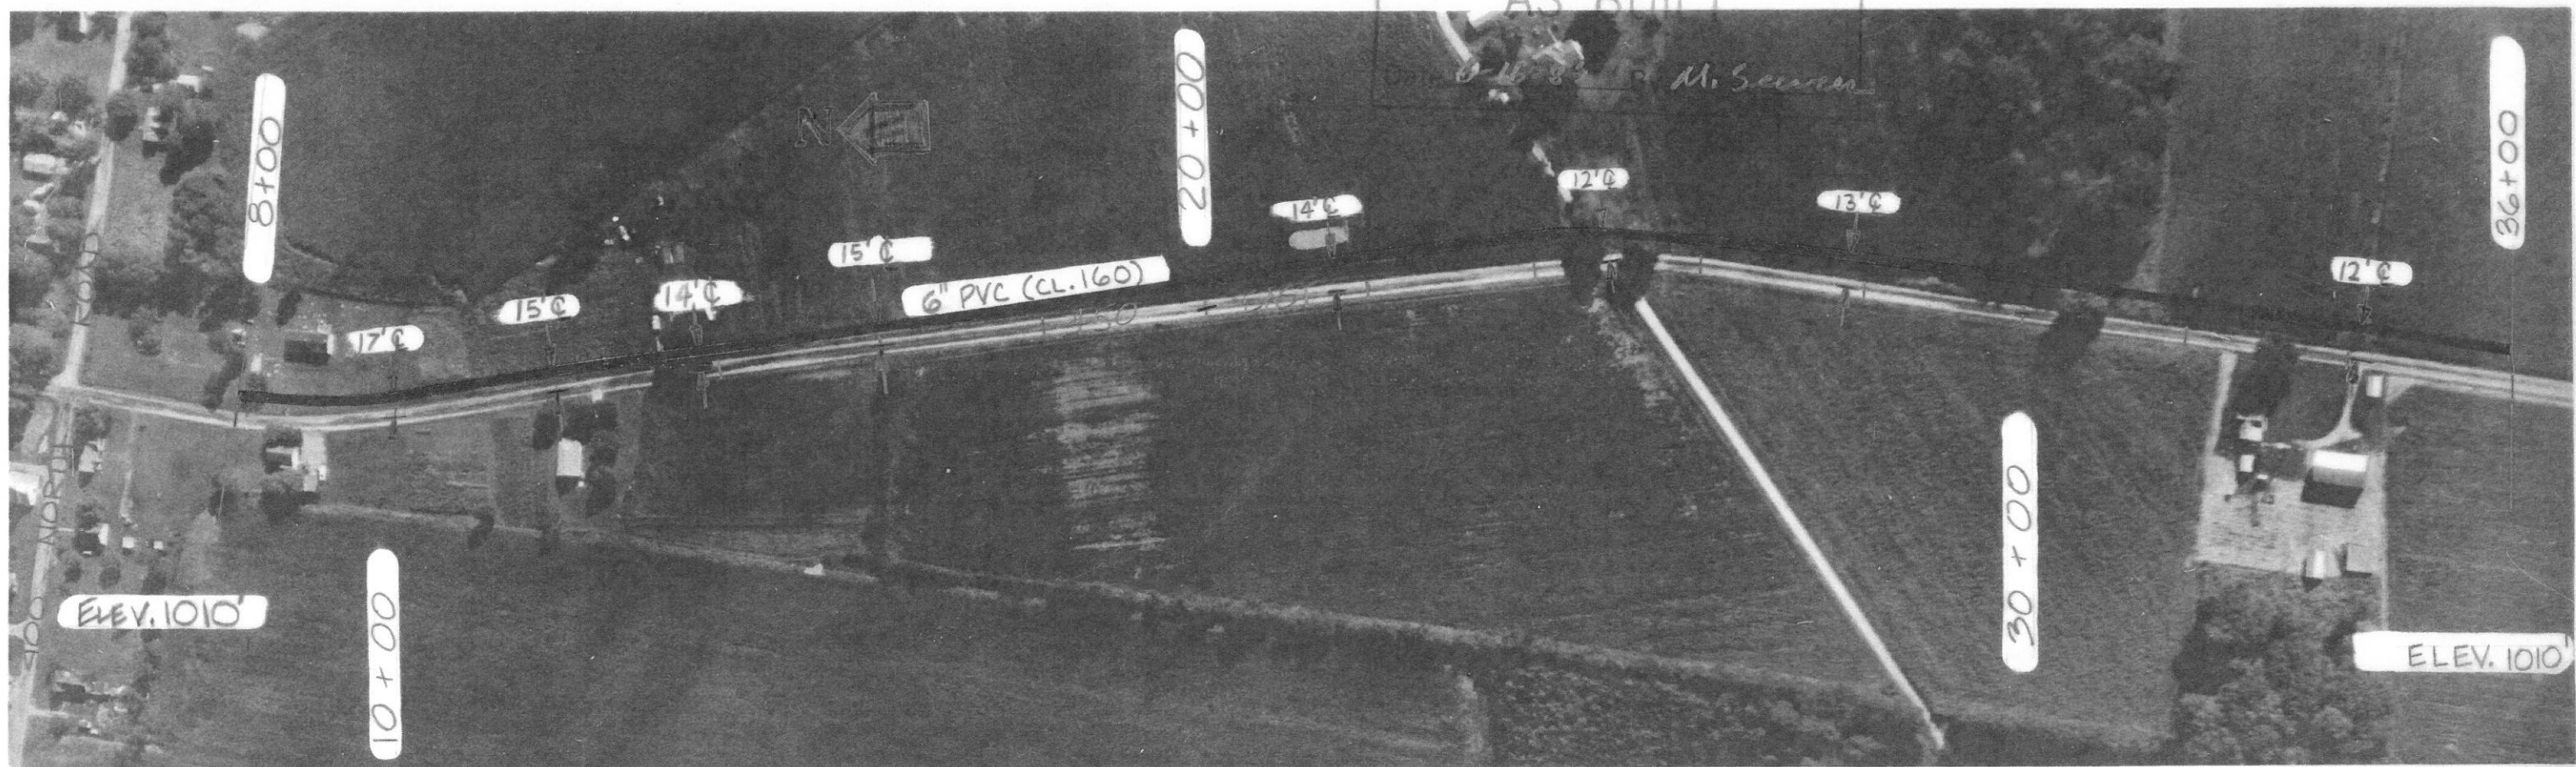


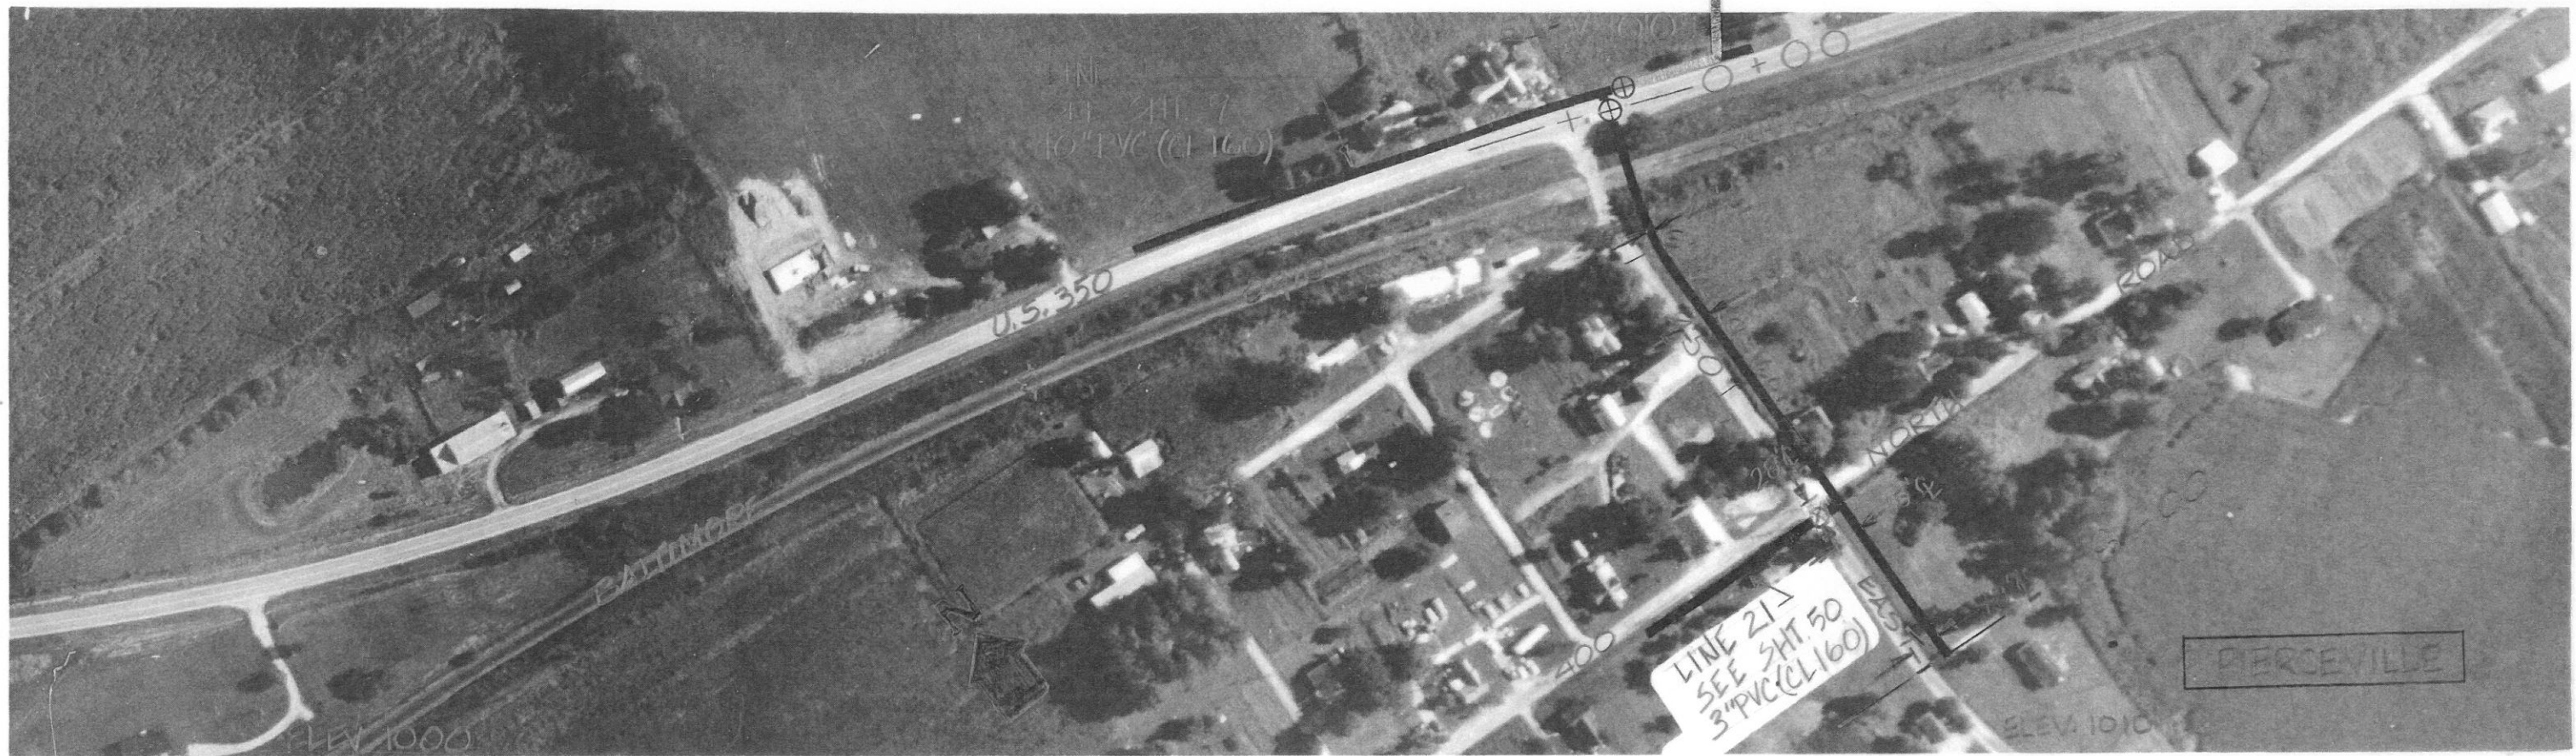

DRAWN BY	WDJ	CHECKED BY	David H. H.	SIECO, INC. CONSULTING ENGINEERS, ARCHITECTS, PLANNERS	ELROD WATER CO, INC.	REVISED: C.O. A-1 DIVISION: LINE 2	JOB NO. 0140	SHT. 40
DATE	7.17.79	DATE	1.21.80				SCALE: 1"=200'	OF 89
		CERTIFIED BY						