


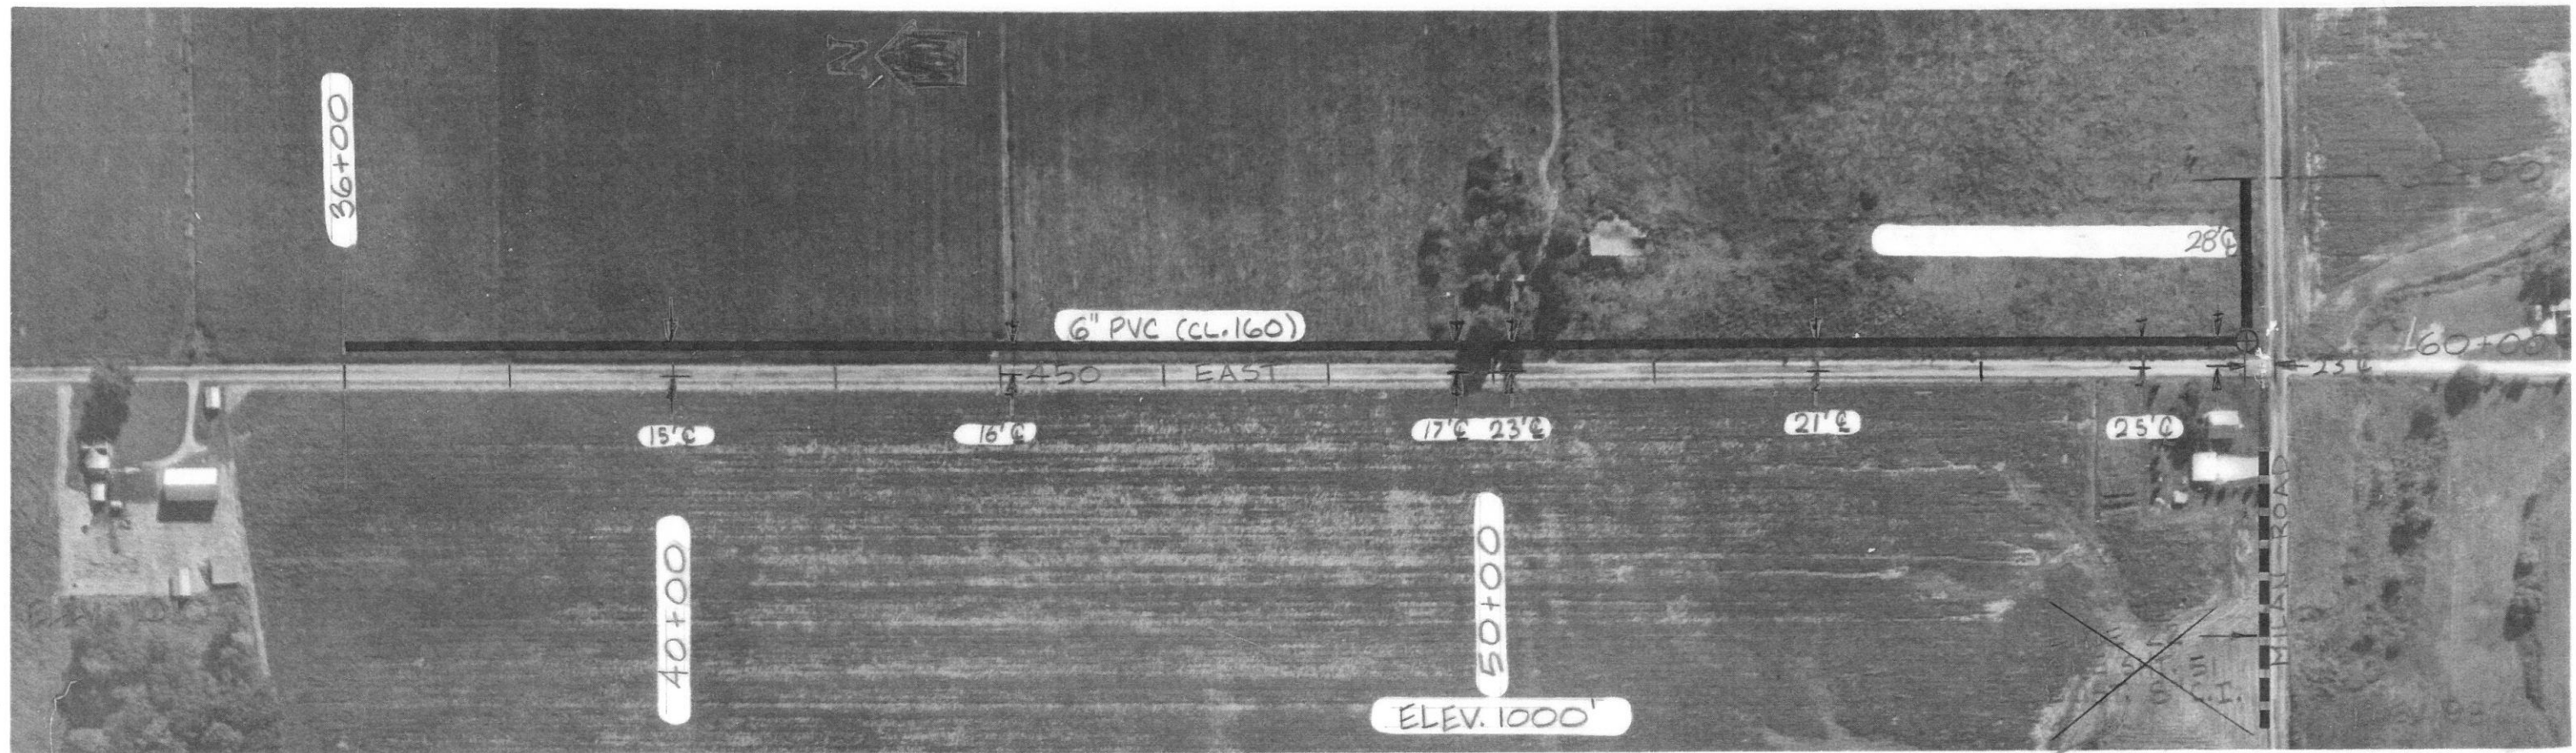

VOIDED BY C.O. A-1

AS BUILT
Date 6-16-83 By M. Sauer

DRAWN BY	WDJ	CHECKED BY	David WA
DATE	8-2-79	DATE	1-21-80
		CERTIFIED BY	
		DATE	

SIECO, INC.
CONSULTING ENGINEERS,
ARCHITECTS, PLANNERS

ELROD WATER CO, INC.

REVISED: C.O. A-1
DIVISION: LINE 2

JOB NO.	61140	SHT.	41
SCALE:	1"=200'	OF	89