


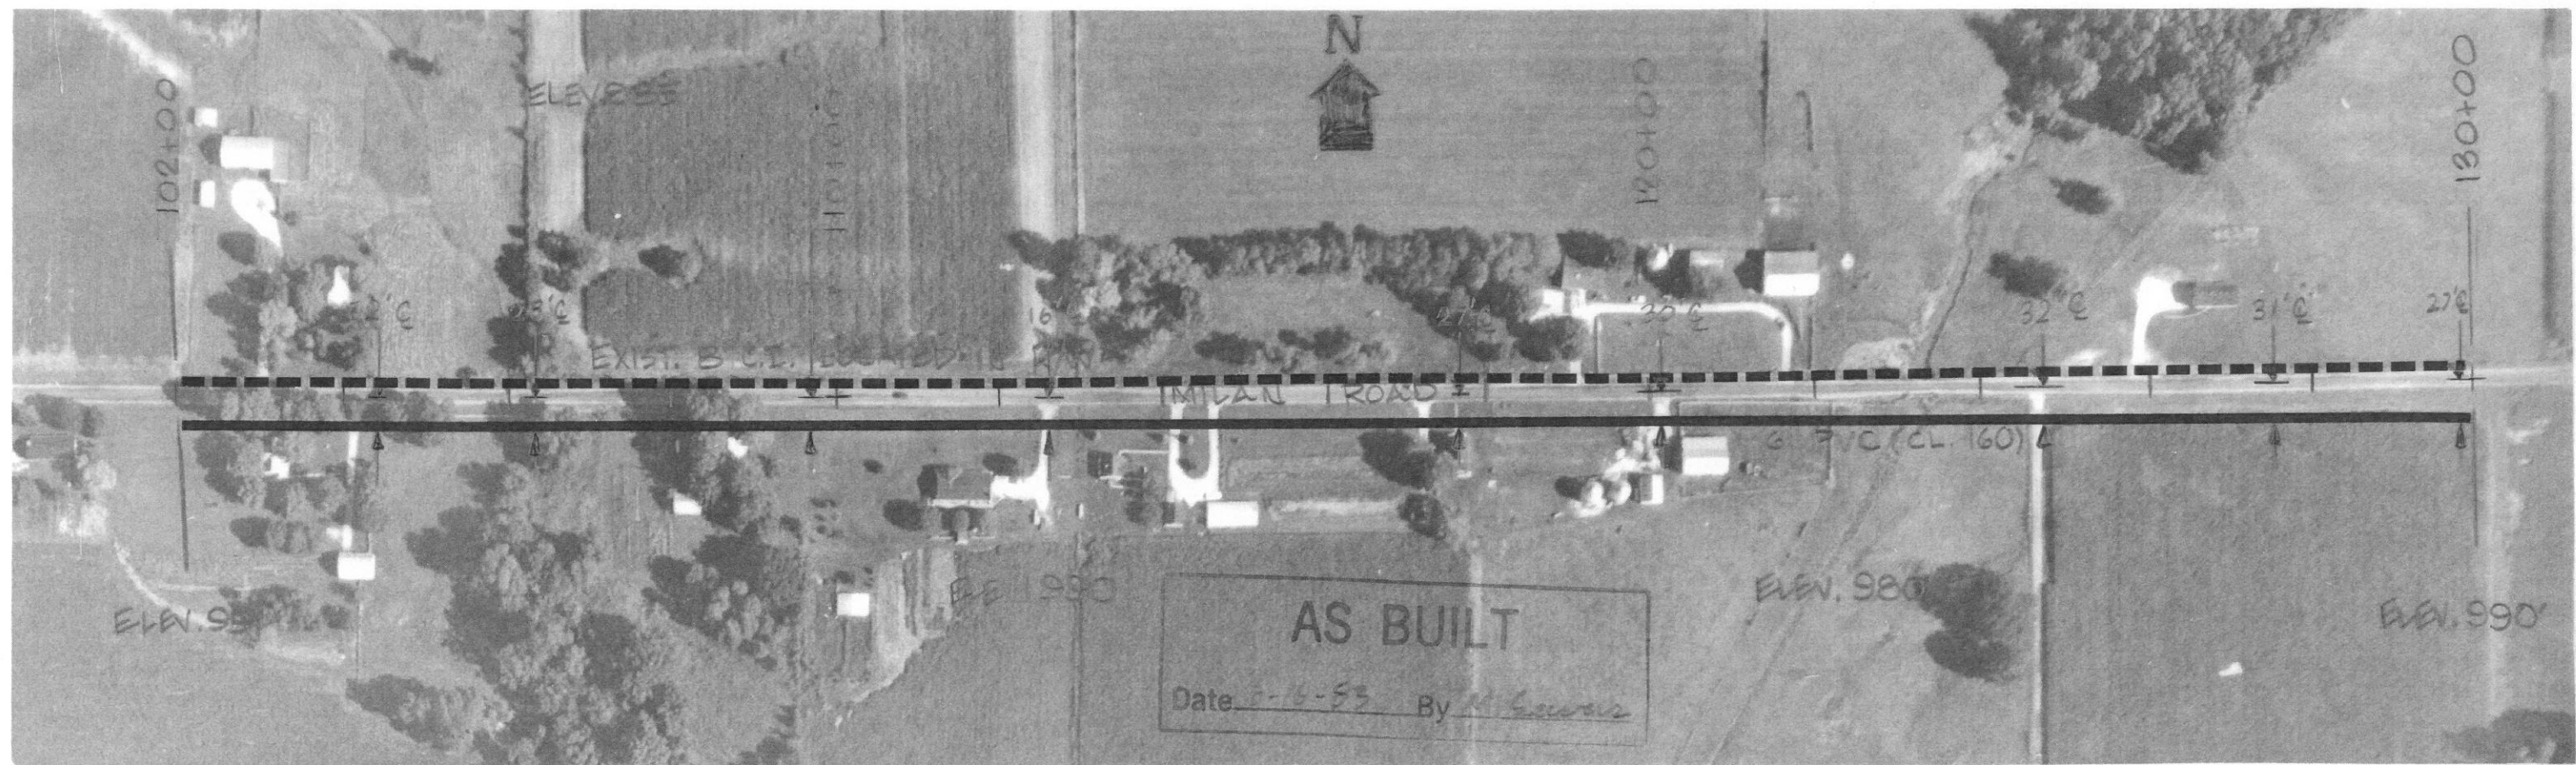

DRAWN BY	WDD	CHECKED BY	David M. ...
DATE	8.3.78	DATE	1.21.80
		CERTIFIED BY	
		DATE	

SIECO, INC.
CONSULTING ENGINEERS,
ARCHITECTS, PLANNERS

ELROD WATER CO, INC.

REVISED: C.O. A-1
DIVISION: LINE 2

JOB NO.	61140	SHT.	43
SCALE	1"=200'	OF	89