


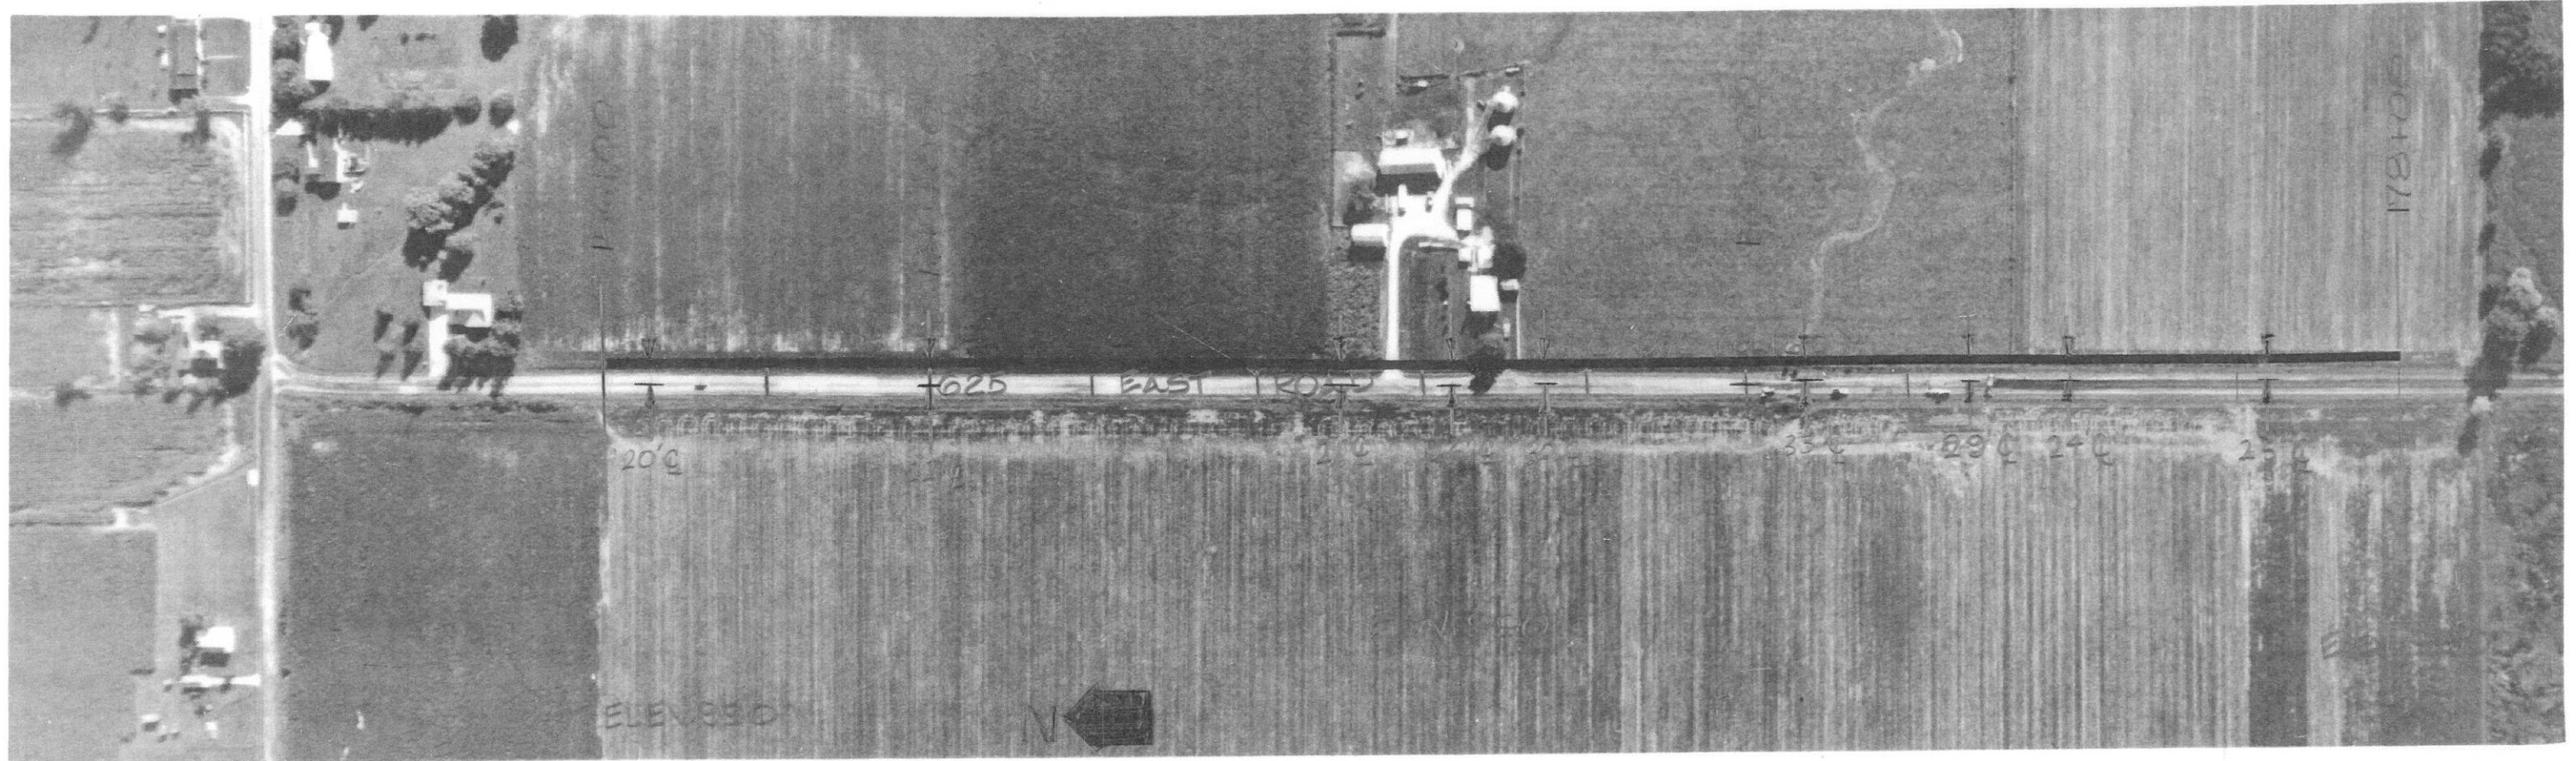

AS BUILT
Date 11/1/80 By M.G.

DRAWN BY	W.D.	CHECKED BY	<i>[Signature]</i>
DATE	8.6.79	DATE	1.31.80
		CERTIFIED BY	
		DATE	

SIECO, INC.
CONSULTING ENGINEERS,
ARCHITECTS, PLANNERS

ELROD WATER CO, INC.

DIVISION: LINE 2

JOB NO.	61140	SHT.	45
SCALE	1"=200'	OF	89