
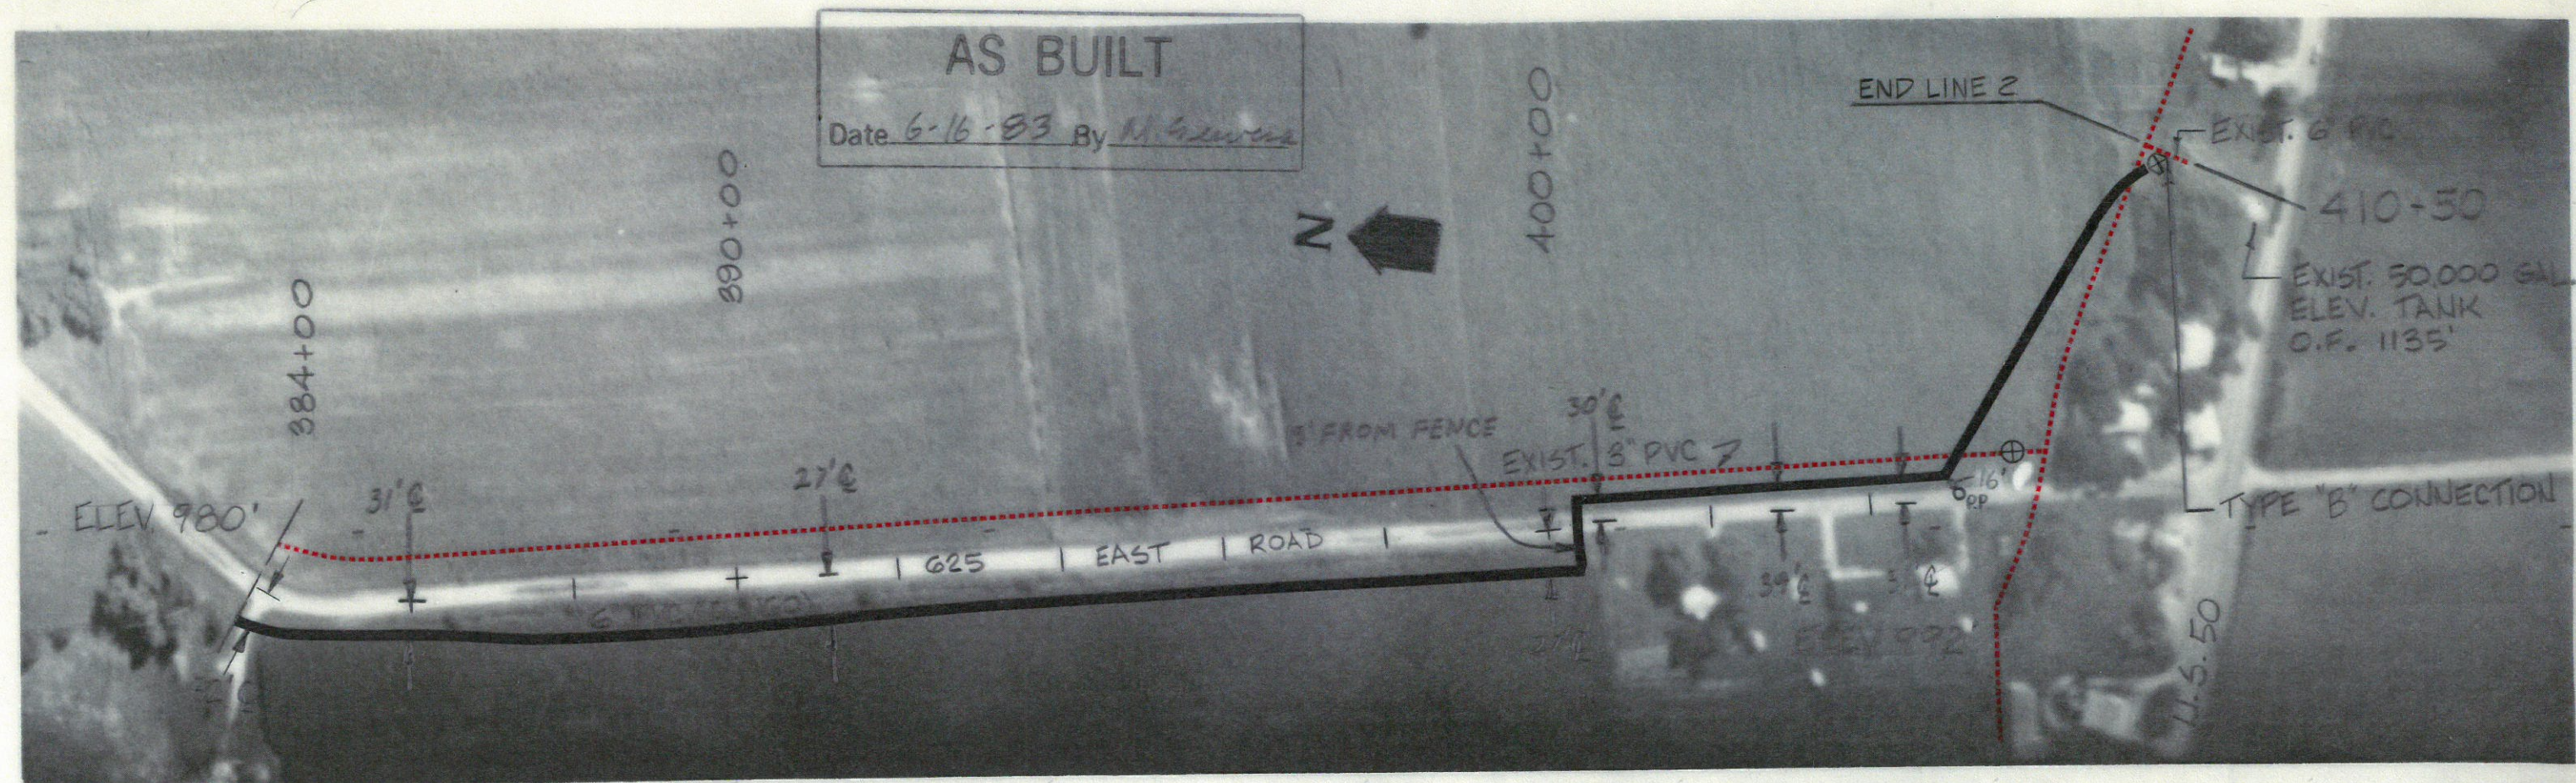


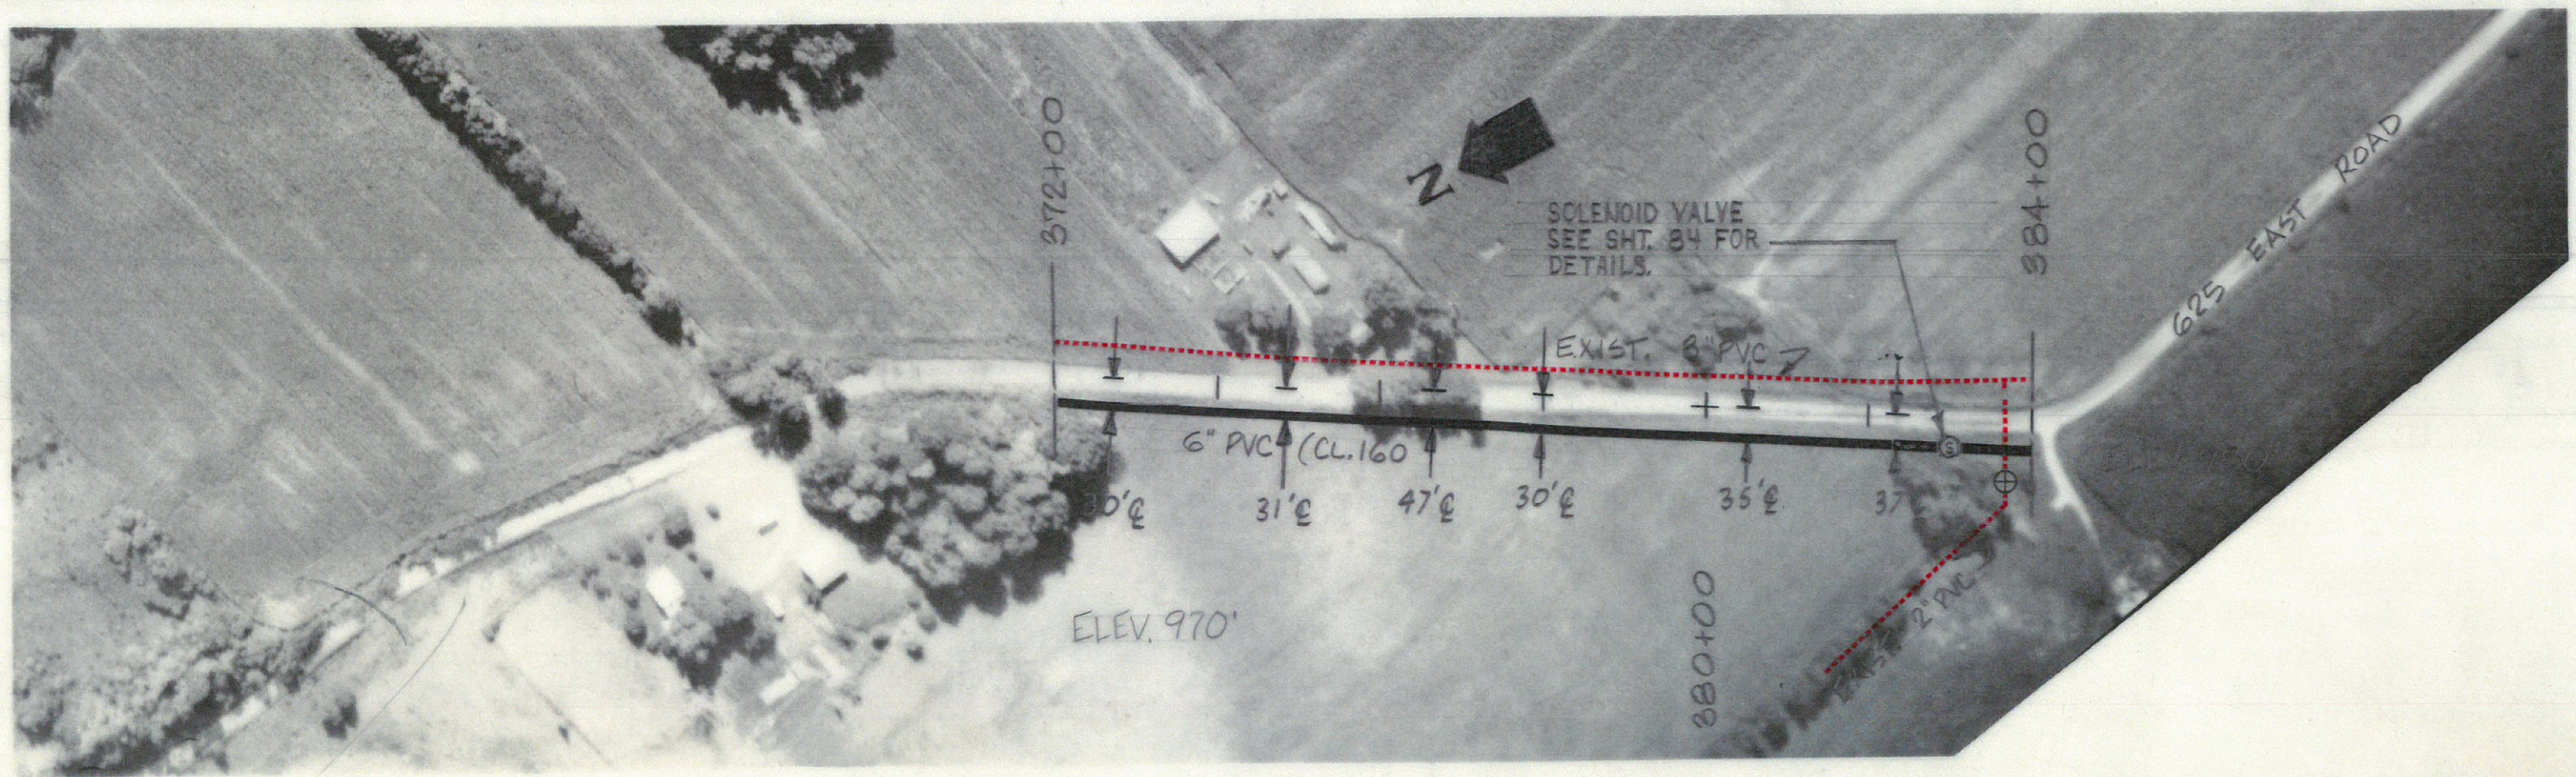

DRAWN BY WDD 8-7-79	CHECKED BY DATE CERTIFIED BY DATE	SIECO, INC. CONSULTING ENGINEERS, ARCHITECTS, PLANNERS	ELROD WATER CO, INC.	REVISED: C.O. A-1 DIVISION: LINE 2	JOB NO. 61140 SCALE: 1"=200' SHT. 49 OF 89
---------------------------	--	--	----------------------	---------------------------------------	--