


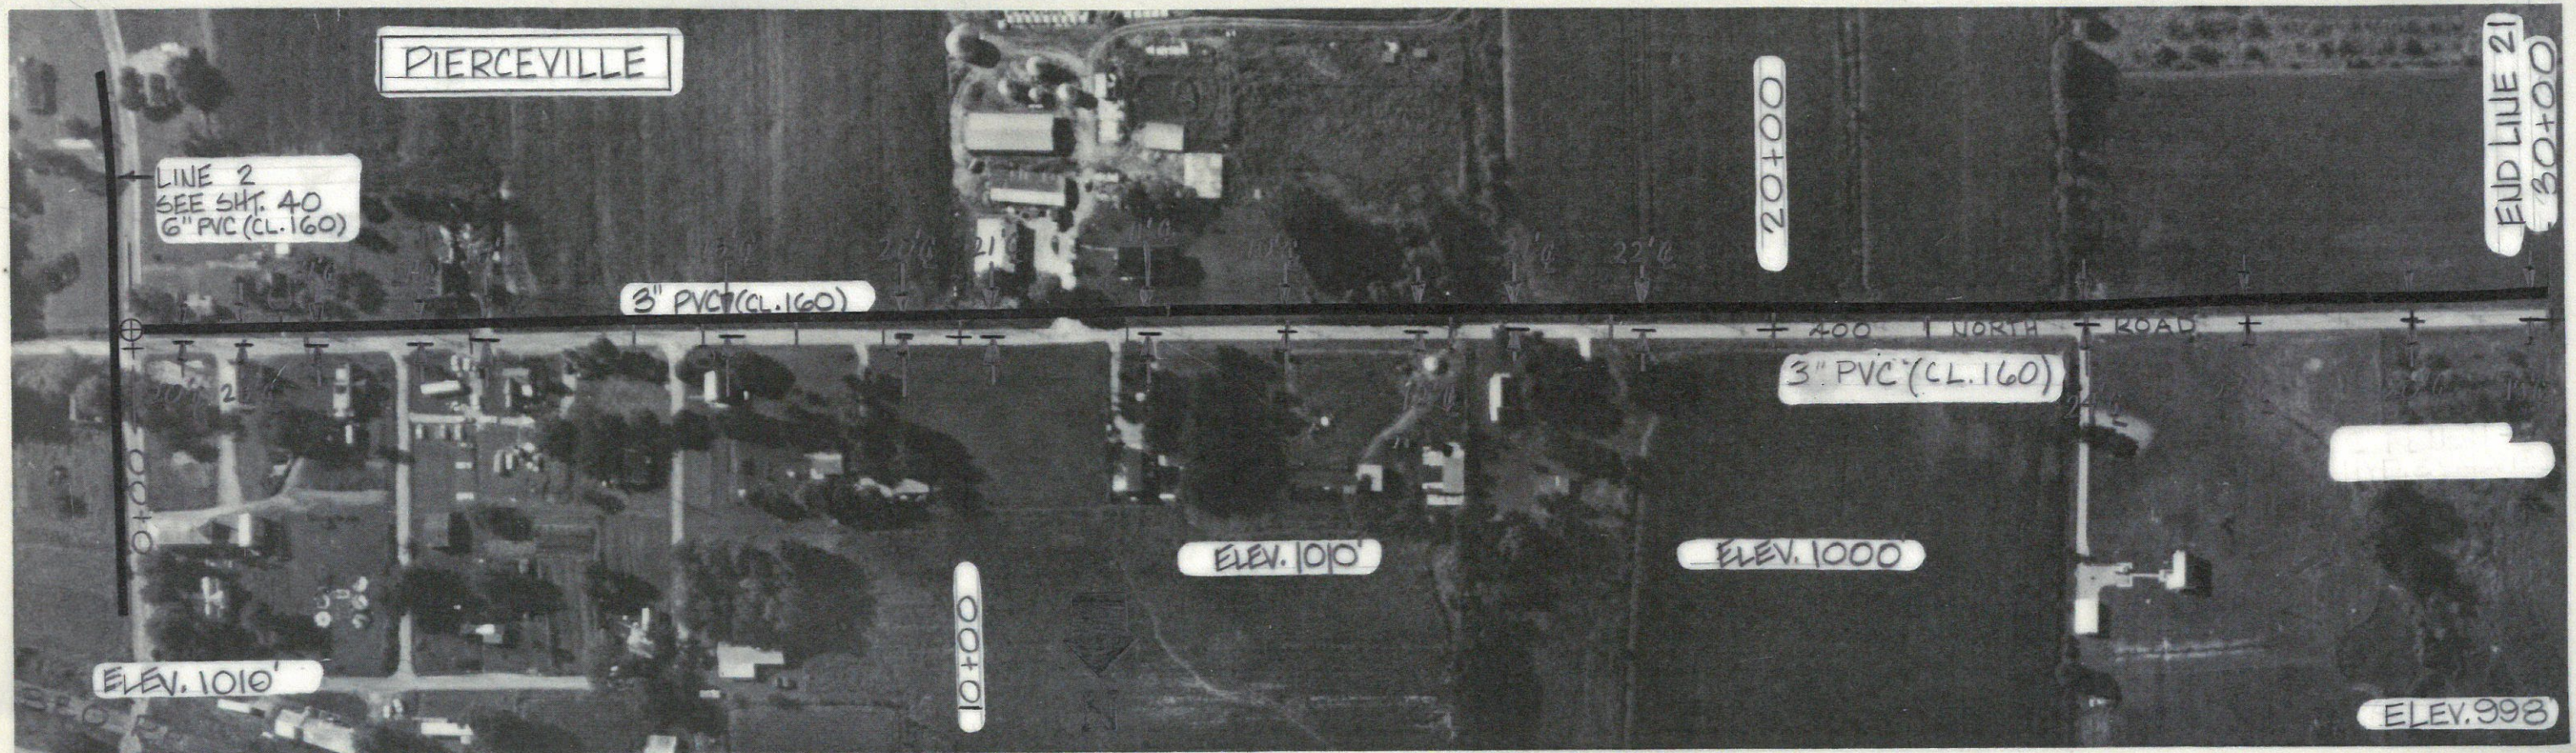

AS BUILT
 Date 6-16-83 By M. Sauer

DRAWN BY	W.D.J.	CHECKED BY	David H. H.	SIECO, INC. CONSULTING ENGINEERS, ARCHITECTS, PLANNERS	ELROD WATER CO, INC.	REVISED: C.O. A-1 DIVISION: LINE 21	JOB NO. 61140 SCALE: 1"=200'	SHT. 50 OF 89
DATE	8-8-79	DATE	1-21-80					
		CERTIFIED BY						
		DATE						