



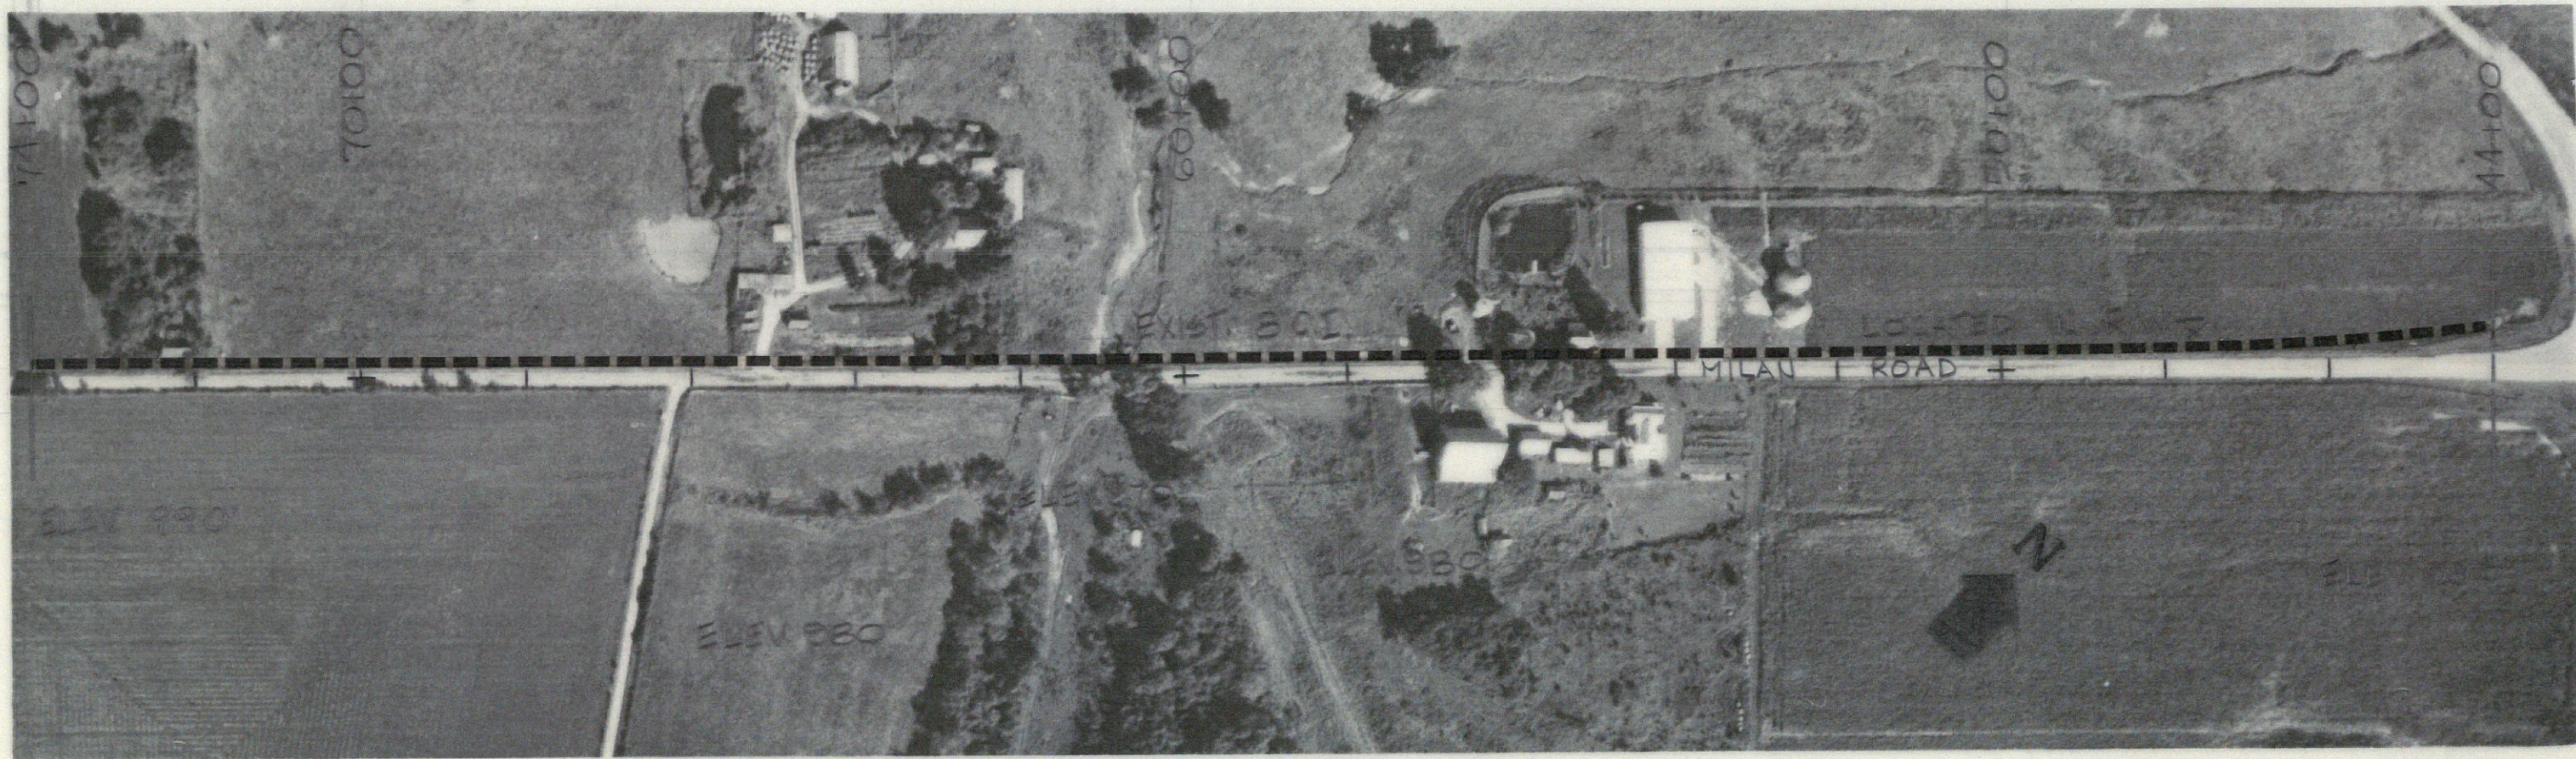

VOIDED BY CHANGE ORDER A-1

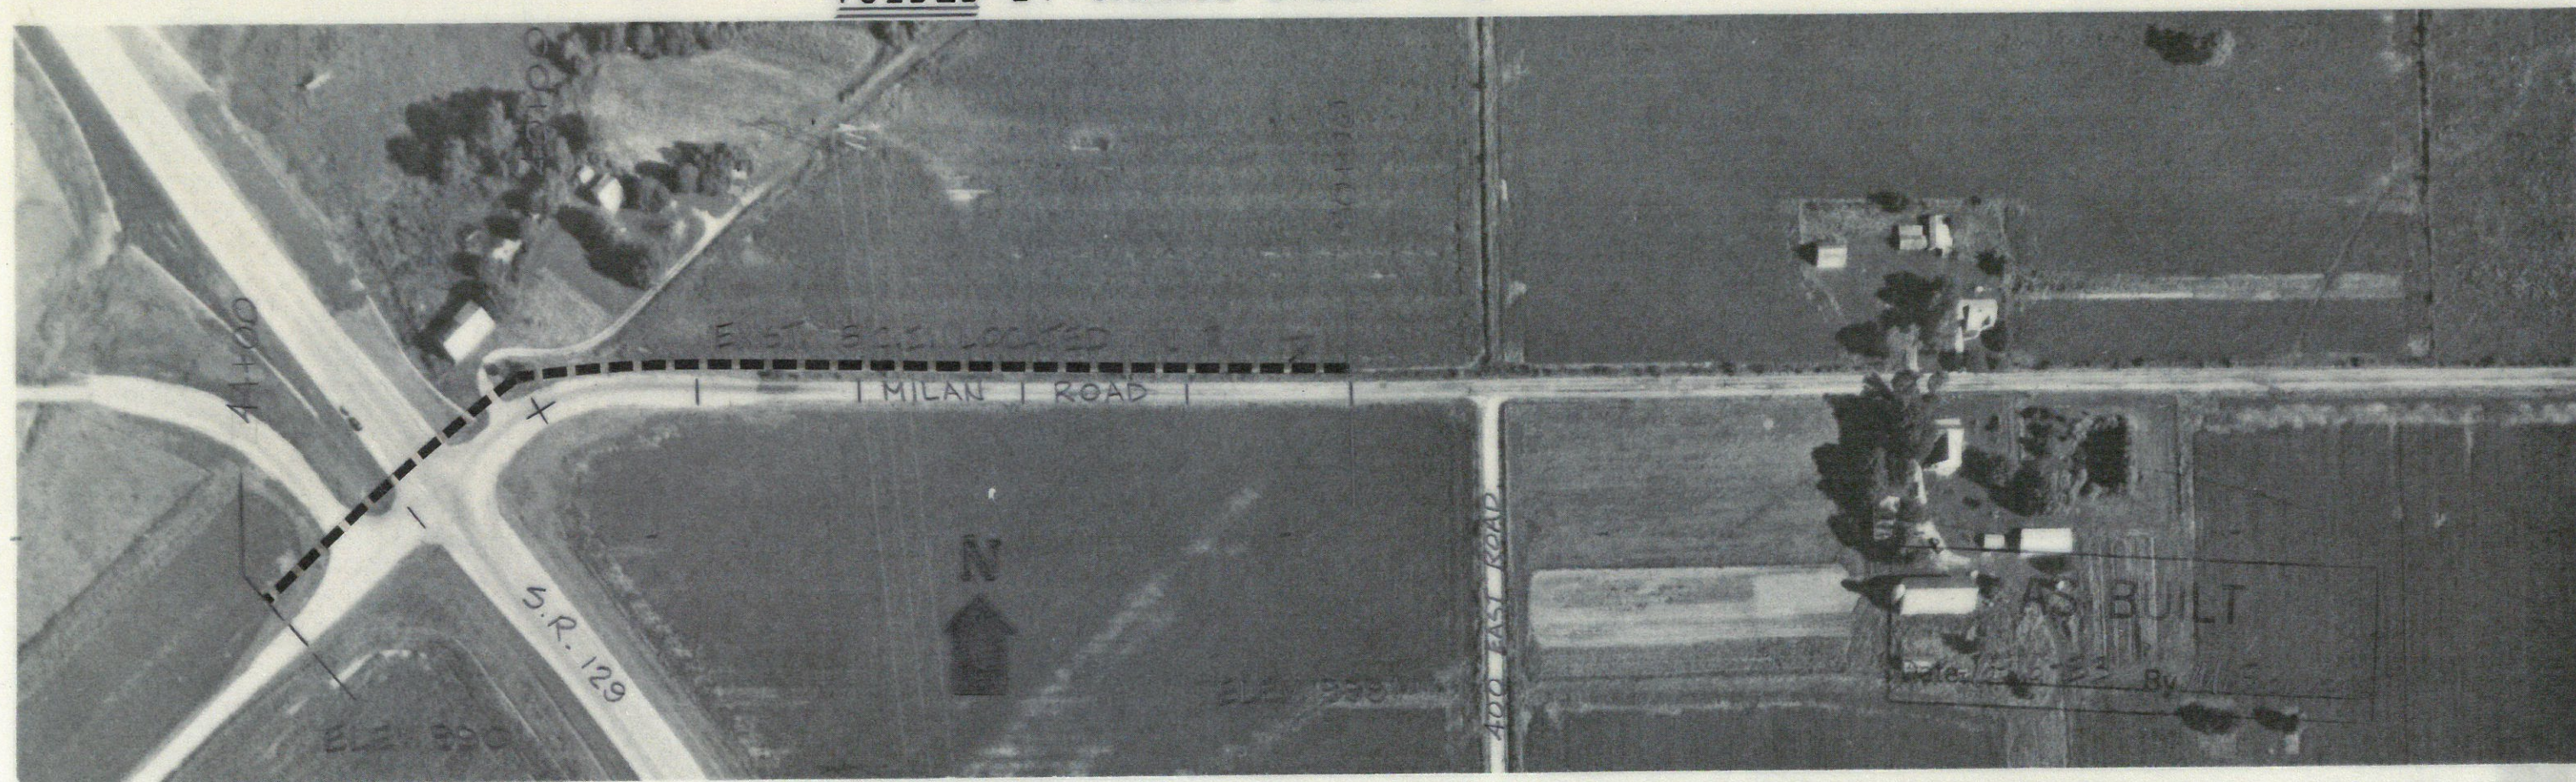

DRAWN BY DATE	W.D.J. 8-8-79	CHECKED BY DATE	[Signature] 1-21-80	SIECO, INC. CONSULTING ENGINEERS ARCHITECTS, PLANNERS	ELROD WATER CO., INC.	REVISED: C.O. A-1 DIVISION: 221/ANNY	JOB NO. 61140	SHT. 52
		CERTIFIED BY DATE					SCALE: 1"=200'	OF 89