



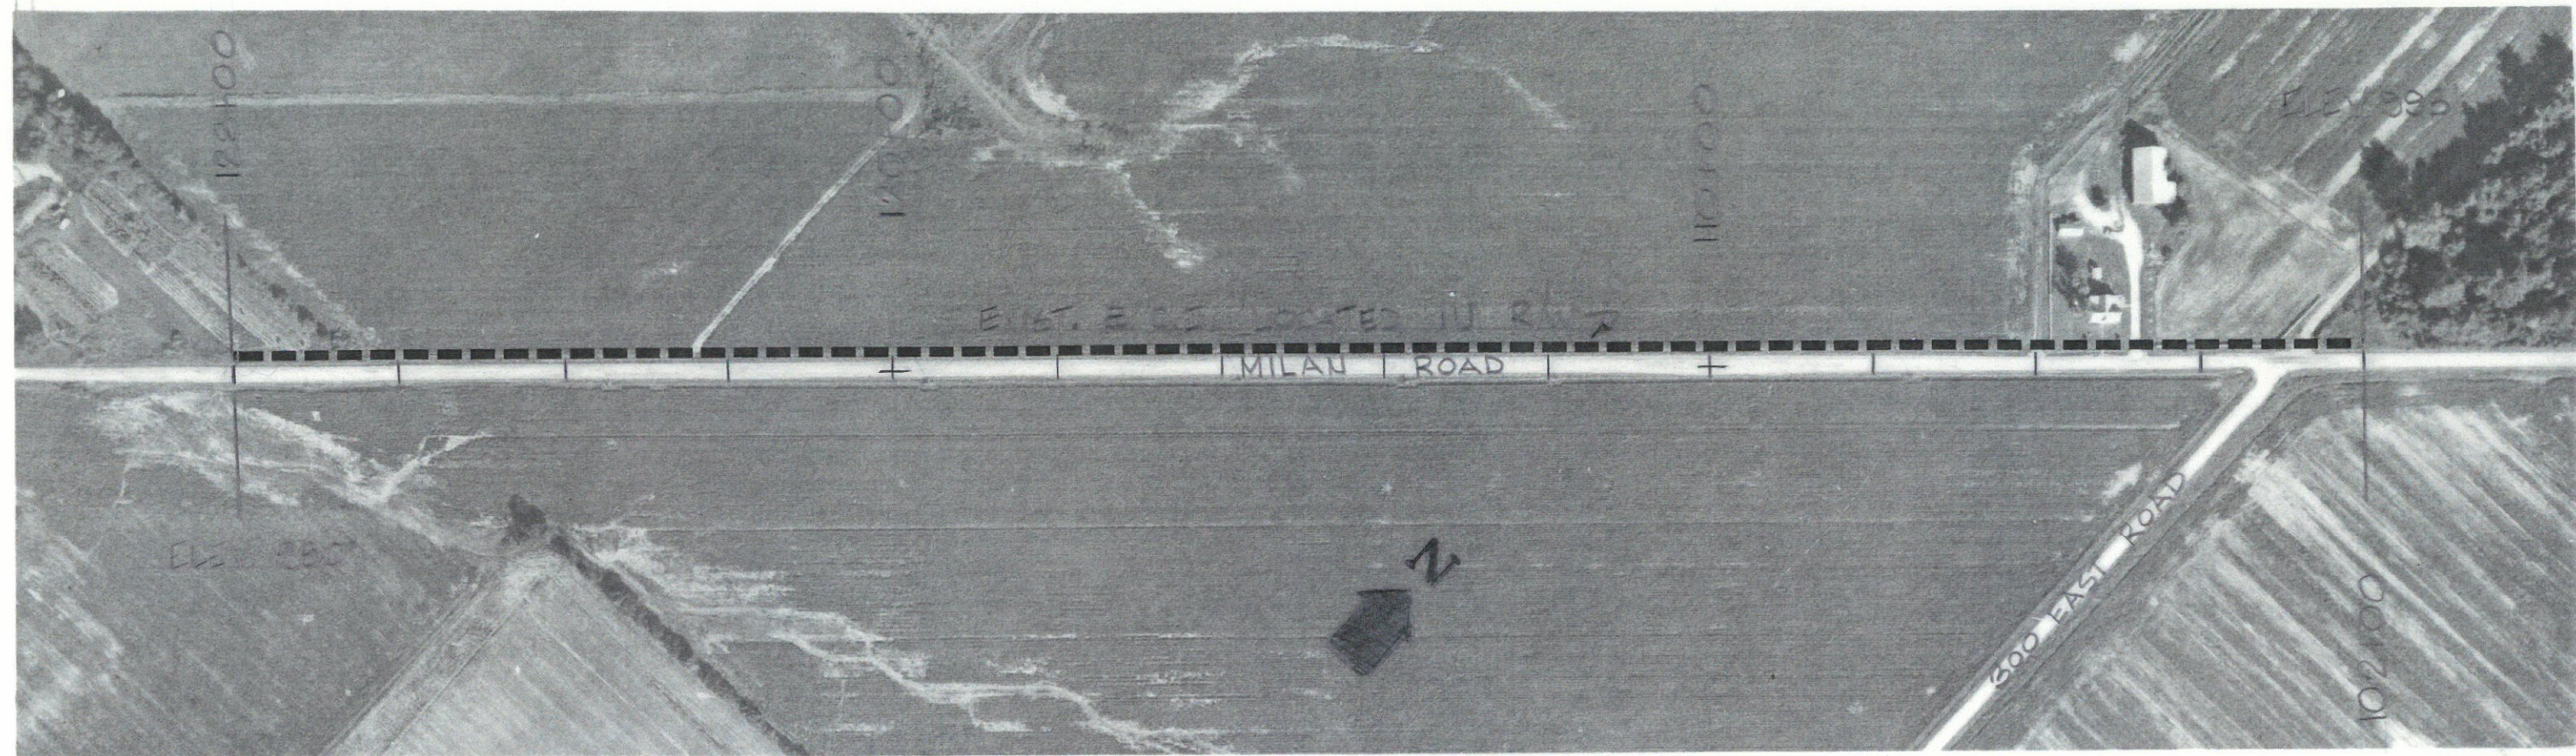

VOIDED BY CHANGE ORDER A-1

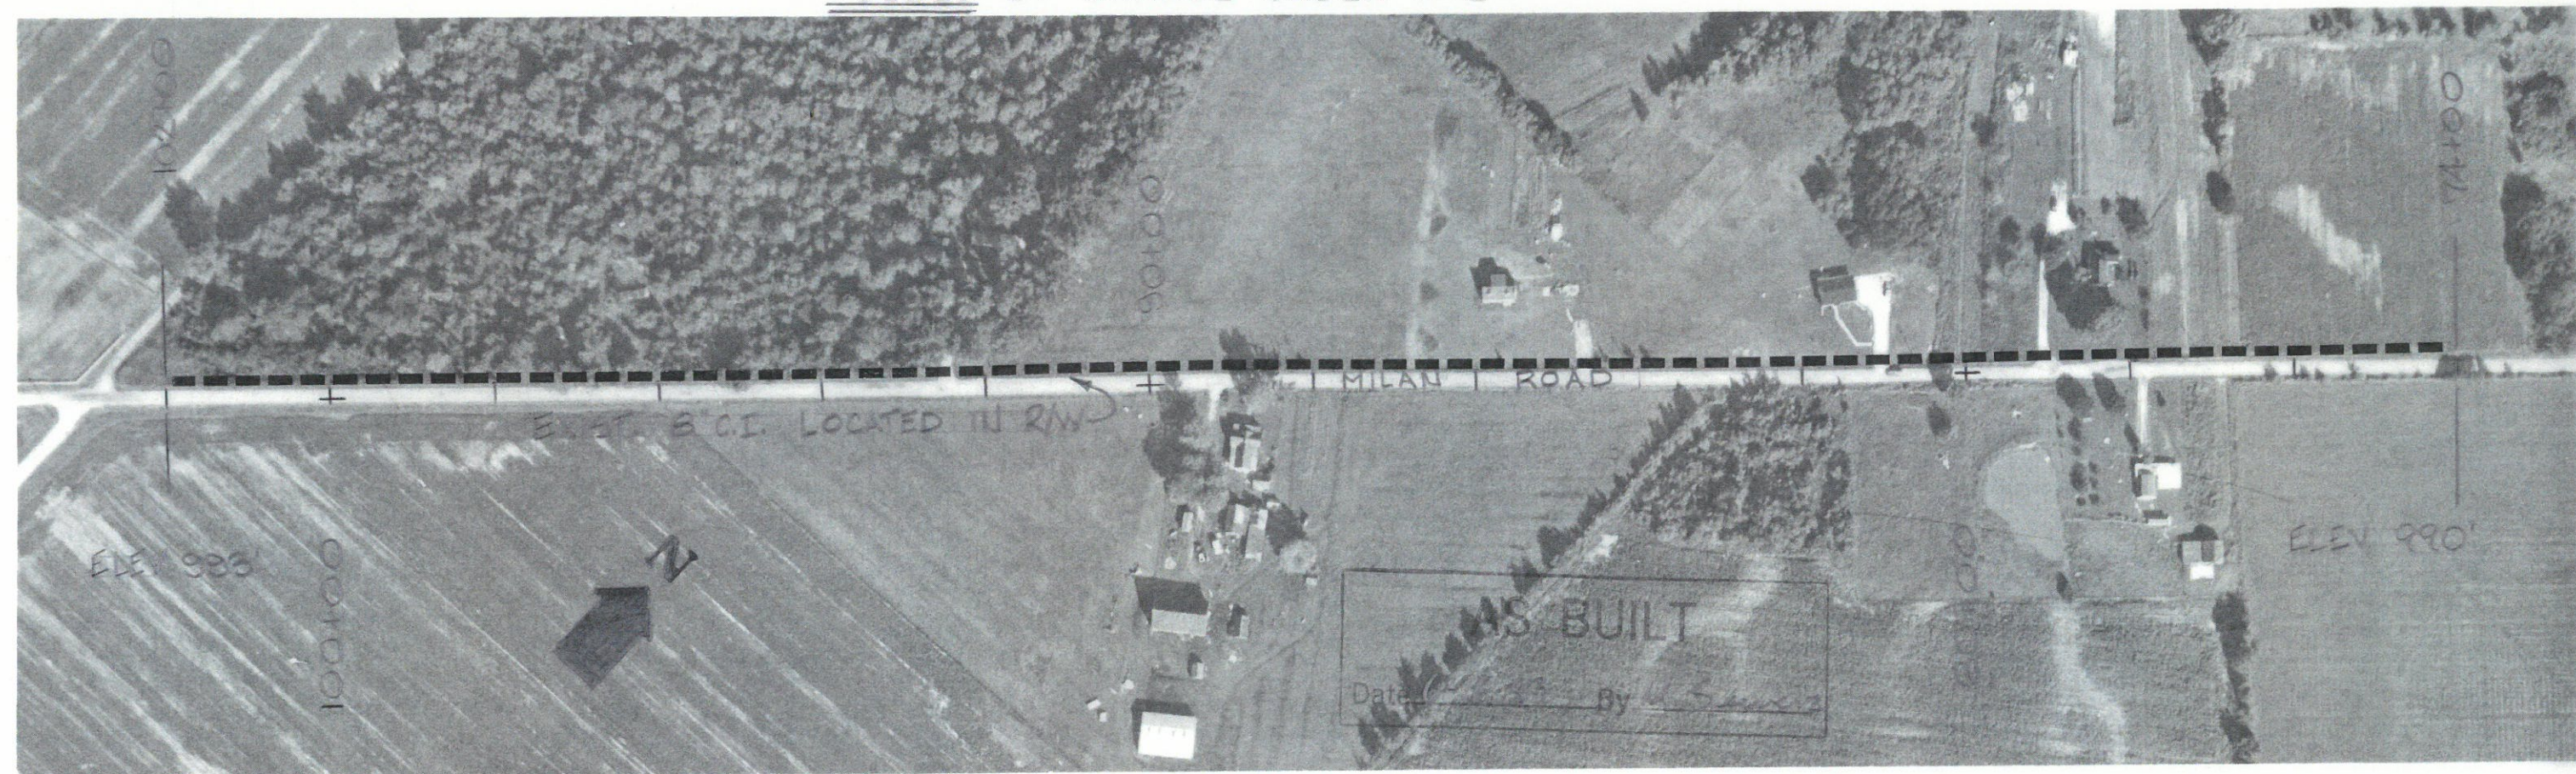

DRAWN BY	WDD	CHECKED BY	[Signature]
DATE	8.9.79	DATE	1.21.80
		CERTIFIED BY	
		DATE	

SIECO, INC.
CONSULTING ENGINEERS
ARCHITECTS, PLANNERS

ELROD WATER CO, INC.

REVISED: C.O. A-1

DIVISION: LAKE/127

JOB No.	61140	SHT.	53
SCALE:	1"=200'	OF	89