



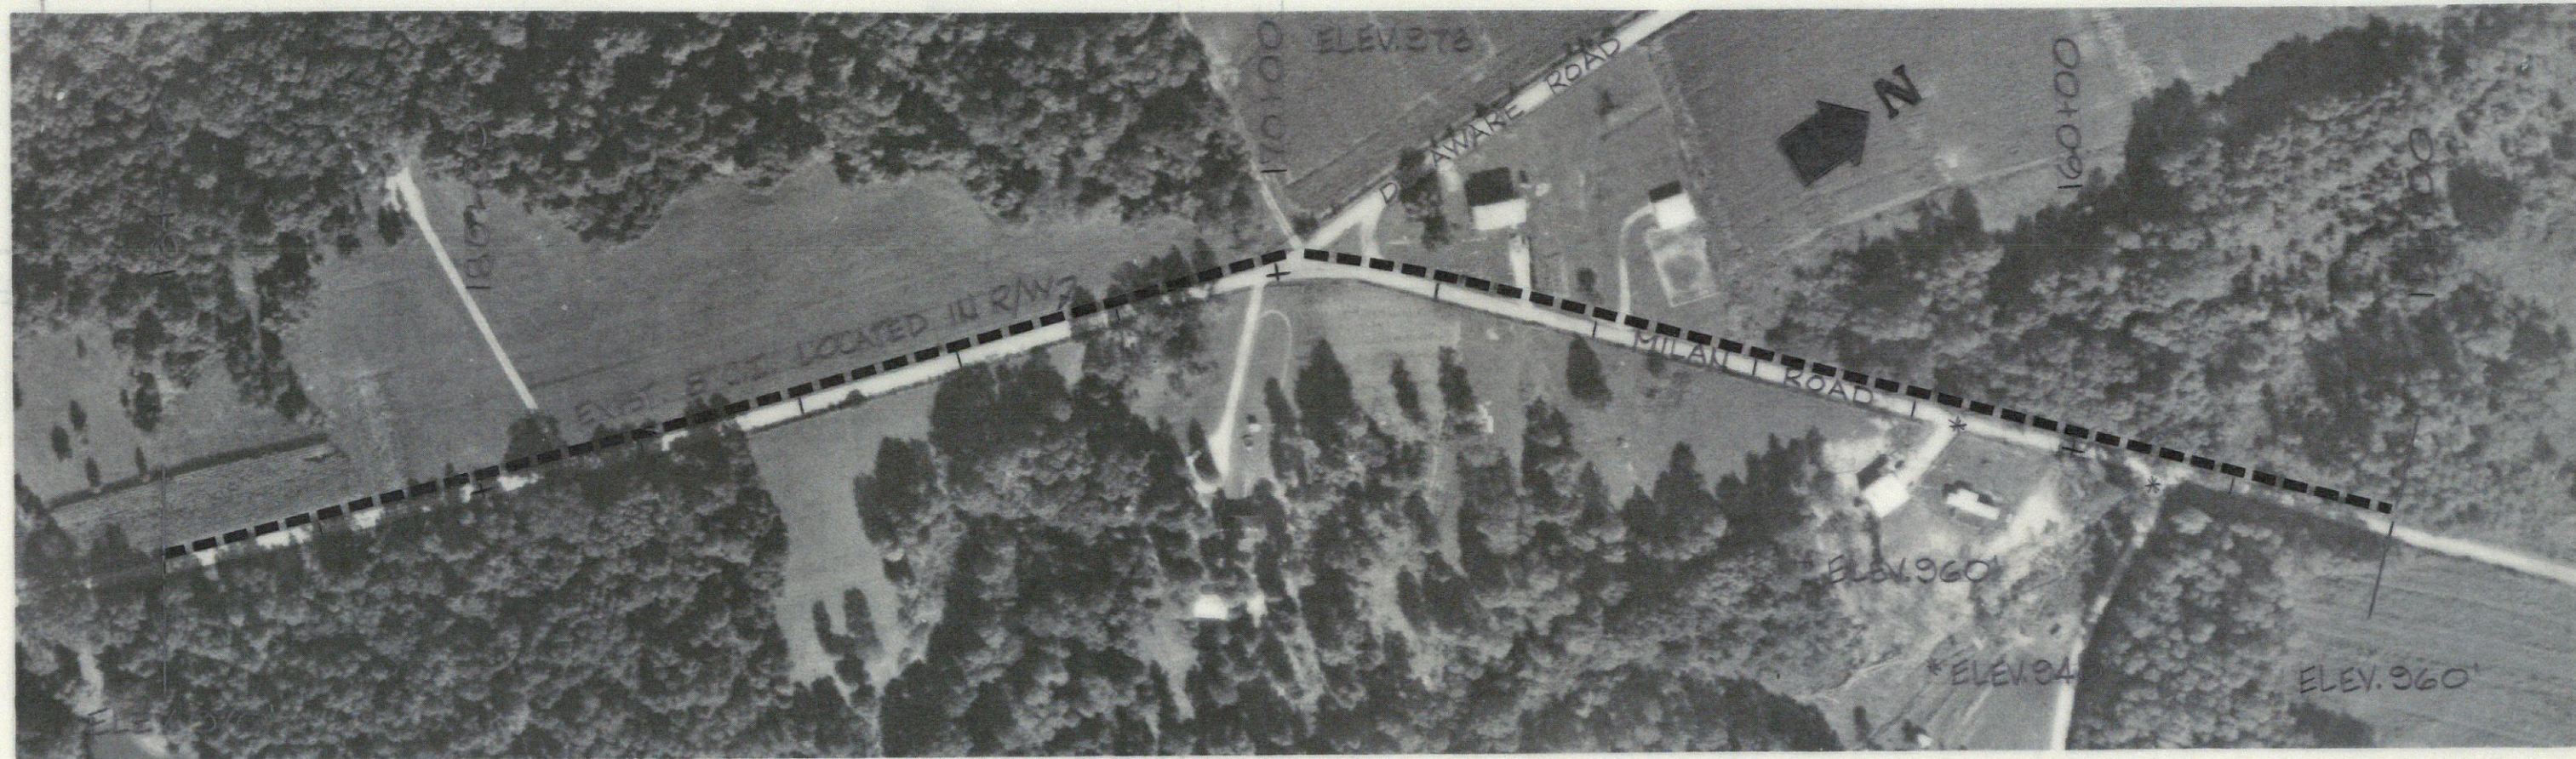

VOIDED BY CHANGE ORDER A-1

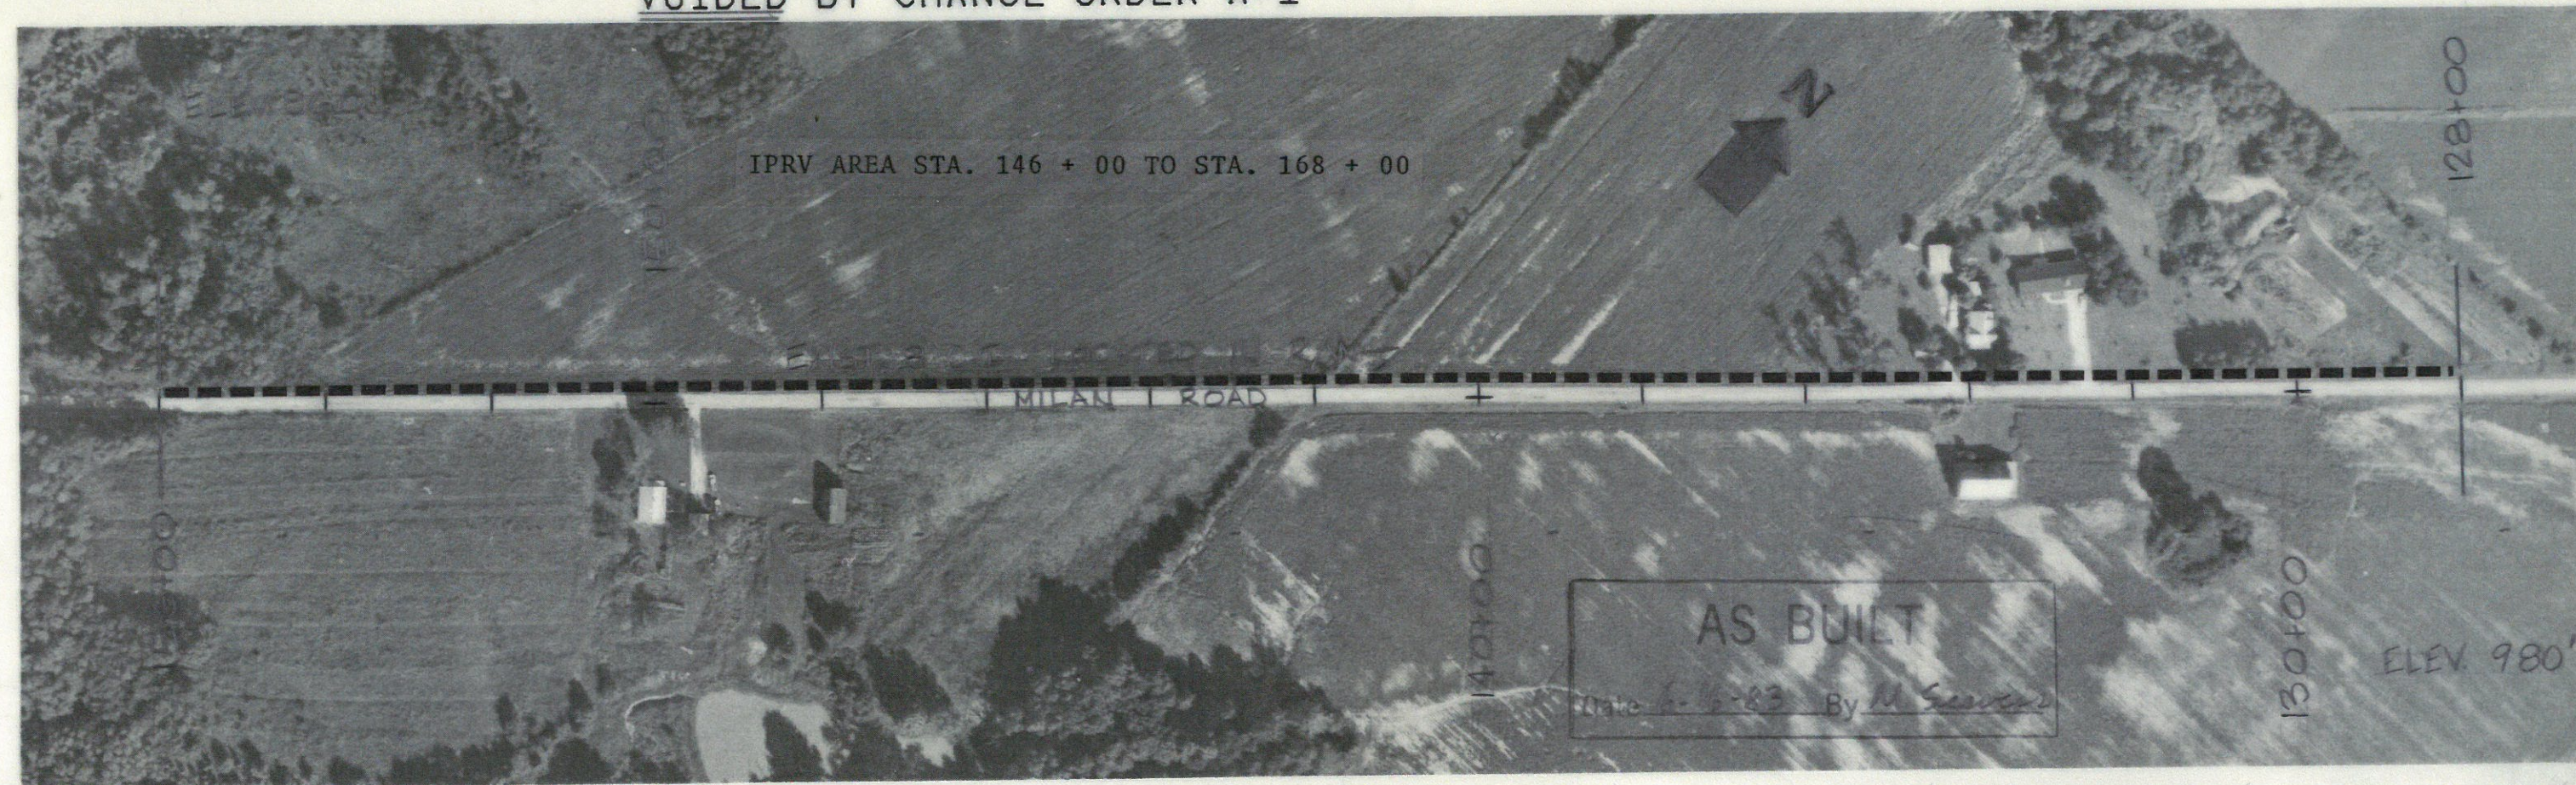

DRAWN BY	W.D.J.	CHECKED BY	<i>[Signature]</i>	SIECO, INC. CONSULTING ENGINEERS ARCHITECTS. PLANNERS	ELROD WATER CO, INC.	REVISED: C.O. A-1	JOB NO.	SHT.	
DATE	8.9.79	DATE	1.21.80					61140	54
		CERTIFIED BY						SCALE: 1"=200'	OF
		DATE				DIVISION: LINE 1/2/4		89	