




VOIDED BY CHANGE ORDER A-1

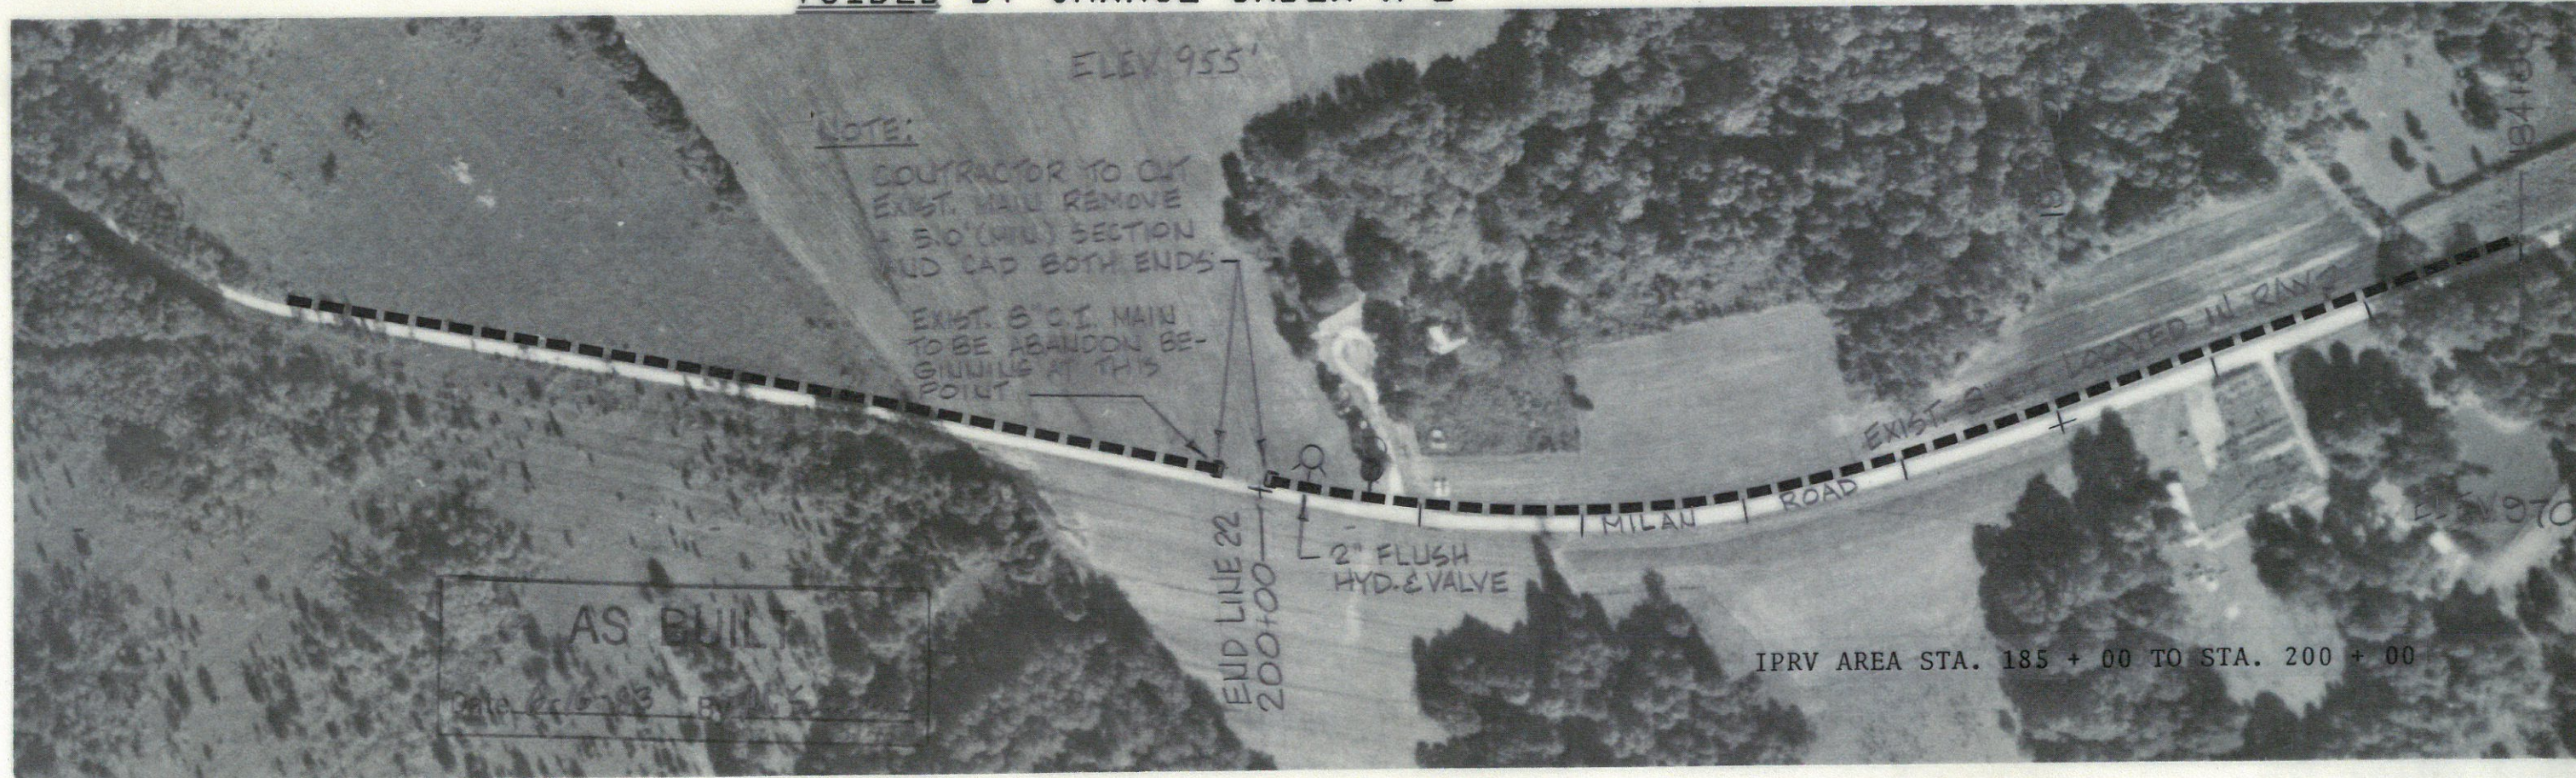

DRAWN BY	WDD	CHECKED BY	<i>[Signature]</i>	SIECO, INC.	ELROD WATER CO, INC.	REVISED: C.O. A-1	JOB NO.	SHT.
DATE	8-10-79	DATE	1-31-80	CONSULTING ENGINEERS			61140	55
		CERTIFIED BY		ARCHITECTS, PLANNERS		DIVISION: 11/11/11/12/1	SCALE: 1"=200'	OF 89