
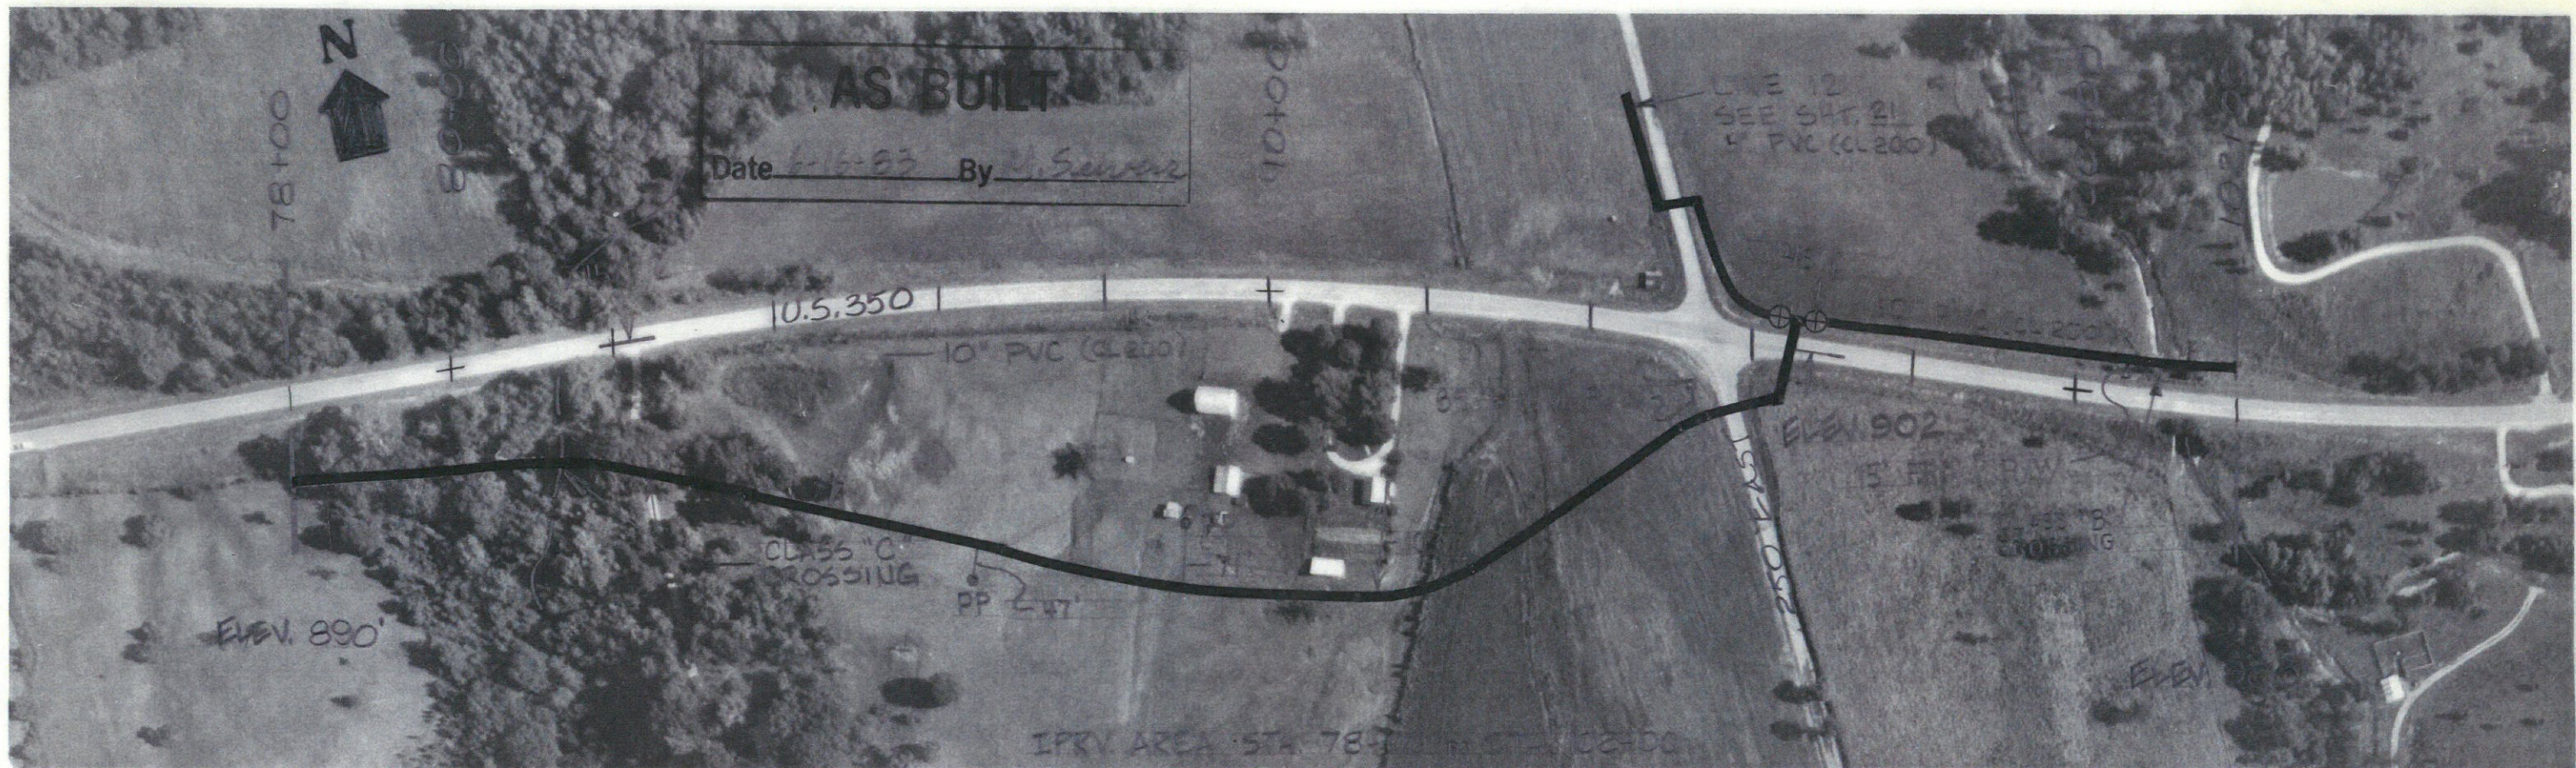


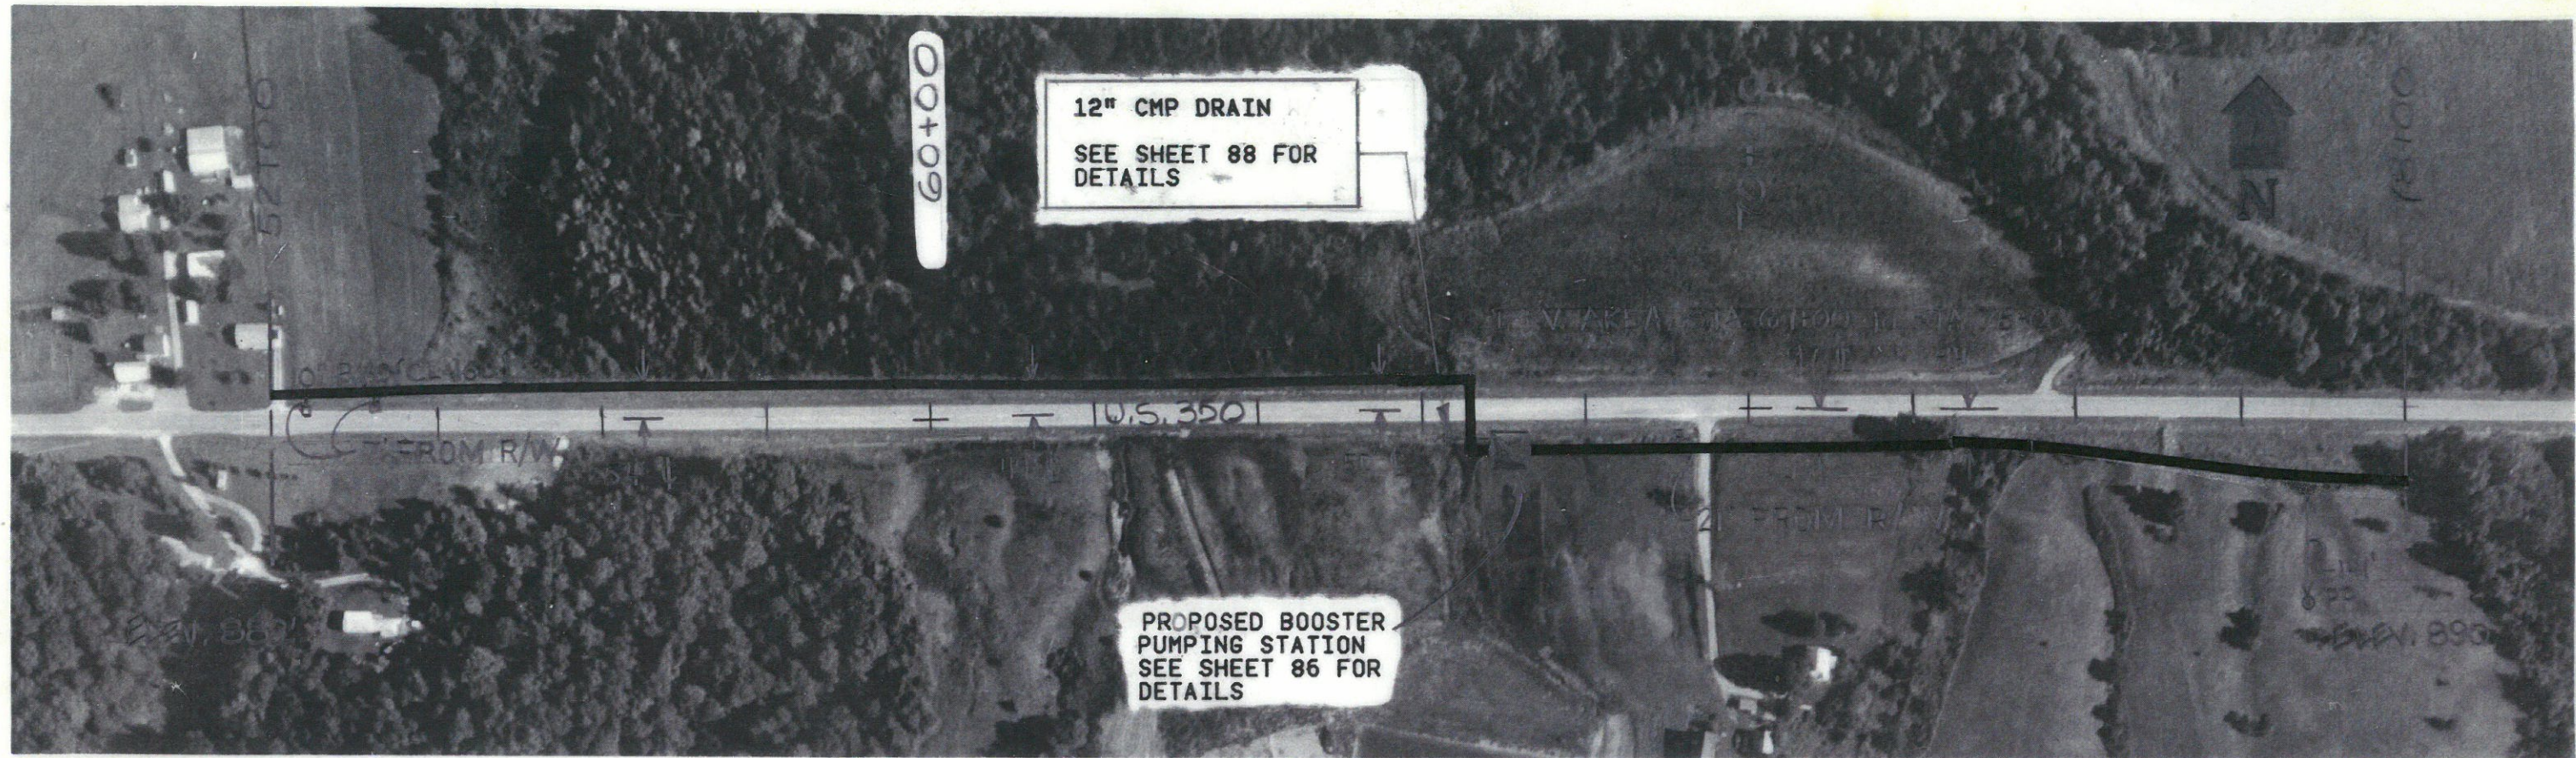

DRAWN BY	WDJ	CHECKED BY	David J. H.
DATE	7-17-79	DATE	1-21-80
		CERTIFIED BY	
		DATE	

SIECO, INC.
CONSULTING ENGINEERS,
ARCHITECTS, PLANNERS

ELROD WATER CO, INC.

REVISED: C.O. A-1

DIVISION: LINE 1

JOB No.	61140	SHT.	C
SCALE	1"=200'	OF	89