


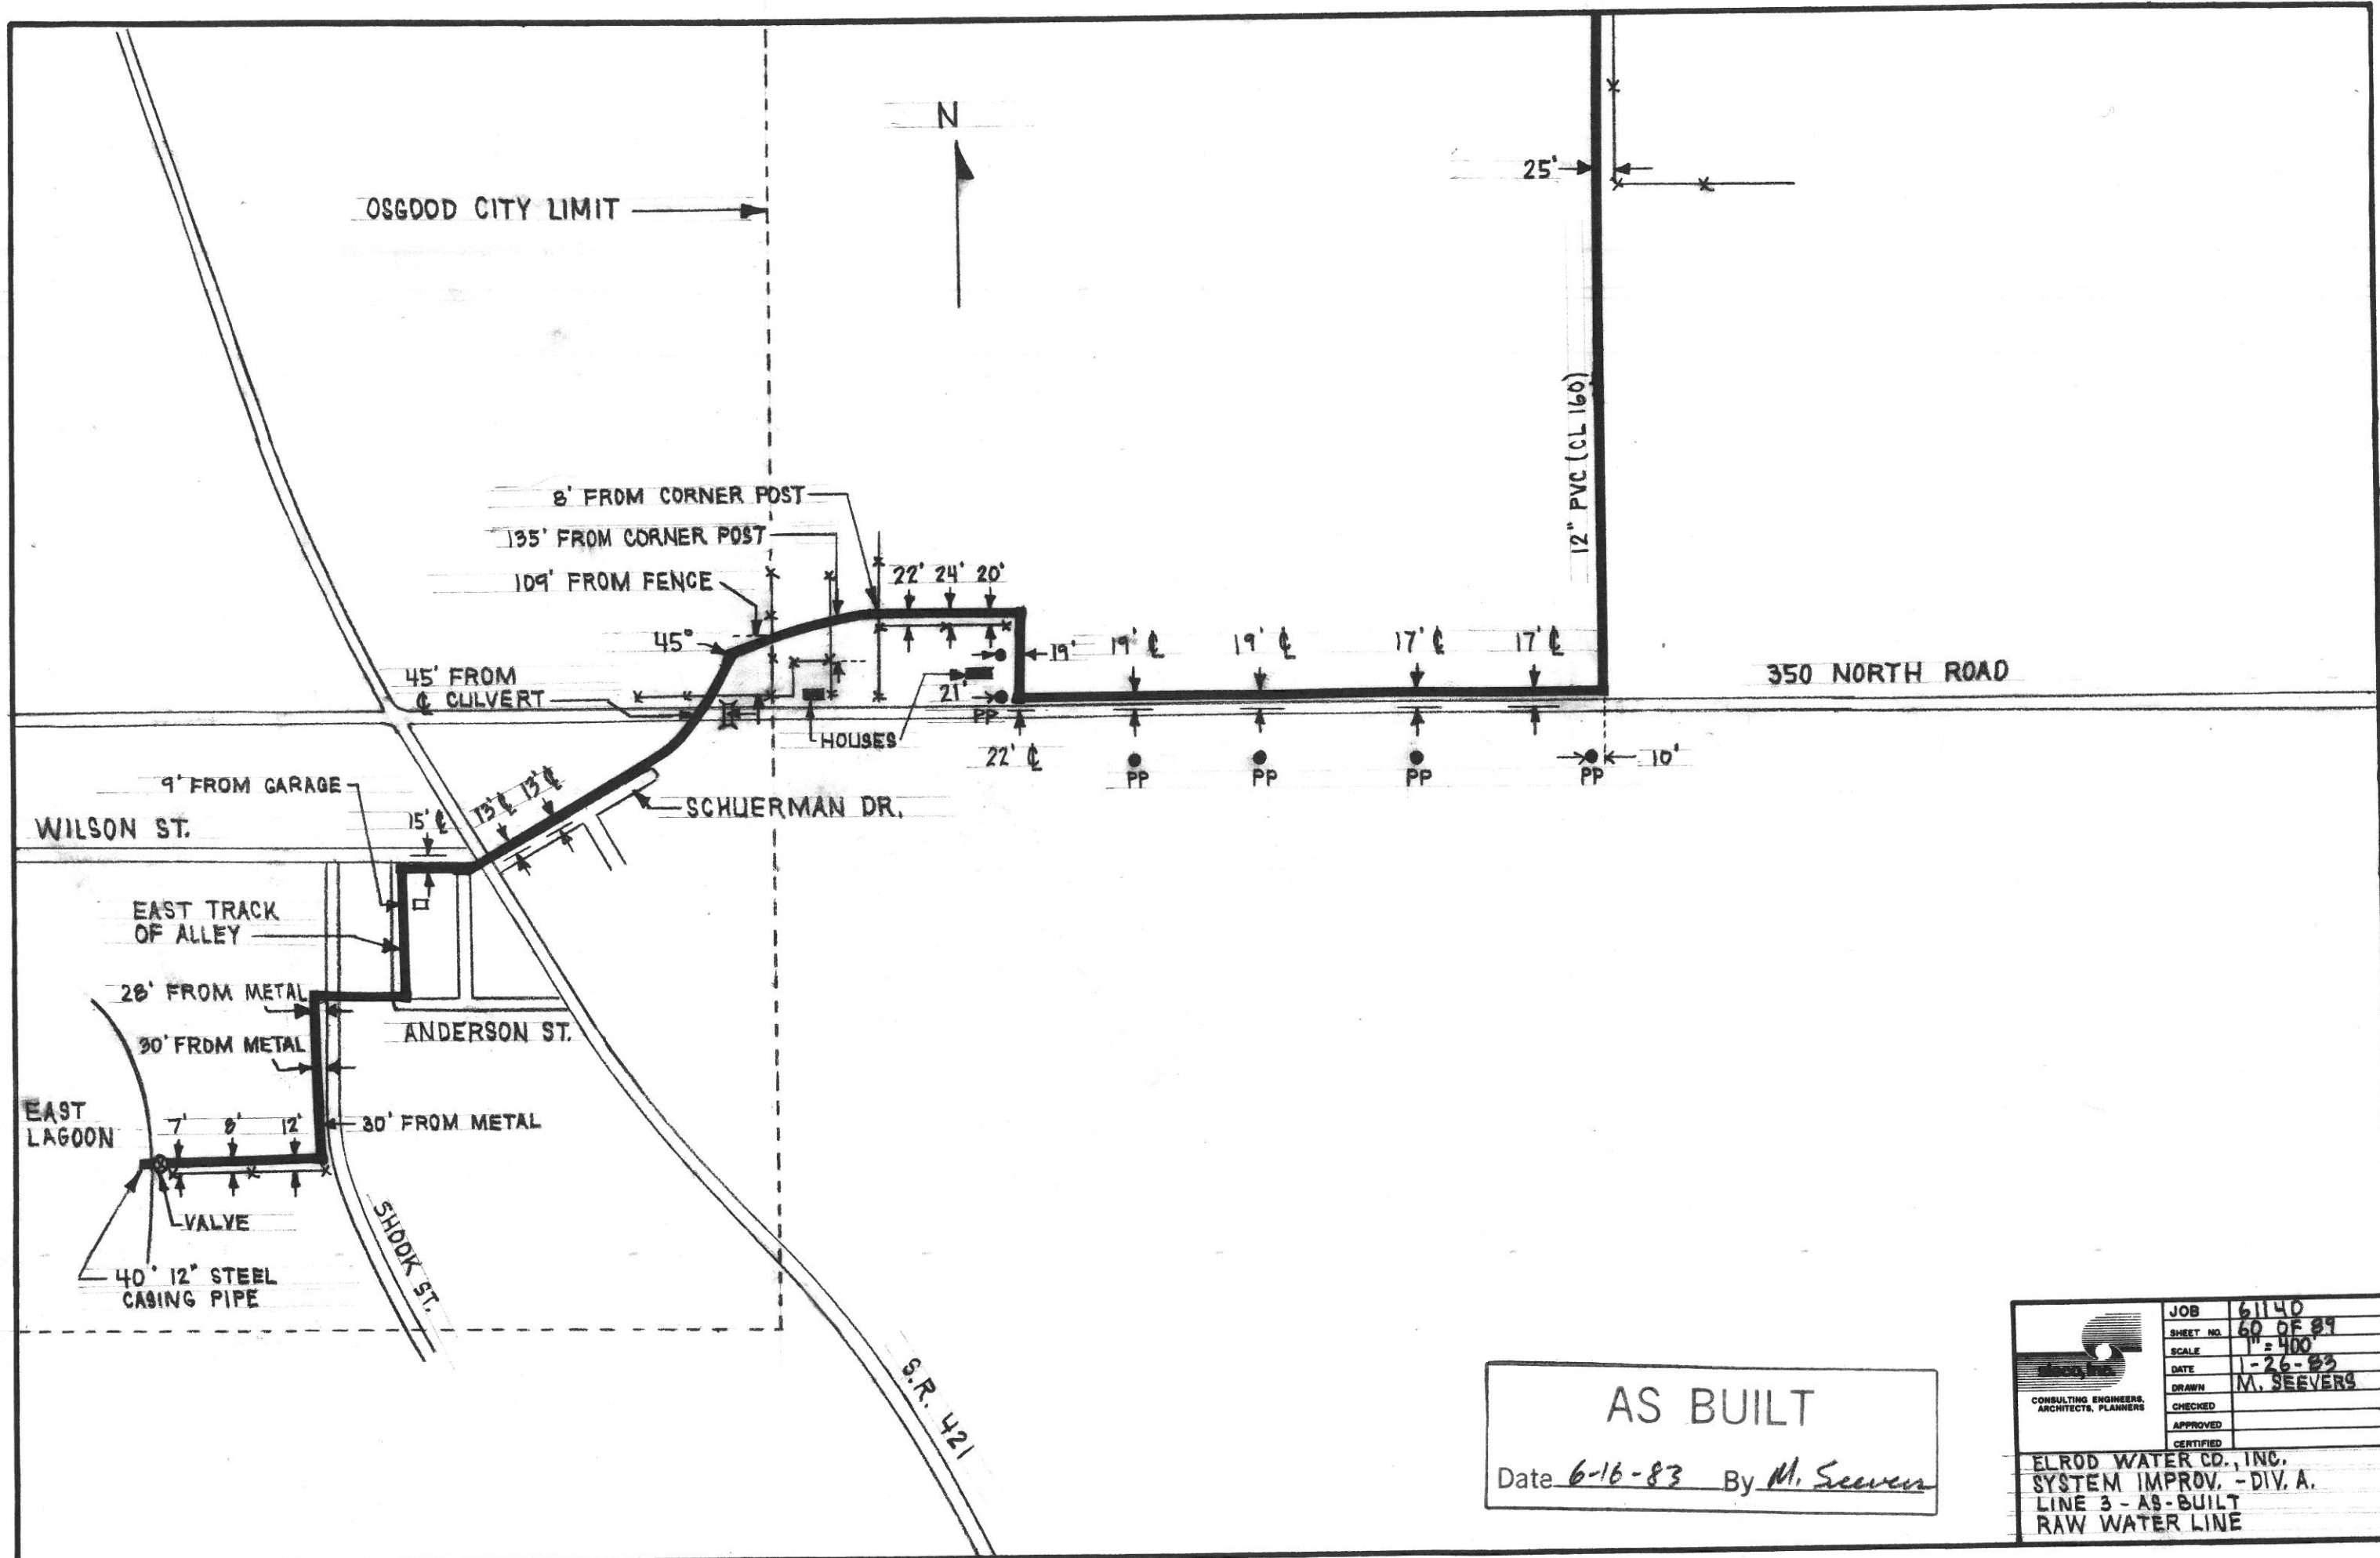

AS BUILT
 Date 6-16-83 By M. Seever

	JOB	61140
	SHEET NO.	60 OF 89
	SCALE	1" = 400'
	DATE	1-26-83
	DRAWN	M. SEEVERS
	CHECKED	
	APPROVED	
	CERTIFIED	
ELROD WATER CO., INC. SYSTEM IMPROV. - DIV. A. LINE 3 - AS-BUILT RAW WATER LINE		