
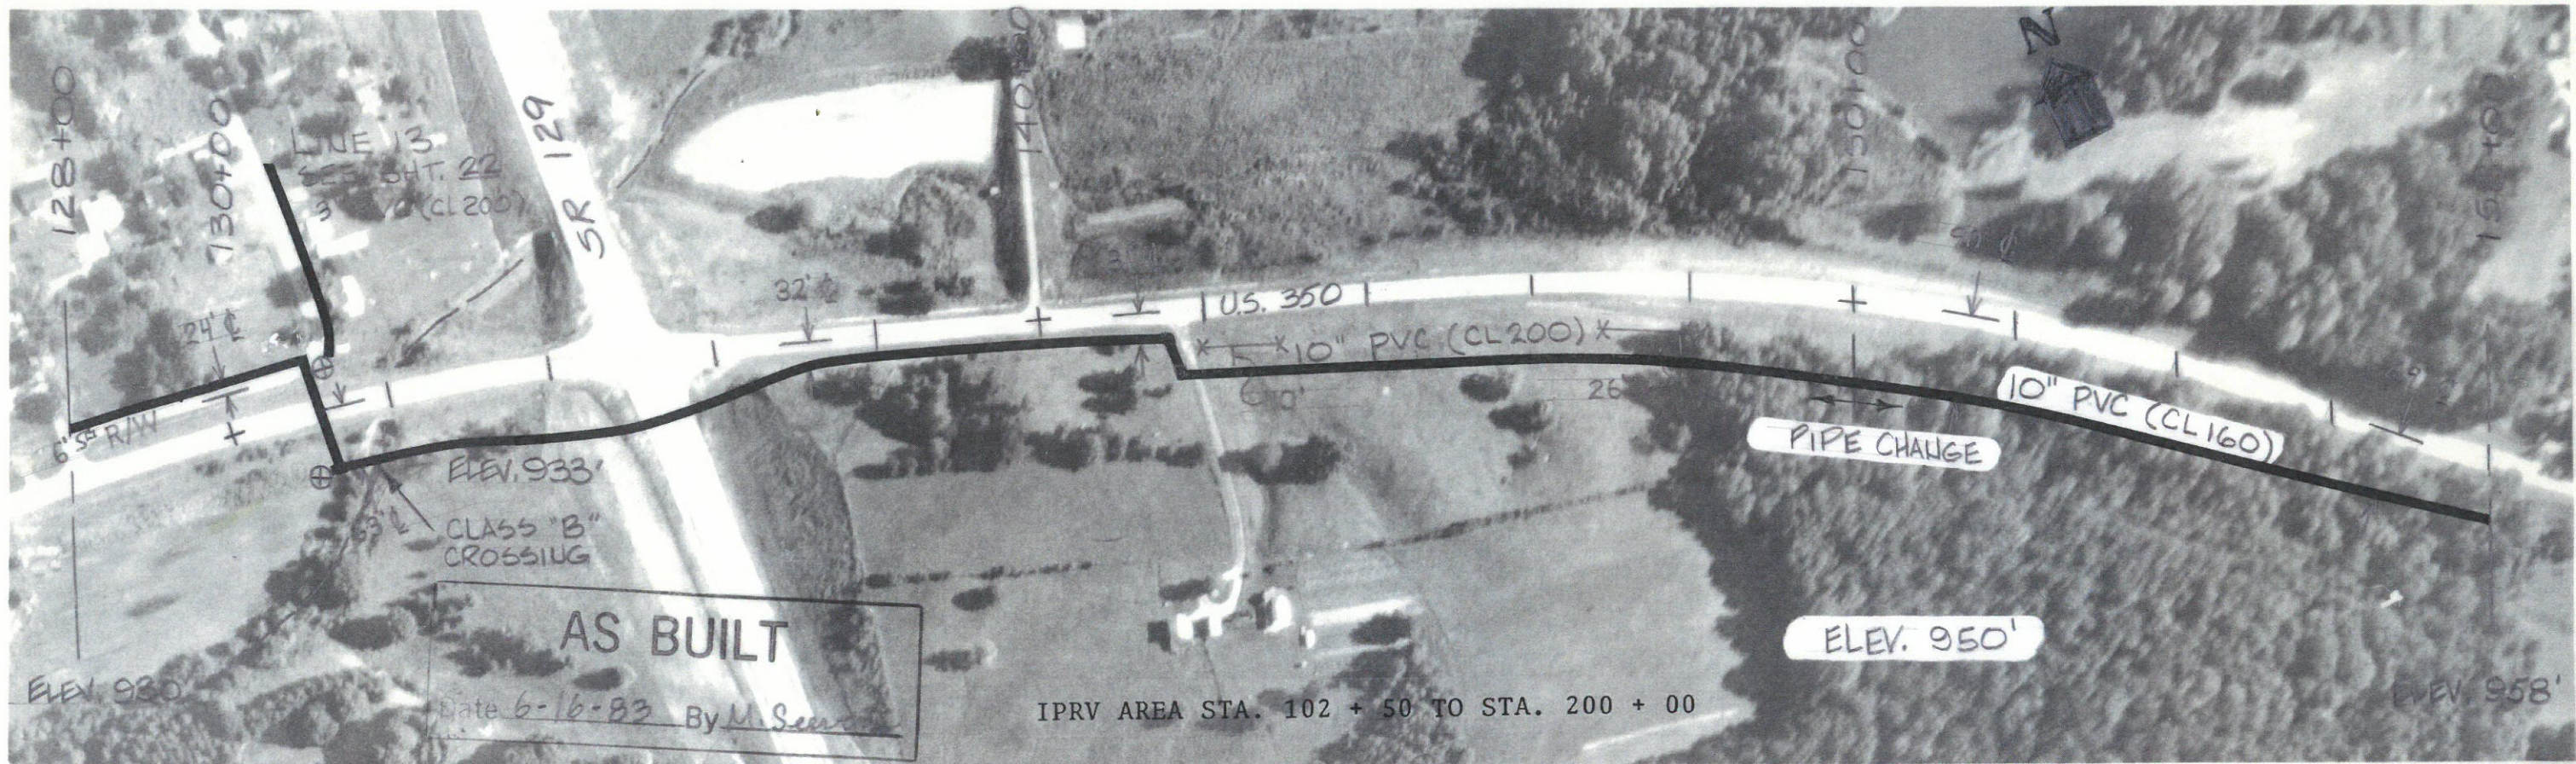


IPRV AREA STA. 102 + 50 TO STA. 200 + 00

DELAWARE

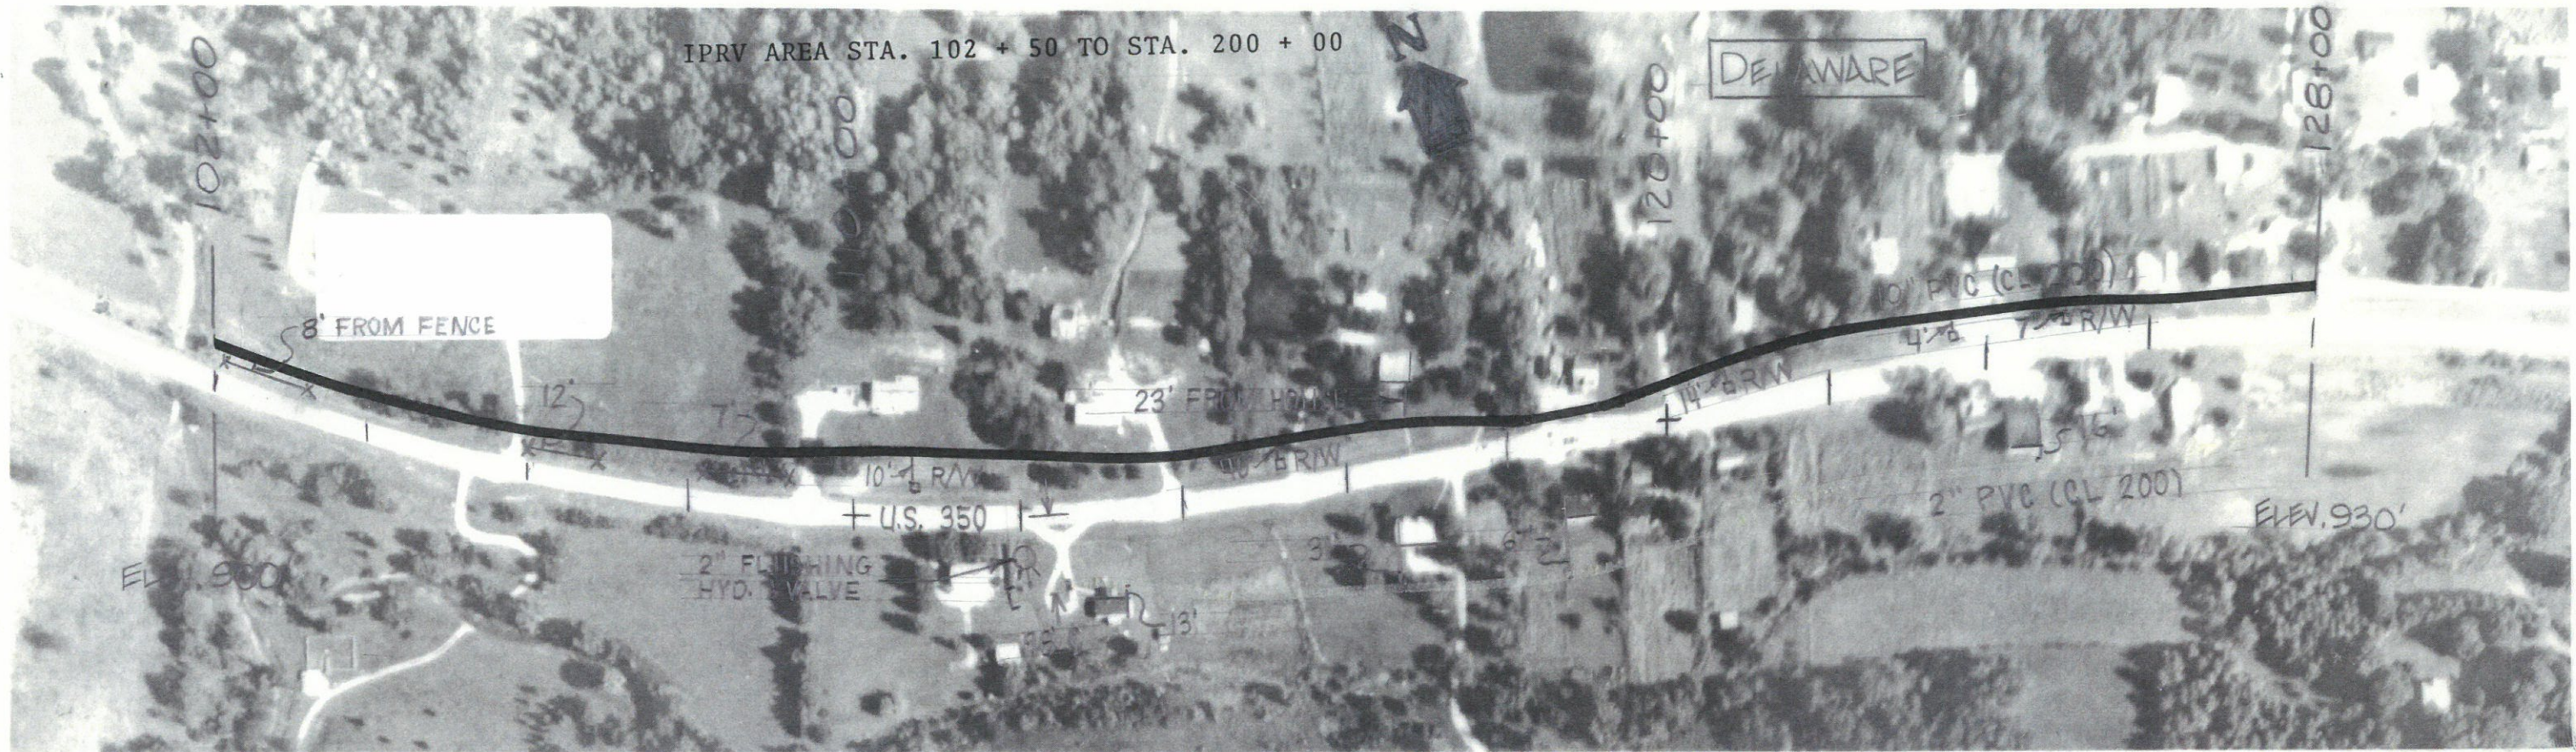

DRAWN BY	WDJ	CHECKED BY	DWIGHT
DATE	7-17-79	DATE	1-21-80
		CERTIFIED BY	
		DATE	

SIECO, INC.
CONSULTING ENGINEERS,
ARCHITECTS, PLANNERS

ELROD WATER CO, INC.

REVISED: C.O. A-1

DIVISION: LINE 1

JOB NO.
61140
SCALE:
1"=200'

SHT.
7
OF
89