

# CONSTRUCTION NOTES:

1. THE DIVISION "B" TANK CONTRACTOR SHALL BE RESPONSIBLE FOR CONSTRUCTION OF THE ELEVATED TANK INCLUDING PAINTING, AS PER THE PLANS AND SPECIFICATIONS.

TANK CONTRACTOR SHALL INSTALL CAST IRON INLET AND FIRE HYDRANT PIPING TO A POINT 5'-0" BEYOND THE OUTSIDE DIA. OF THE TANK'S CONCRETE PIERS, TERMINATING WITH PLAIN END PIPE.

TOP OF FOOTER AND SITE ELEVATIONS TO BE CONFIRMED PRIOR TO CONSTRUCTION OF CONCRETE PIERS.


2. THE DIVISION "A" CONTRACTOR SHALL BE RESPONSIBLE FOR ALL OTHER WORK WITHIN THE TANK SITE BOUNDARIES AS SHOWN ON THE PLANS, INCLUDING THE SITE WORK.

ALL SITE WORK REQUIRED SHALL BE SEEDED AND MULCHED AS PER THE SPECIFICATIONS. THE EXISTING SITE DRAINAGE SHALL NOT BE CHANGED.

DIVISION "A" CONTRACTOR TO MAKE ALL PIPING CONNECTIONS AND SUPPLY ALL TRANSITION FITTINGS.

AS BUILT

Date 6-16-83 By M. Seever

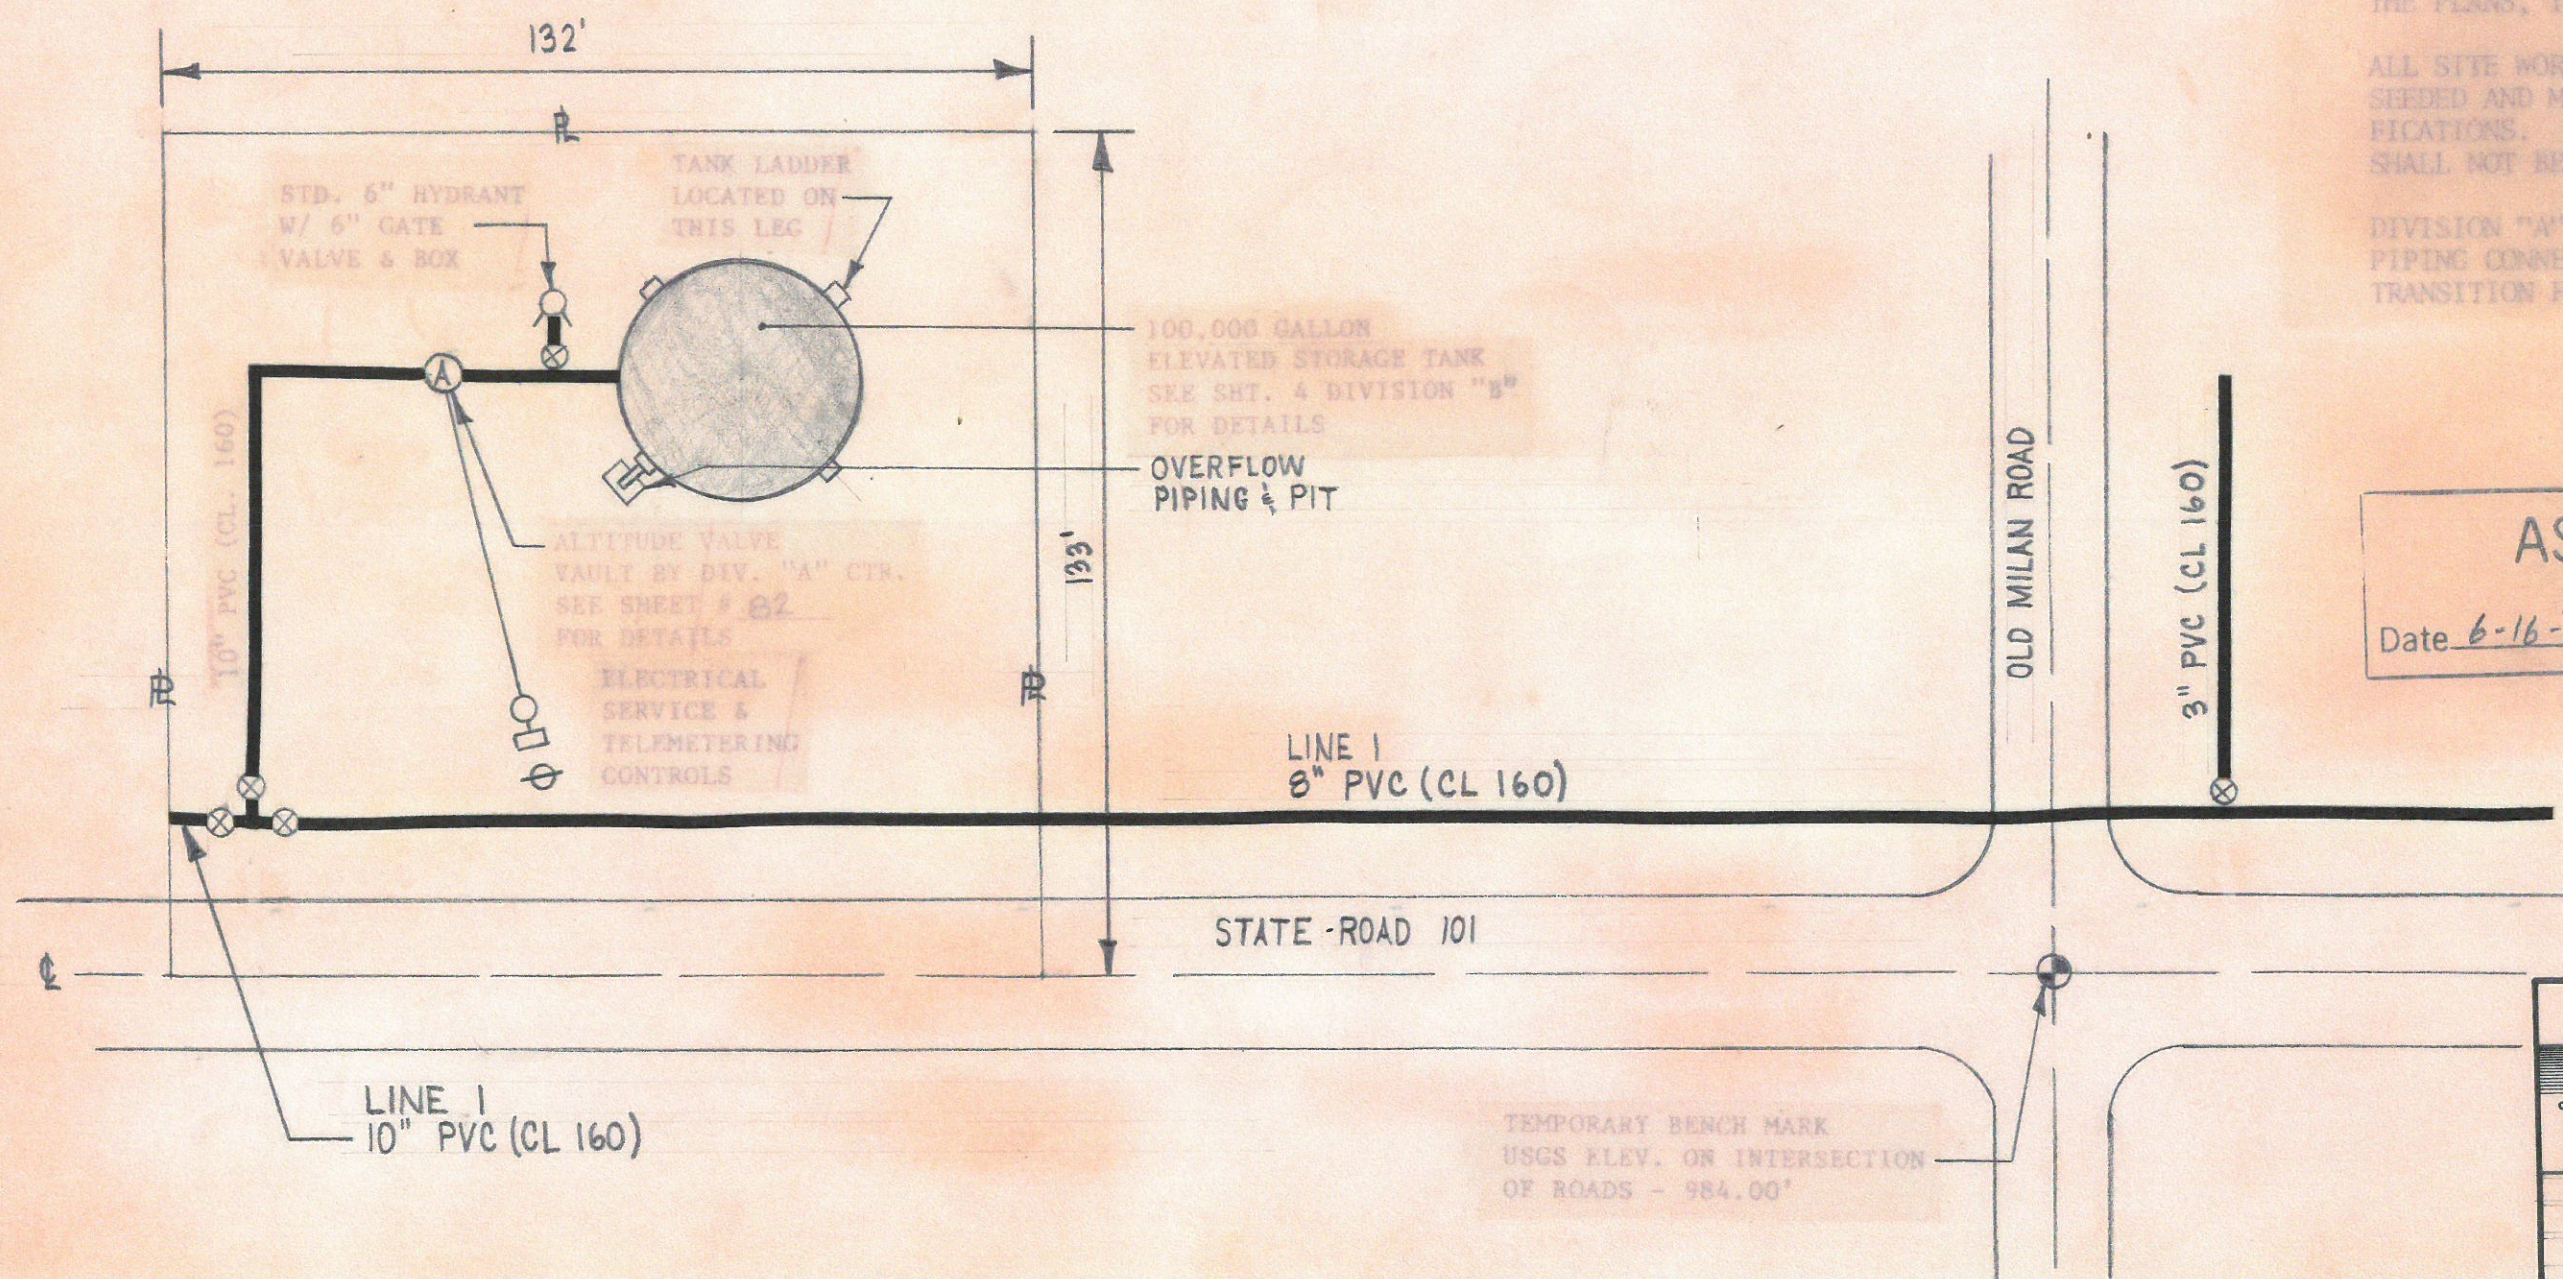

JOB	61140
SHEET NO.	80 OF 89
SCALE	1" = 30'
DATE	3-16-83
DRAWN	M. SEEVERS
CHECKED	
APPROVED	
CERTIFIED	
ELROD WATER COMPANY, INC. RIPLEY CO., IND.	