



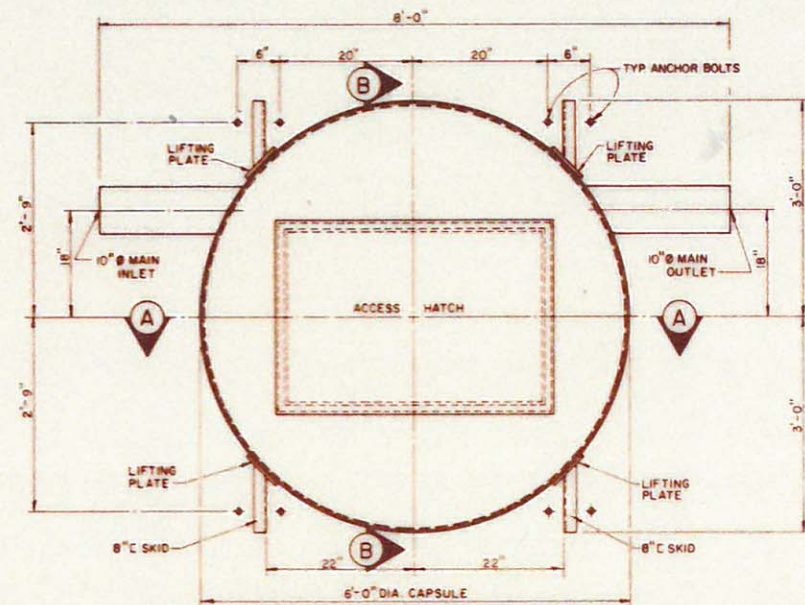


EXTERIOR PLAN VIEW

8" (MIN) THICK CONCRETE PAD ON
6" (MIN) THICK GRAVEL BASE WITH
#5 BARS, 6" O.C. EACHWAY.

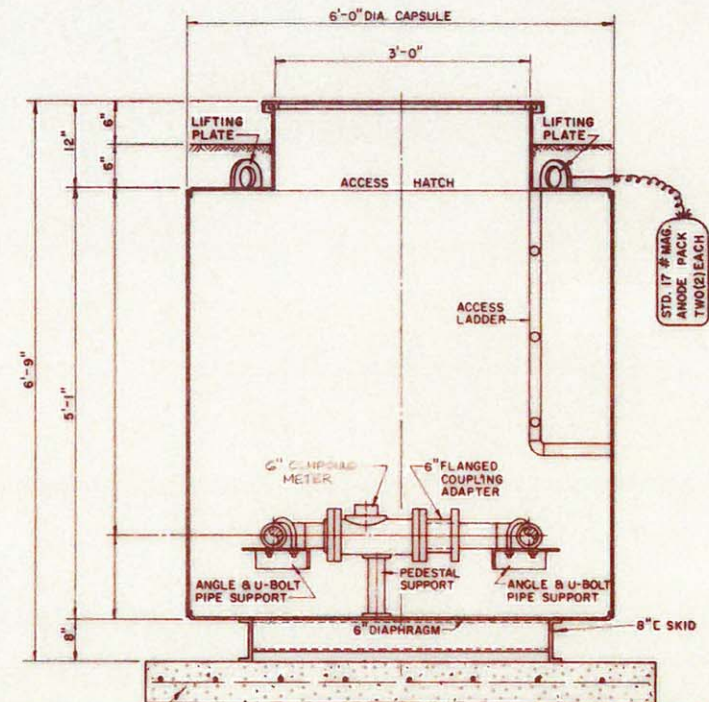


SECTION A-A

REINFORCED CONCRETE PAD AND ANCHORS
BY INSTALLING CONTRACTOR IN ACCORDANCE
WITH DIMENSIONS SHOWN AND/OR AS
DIRECTED BY THE ENGINEER.

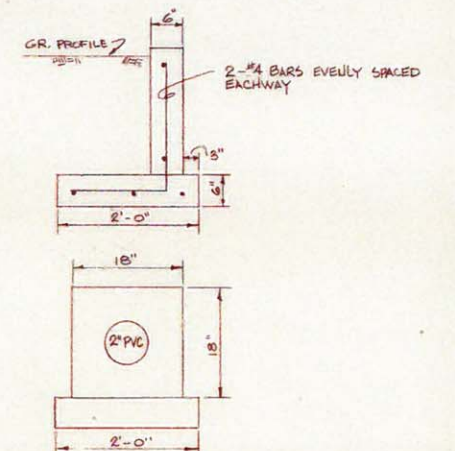

CONCRETE HEADWALL DETAIL FOR 2" x 12" DRAIN LINES

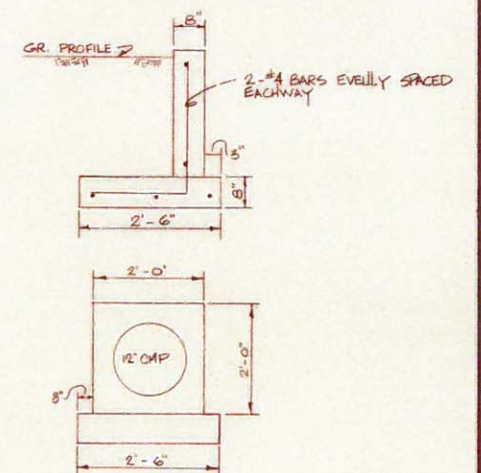


NOTE:


FOR GENERAL LOCATION OF THE MASTER METER STATION
SEE LINE 1, SHEET 15. THE EXACT LOCATION SHALL
BE DETERMINED IN THE FIELD BY THE ENGINEER OR
HIS REPRESENTATIVE.

AS BUILT

Date 6-16-83 By M. Sencus

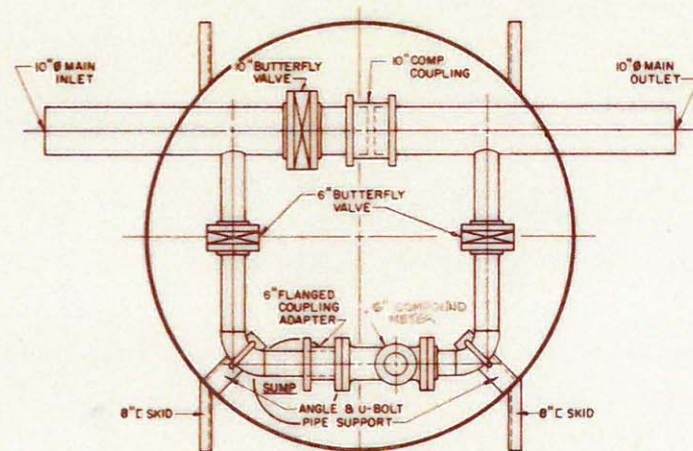

INTERIOR PLAN VIEW

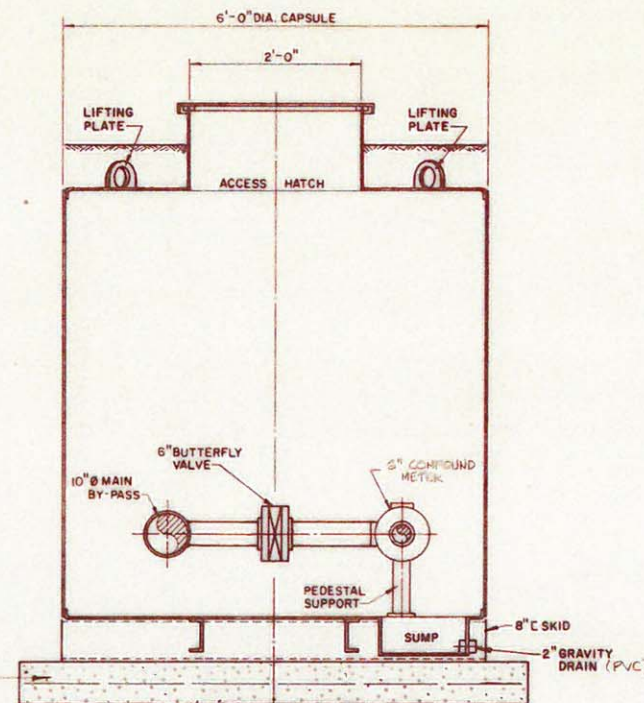

SECTION B-B

7' x 7' x 8" CONC. PAD

 sleco, inc. CONSULTING ENGINEERS, ARCHITECTS, PLANNERS Columbus, Indiana Delaware, Ohio Louisville, Kentucky	JOB	61140
	SHEET NO.	88 OF 88
	SCALE	NONE
	DATE	1-2-80
	DRAWN	W. D. J.
	CHECKED	
	APPROVED	
	CERTIFIED	
ELROD WATER COMPANY, INC. RIPLEY CO., IND. SYSTEM IMPROV. - DIVISION "A" MAINLINE MASTER METER STATION DETAILS		