



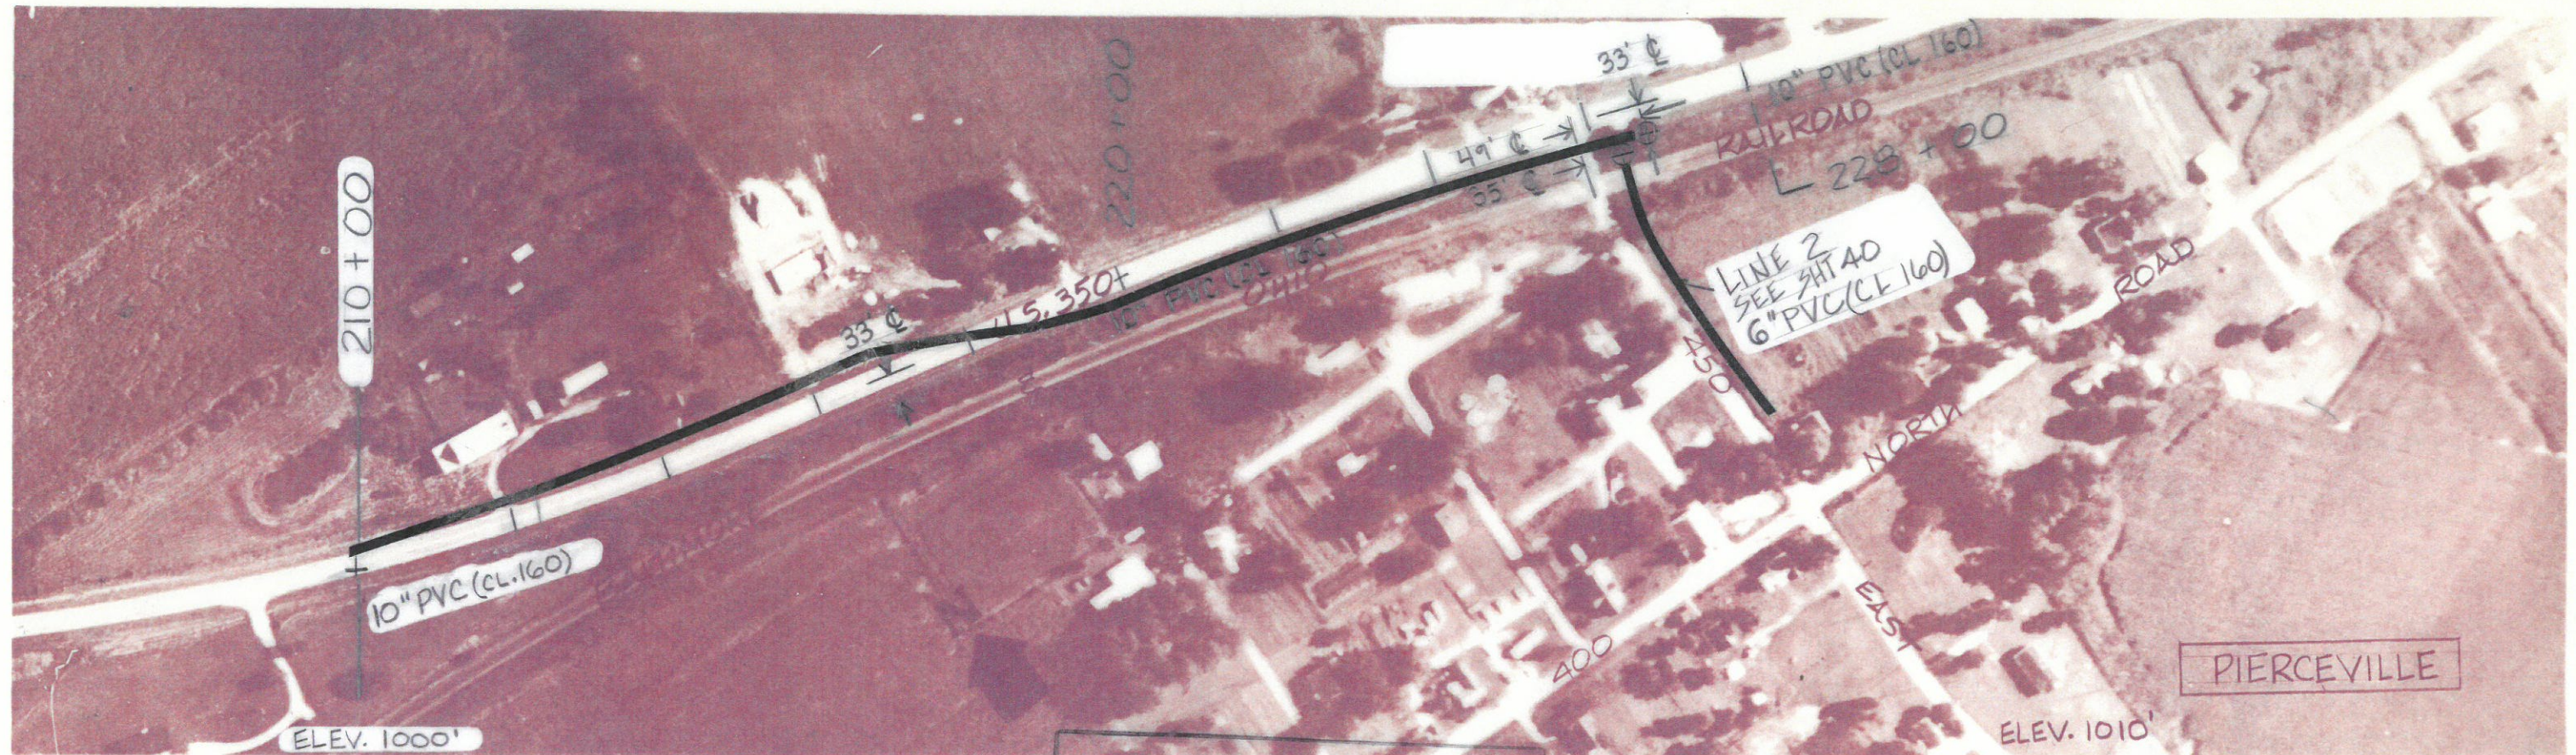

AS BUILT

Date 6-16-93 By M. S. [Signature]

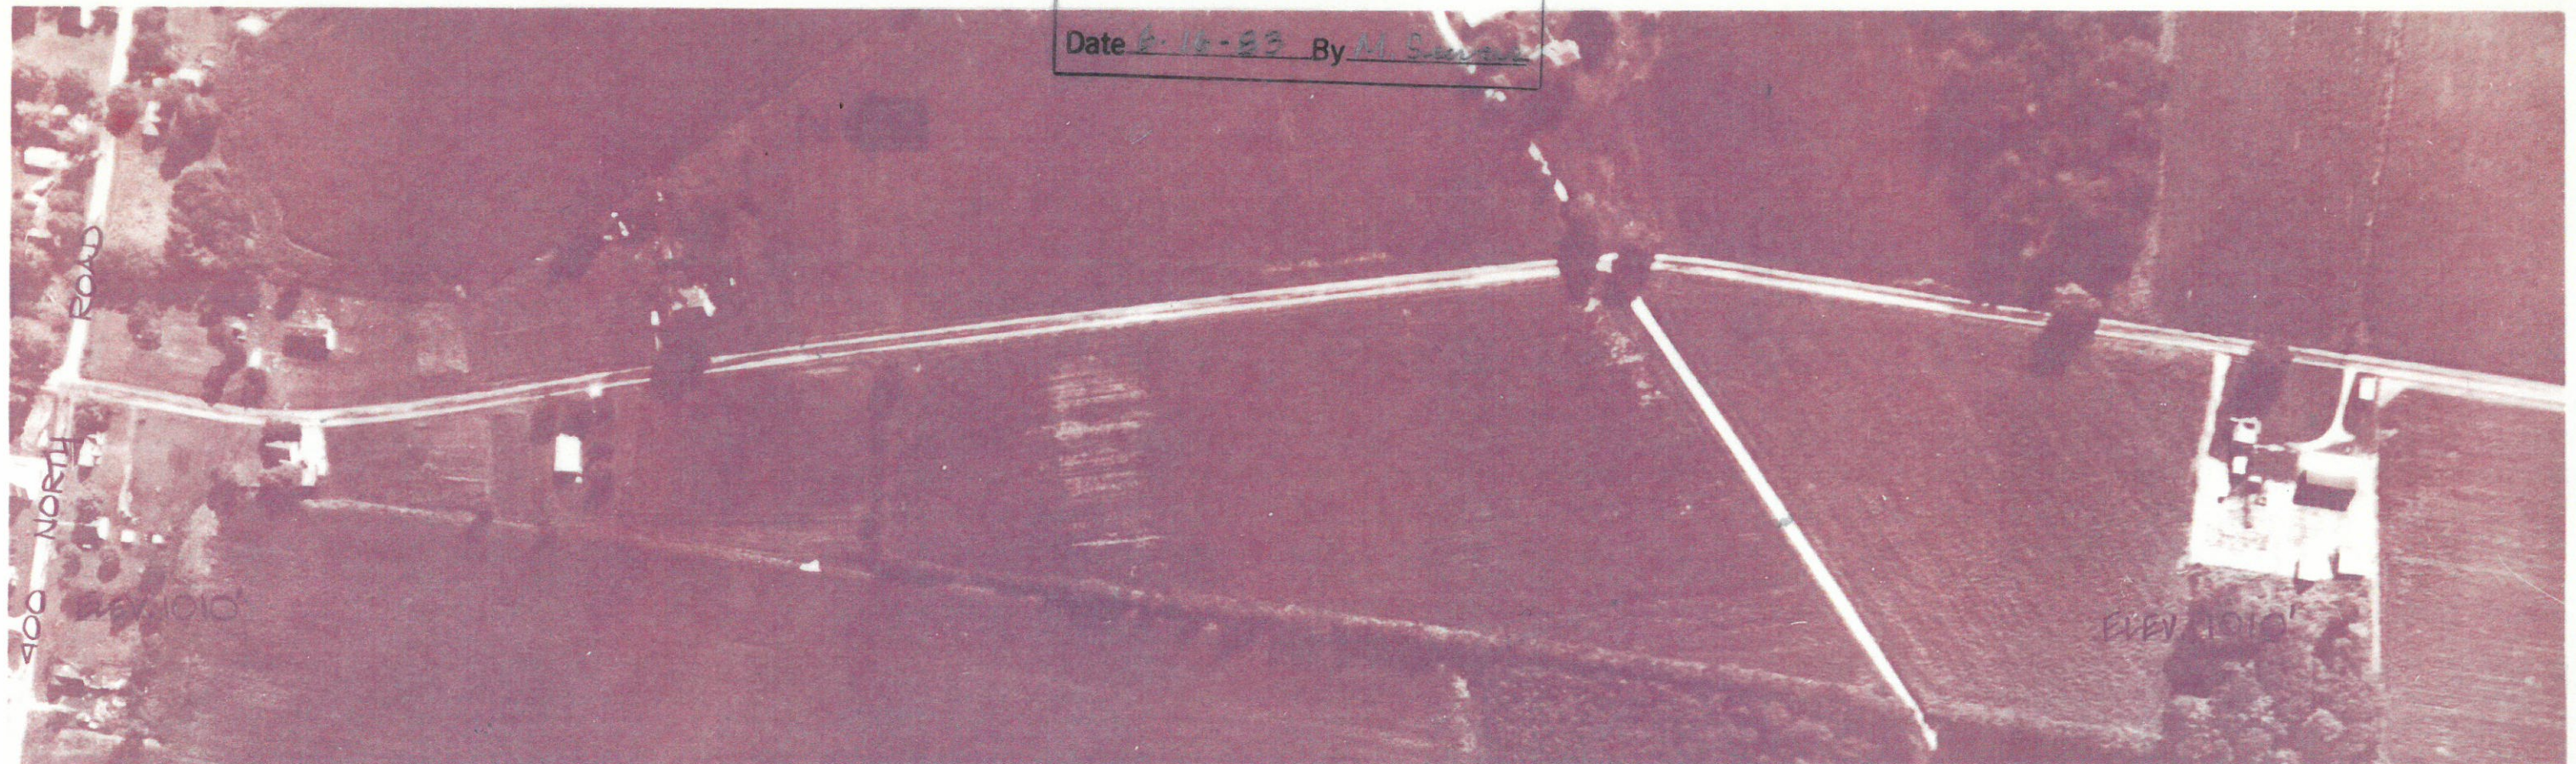

DRAWN BY	W.D.J.	CHECKED BY	[Signature]
DATE	7.17.79	DATE	1.8.80
		CERTIFIED BY	
		DATE	

SIECO, INC.
CONSULTING ENGINEERS,
ARCHITECTS, PLANNERS

ELROD WATER CO, INC.

REVISED; C.O. A-1
LINE 1
DIVISION

JOB NO	6140	SHT	9
SCALE	1"=200'	OF	89