


SCALE 1" = 2000

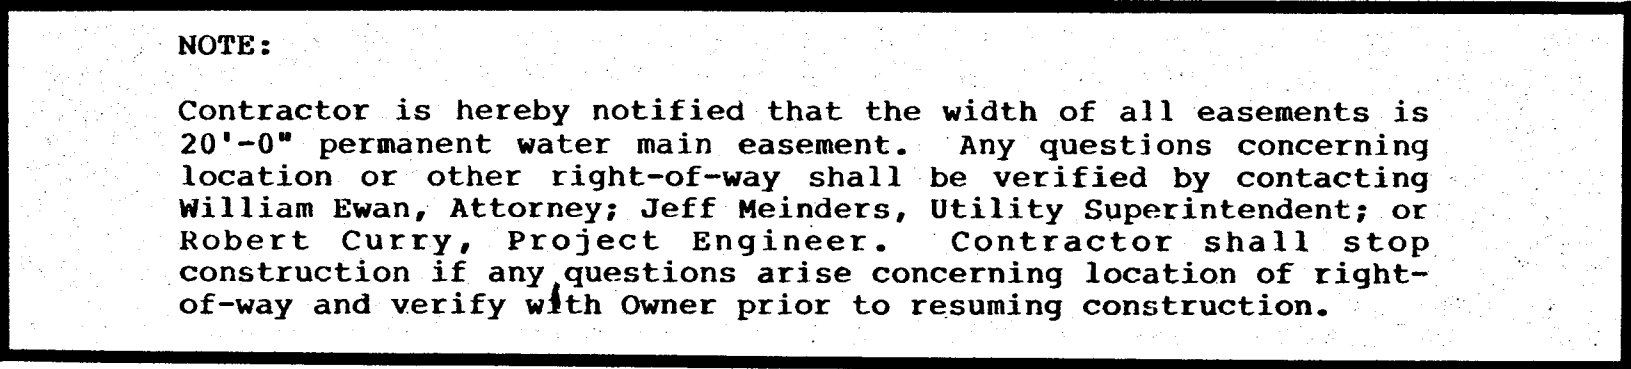

| INDEX        |                                         |            |       |
|--------------|-----------------------------------------|------------|-------|
| SHEET<br>NO. | DESCRIPTION                             | MATCH LINE |       |
|              |                                         | BEGIN      | END   |
| 1            | Cover Sheet                             | N/A        | N/A   |
| 2            | Location Map, Index, & Legend           | N/A        | N/A   |
| 3            | Spades Road                             | 1-1        | 3-3   |
| 4            | Spades Road                             | 3-3        | 6-6   |
| 5            | Spades Road                             | 6-6        | 9-9   |
| 6            | Spades Road                             | 9-9        | 12-12 |
| 7            | Spades Road                             | 12-12      | 15-15 |
| 8            | Spades Road                             | 15-15      | 18-18 |
| 8            | County Road 1100 North                  | 50-50      | N/A   |
| 9            | Spades Road                             | 18-18      | 20-20 |
| 9            | County Road 1200 North                  | 22-22      | N/A   |
| 10           | Community of Spades                     | 20-20      | 21-21 |
| 11           | Community of Spades                     | 21-21      | N/A   |
| 12           | County Road 1200 North                  | 22-22      | 25-25 |
| 13           | County Road 1200 North                  | 25-25      | 28-28 |
| 14           | County Road 1200 North                  | 28-28      | 31-31 |
| 14           | County Road 500 East                    | 31-31      | 32-32 |
| 15           | County Road 500 East                    | 32-32      | 35-35 |
| 16           | County Road 500 East                    | 35-35      | 38-38 |
| 17           | County Road 500 East                    | 38-38      | 39-39 |
| 17           | County Road 1400 North                  | 39-39      | 40-40 |
| 18           | Community of Morris                     |            |       |
| 19           | Community of Morris                     |            |       |
| 20           | Community of Morris                     |            |       |
| 21           | Community of Morris                     |            |       |
| 22           | County Road 1100 North                  | 50-50      | 51-51 |
| 22           | County Road 650 East on ST. NICHOLAS RD | 51-51      | 53-53 |
| 23           | County Road 650 East on ST. NICHOLAS RD | 53-53      | N/A   |
| 23           | County Road 650 East on ST. NICHOLAS RD | N/A        | N/A   |
| 24           | Standard Details                        | N/A        | N/A   |

| LEGEND |                                                           |
|--------|-----------------------------------------------------------|
| SYMBOL | ITEM                                                      |
|        | BENDS                                                     |
|        | VALVE                                                     |
|        | REDUCER                                                   |
|        | TEE OR TAPPING SLEEVE (SEE NOTES)                         |
|        | STANDARD HYDRANT                                          |
|        | NEW METER                                                 |
|        | EXISTING METER                                            |
|        | NEW WATER MAIN                                            |
|        | EXISTING WATER MAIN                                       |
|        | CONTINUATION OF NEW WATER MAIN                            |
|        | SEWER                                                     |
|        | TELEPHONE                                                 |
|        | GAS                                                       |
|        | NEW SERVICES                                              |
|        | EXISTING SERVICES                                         |
|        | LOCATIONS REQUIRING GRANULAR BACKFILL AND PAVEMENT REPAIR |

AS BUILT 10-17-88

**Robert E. Curry & Associates, Inc.**  
**Engineers and Architects**  
**3346 Avon Road, Plainfield, Ill 46168**  
**(317)-272-3050**

ELROD WATER COMPANY, INC.

## WATER MAIN EXTENSIONS

LOCATION MAP, INDEX AND LEGEND

|         |                  |                |
|---------|------------------|----------------|
| DATE    | APPROVED BY      | DRAWING NUMBER |
| 4/15/87 | Robert E. Curran | 2 OF 24        |

