


GR. ELEV. 1000±
MAX. STATIC PRES. 69 PSI

COUNTY ROAD 1200 NORTH


GR. ELEV. 1000±
MAX. STATIC PRES. 69 PSI

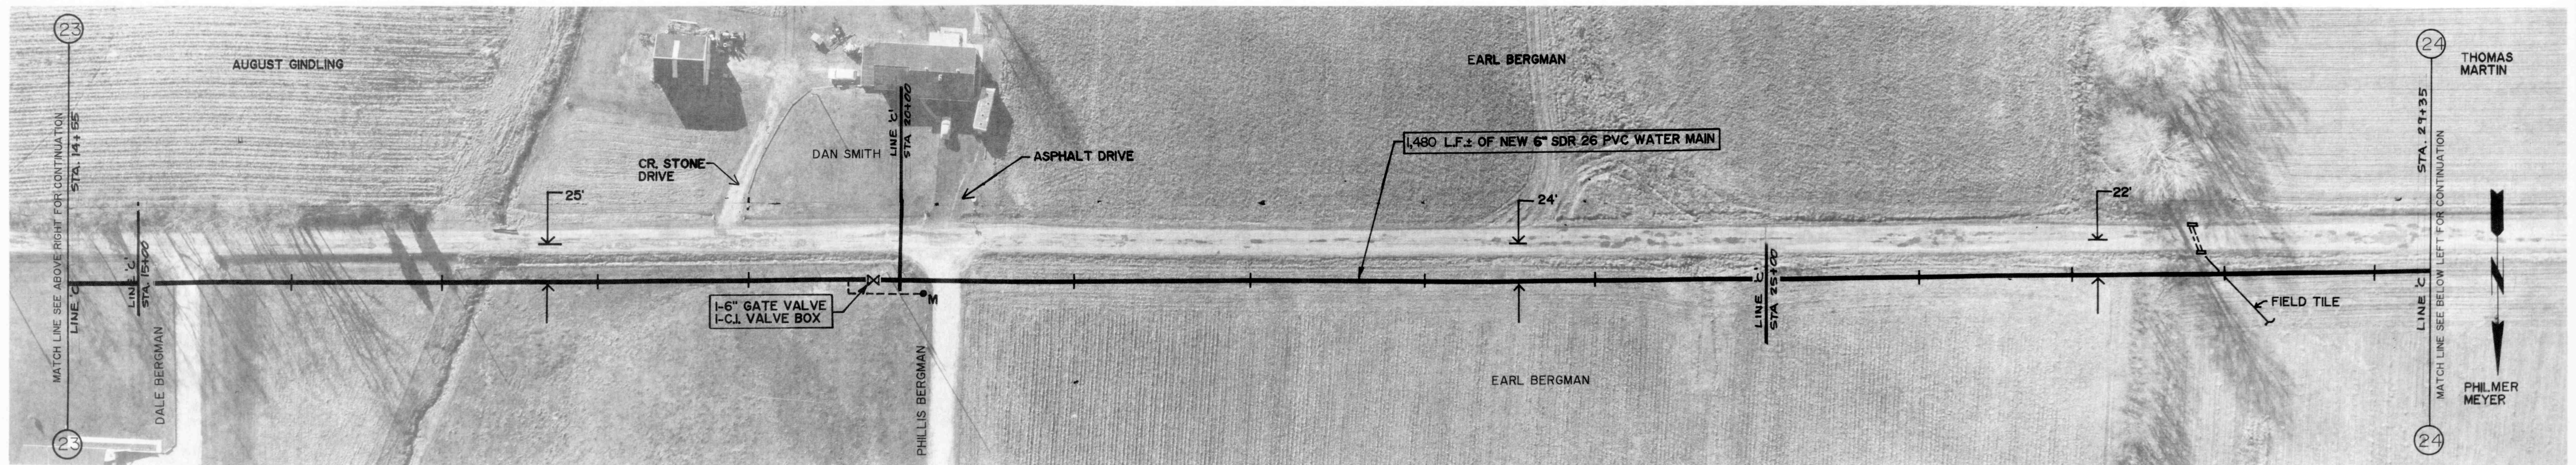

GR. ELEV. 990±
MAX. STATIC PRES. 73 PSI

COUNTY ROAD 1200 NORTH

GR. ELEV. 1000±
MAX. STATIC PRES. 69 PSI

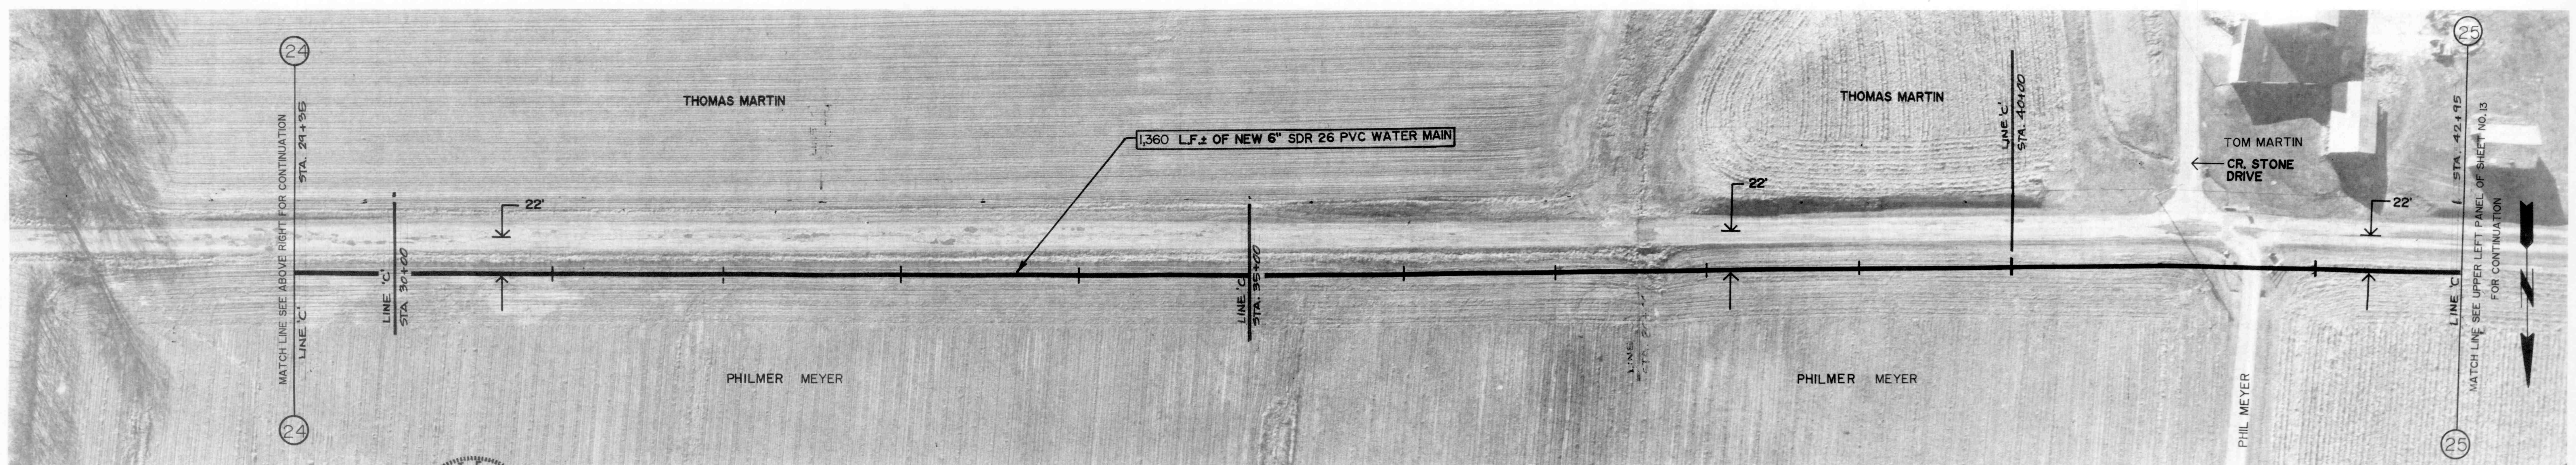

GR. ELEV. 1000±
MAX. STATIC PRES. 69 PSI

COUNTY ROAD 1200 NORTH

GR. ELEV. 1000±
MAX. STATIC PRES. 69 PSI



REVISIONS DATE CERTIFIED BY DATE	DRAWN BY DATE CERTIFIED BY DATE	ROBERT E. CURRY & ASSOCIATES, INC. CONSULTING ENGINEERS 3346 AVON ROAD PLAINFIELD, INDIANA 46168	ELROD WATER COMPANY, INC. RIPLEY COUNTY, INDIANA	WATER MAIN EXTENSIONS TO COMMUNITIES OF CLINTON, SPADES & MORRIS	AS BUILT 10-17-88 JOB NO. _____ SHT. 12 SCALE 1" = 50' OF 24
---	--	---	---	---	--