


GR. ELEV. 1000±
MAX. STATIC PRES. 69 PSI

COUNTY ROAD 1200 NORTH


GR. ELEV. 1000±
MAX. STATIC PRES. 69 PSI

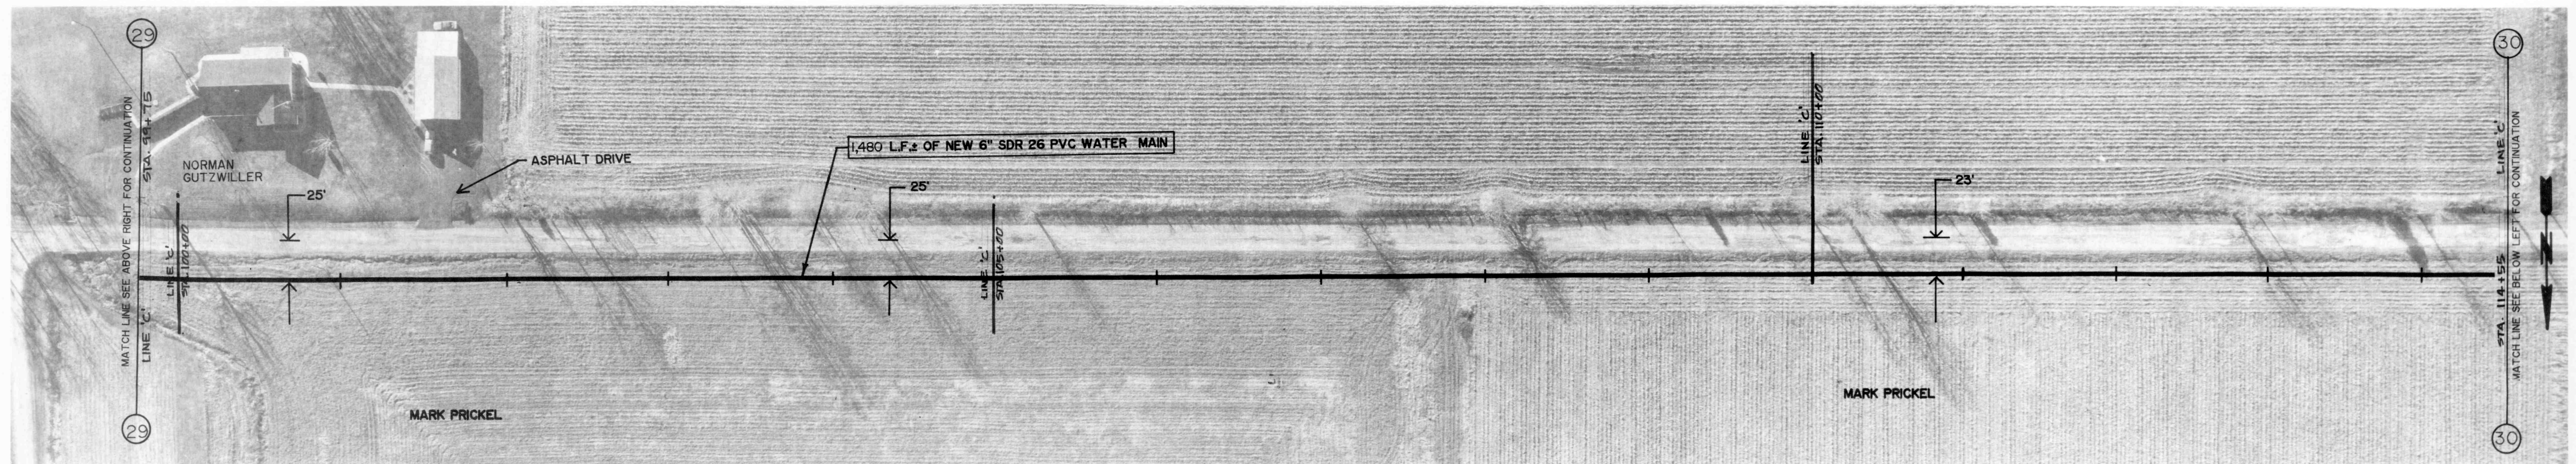

GR. ELEV. 1000±
MAX. STATIC PRES. 69 PSI

COUNTY ROAD 1200 NORTH


GR. ELEV. 1000±
MAX. STATIC PRES. 69 PSI

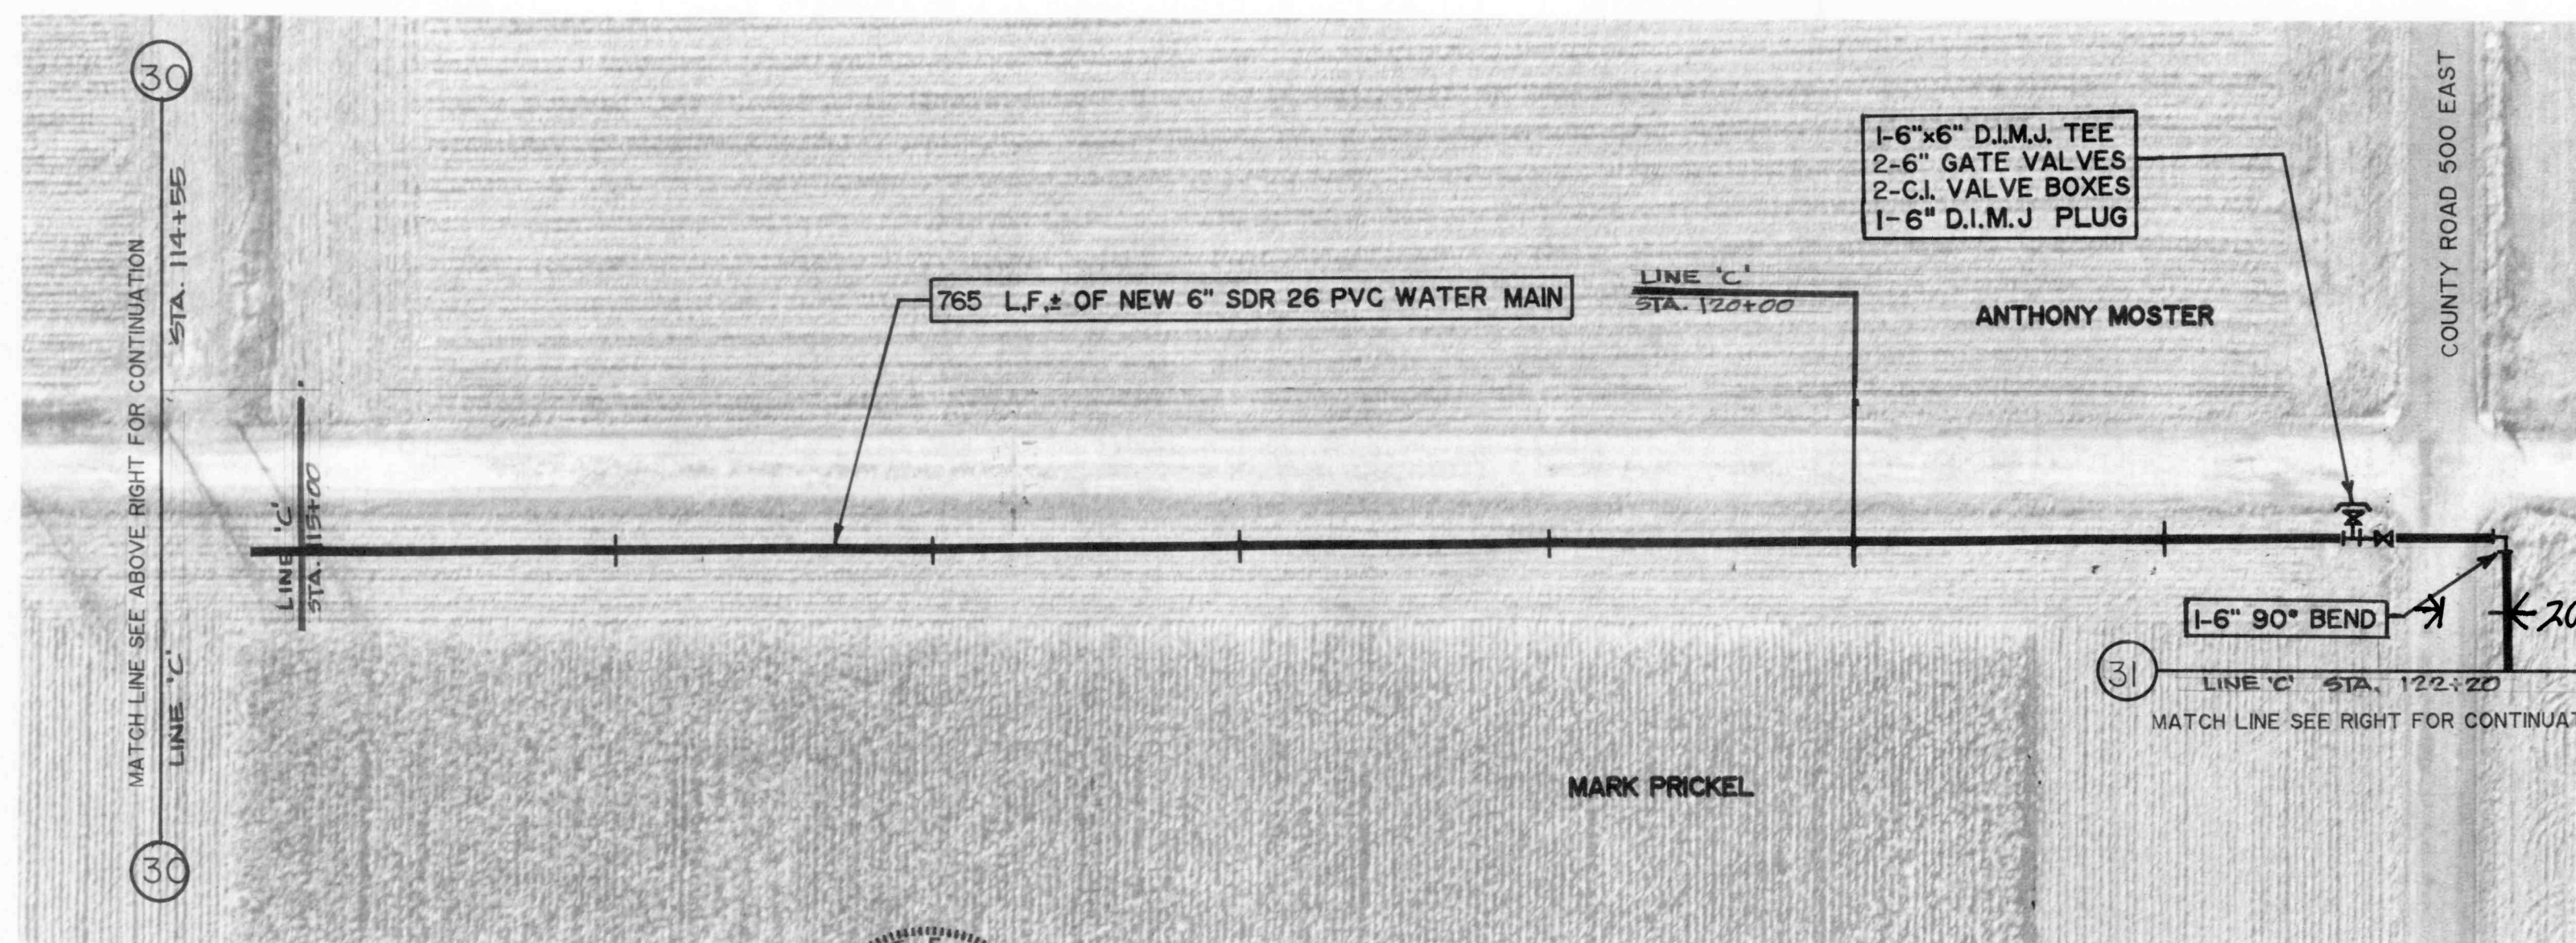

GR. ELEV. 1000±
MAX. STATIC PRES. 69 PSI

COUNTY ROAD 1200 NORTH

GR. ELEV. 1000±
MAX. STATIC PRES. 69 PSI

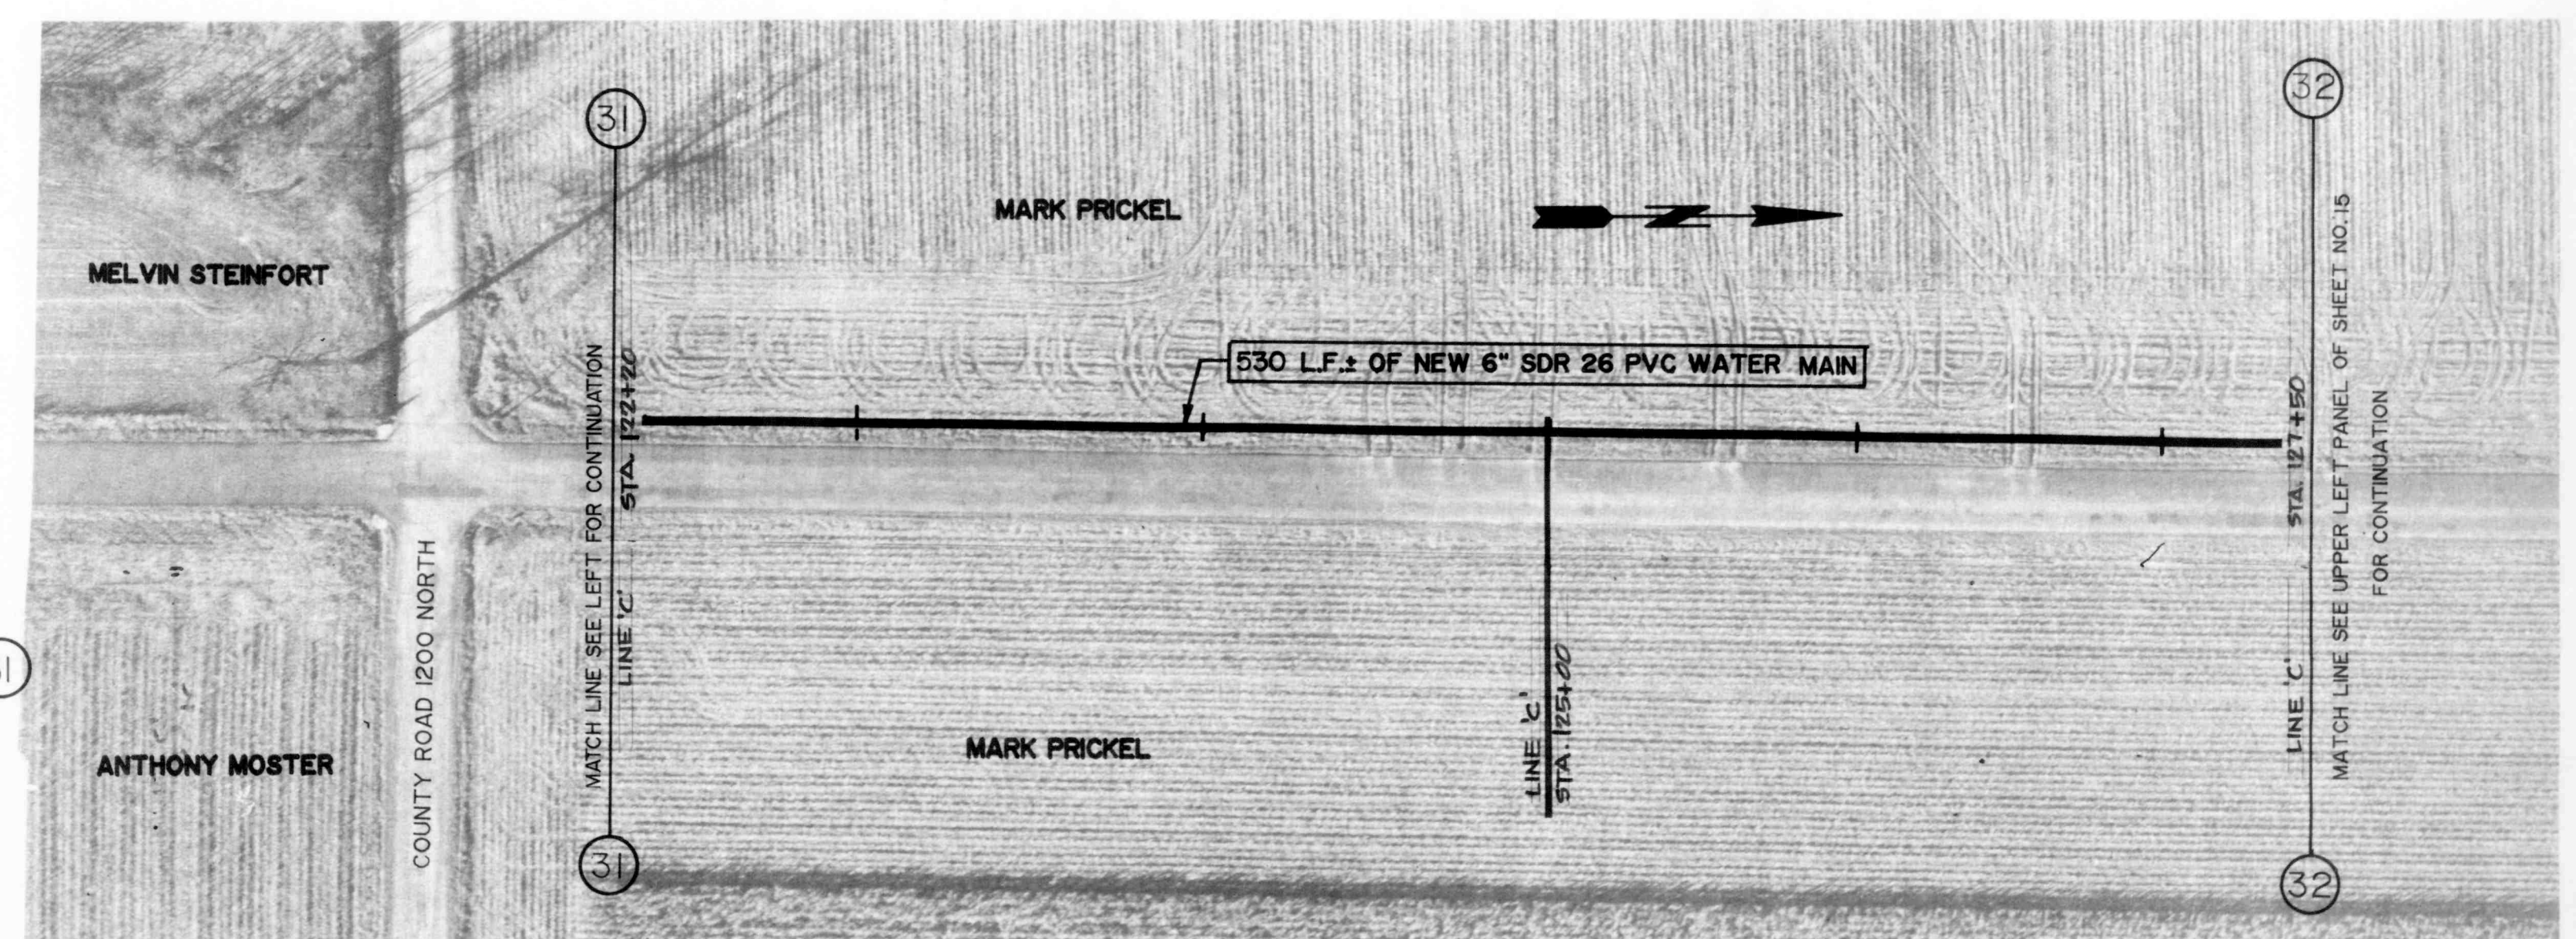

GR. ELEV. 1000±
MAX. STATIC PRES. 69 PSI

COUNTY ROAD 500 EAST

GR. ELEV. 1000±
MAX. STATIC PRES. 69 PSI



DRAWN BY
DATE
CERTIFIED BY
DATE

ROBERT E. CURRY & ASSOCIATES, INC.
CONSULTING ENGINEERS
3346 AVON ROAD
PLAINFIELD, INDIANA 46168

ELROD WATER COMPANY, INC.
RIPLEY COUNTY, INDIANA

WATER MAIN EXTENSIONS
TO
COMMUNITIES OF
CLINTON, SPADES & MORRIS

AS BUILT 10-17-88

JOB NO. SHT. 14
SCALE 1" = 50' OF 24