


GR. ELE. 990±
MAX. STATIC PRES. 73 PSI

COUNTY ROAD 500 EAST

GR. ELE. 970±
MAX. STATIC PRES. 82 PSI

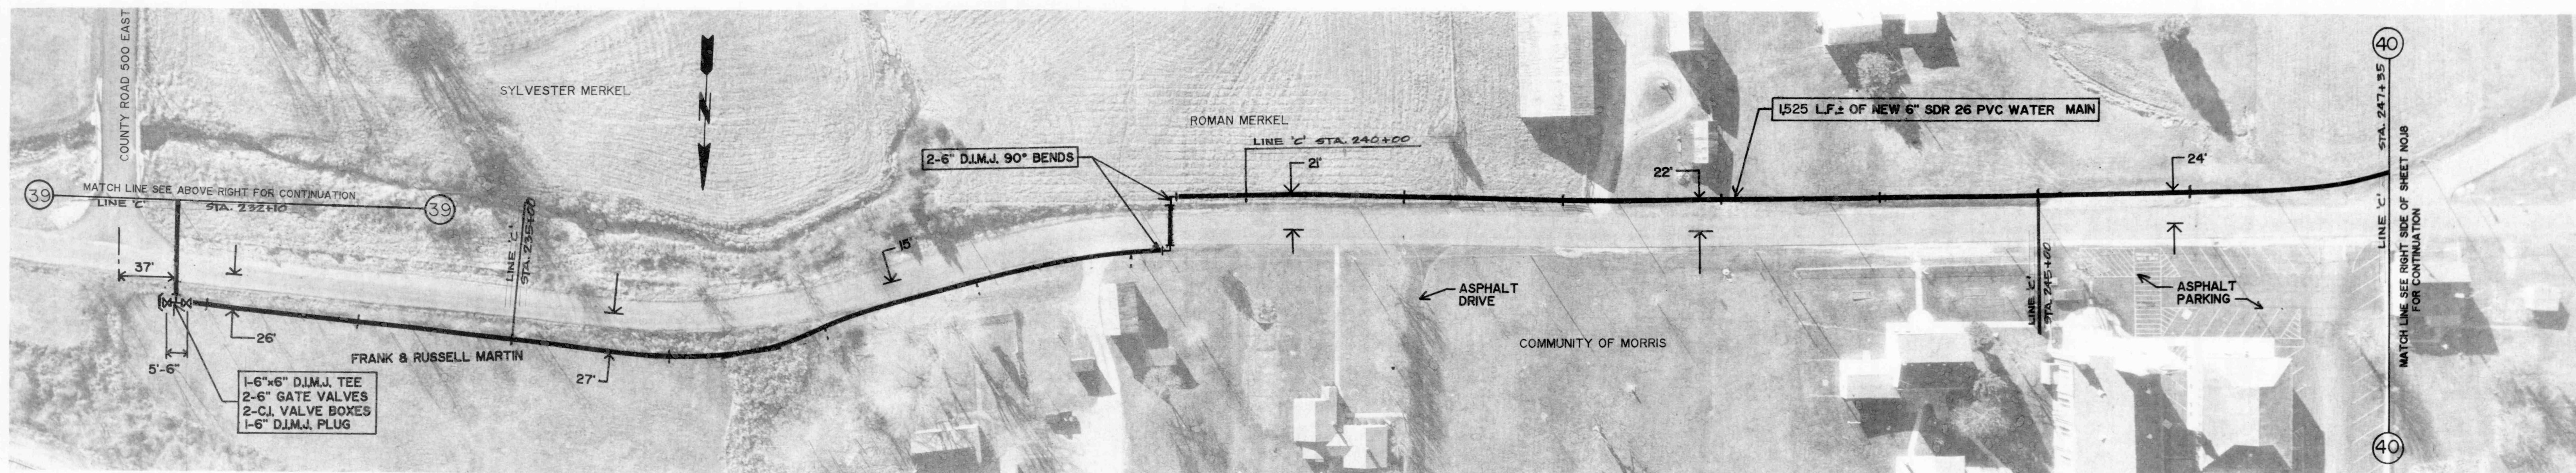

GR. ELE. 970±
MAX. STATIC PRES. 82 PSI

COUNTY ROAD 1400 NORTH

GR. ELE. 980±
MAX. STATIC PRES. 78 PSI



AS BUILT 10-17-88

REVISIONS	DRAWN BY		ROBERT E. CURRY & ASSOCIATES, INC. CONSULTING ENGINEERS 3346 AVON ROAD PLAINFIELD, INDIANA 46168	ELROD WATER COMPANY, INC. RIPLEY COUNTY, INDIANA	WATER MAIN EXTENSIONS TO COMMUNITIES OF CLINTON, SPADES & MORRIS	JOB NO.	SHT.
	DATE						17
	CERTIFIED BY	R.E.C.					
	DATE	4/16/87					24