


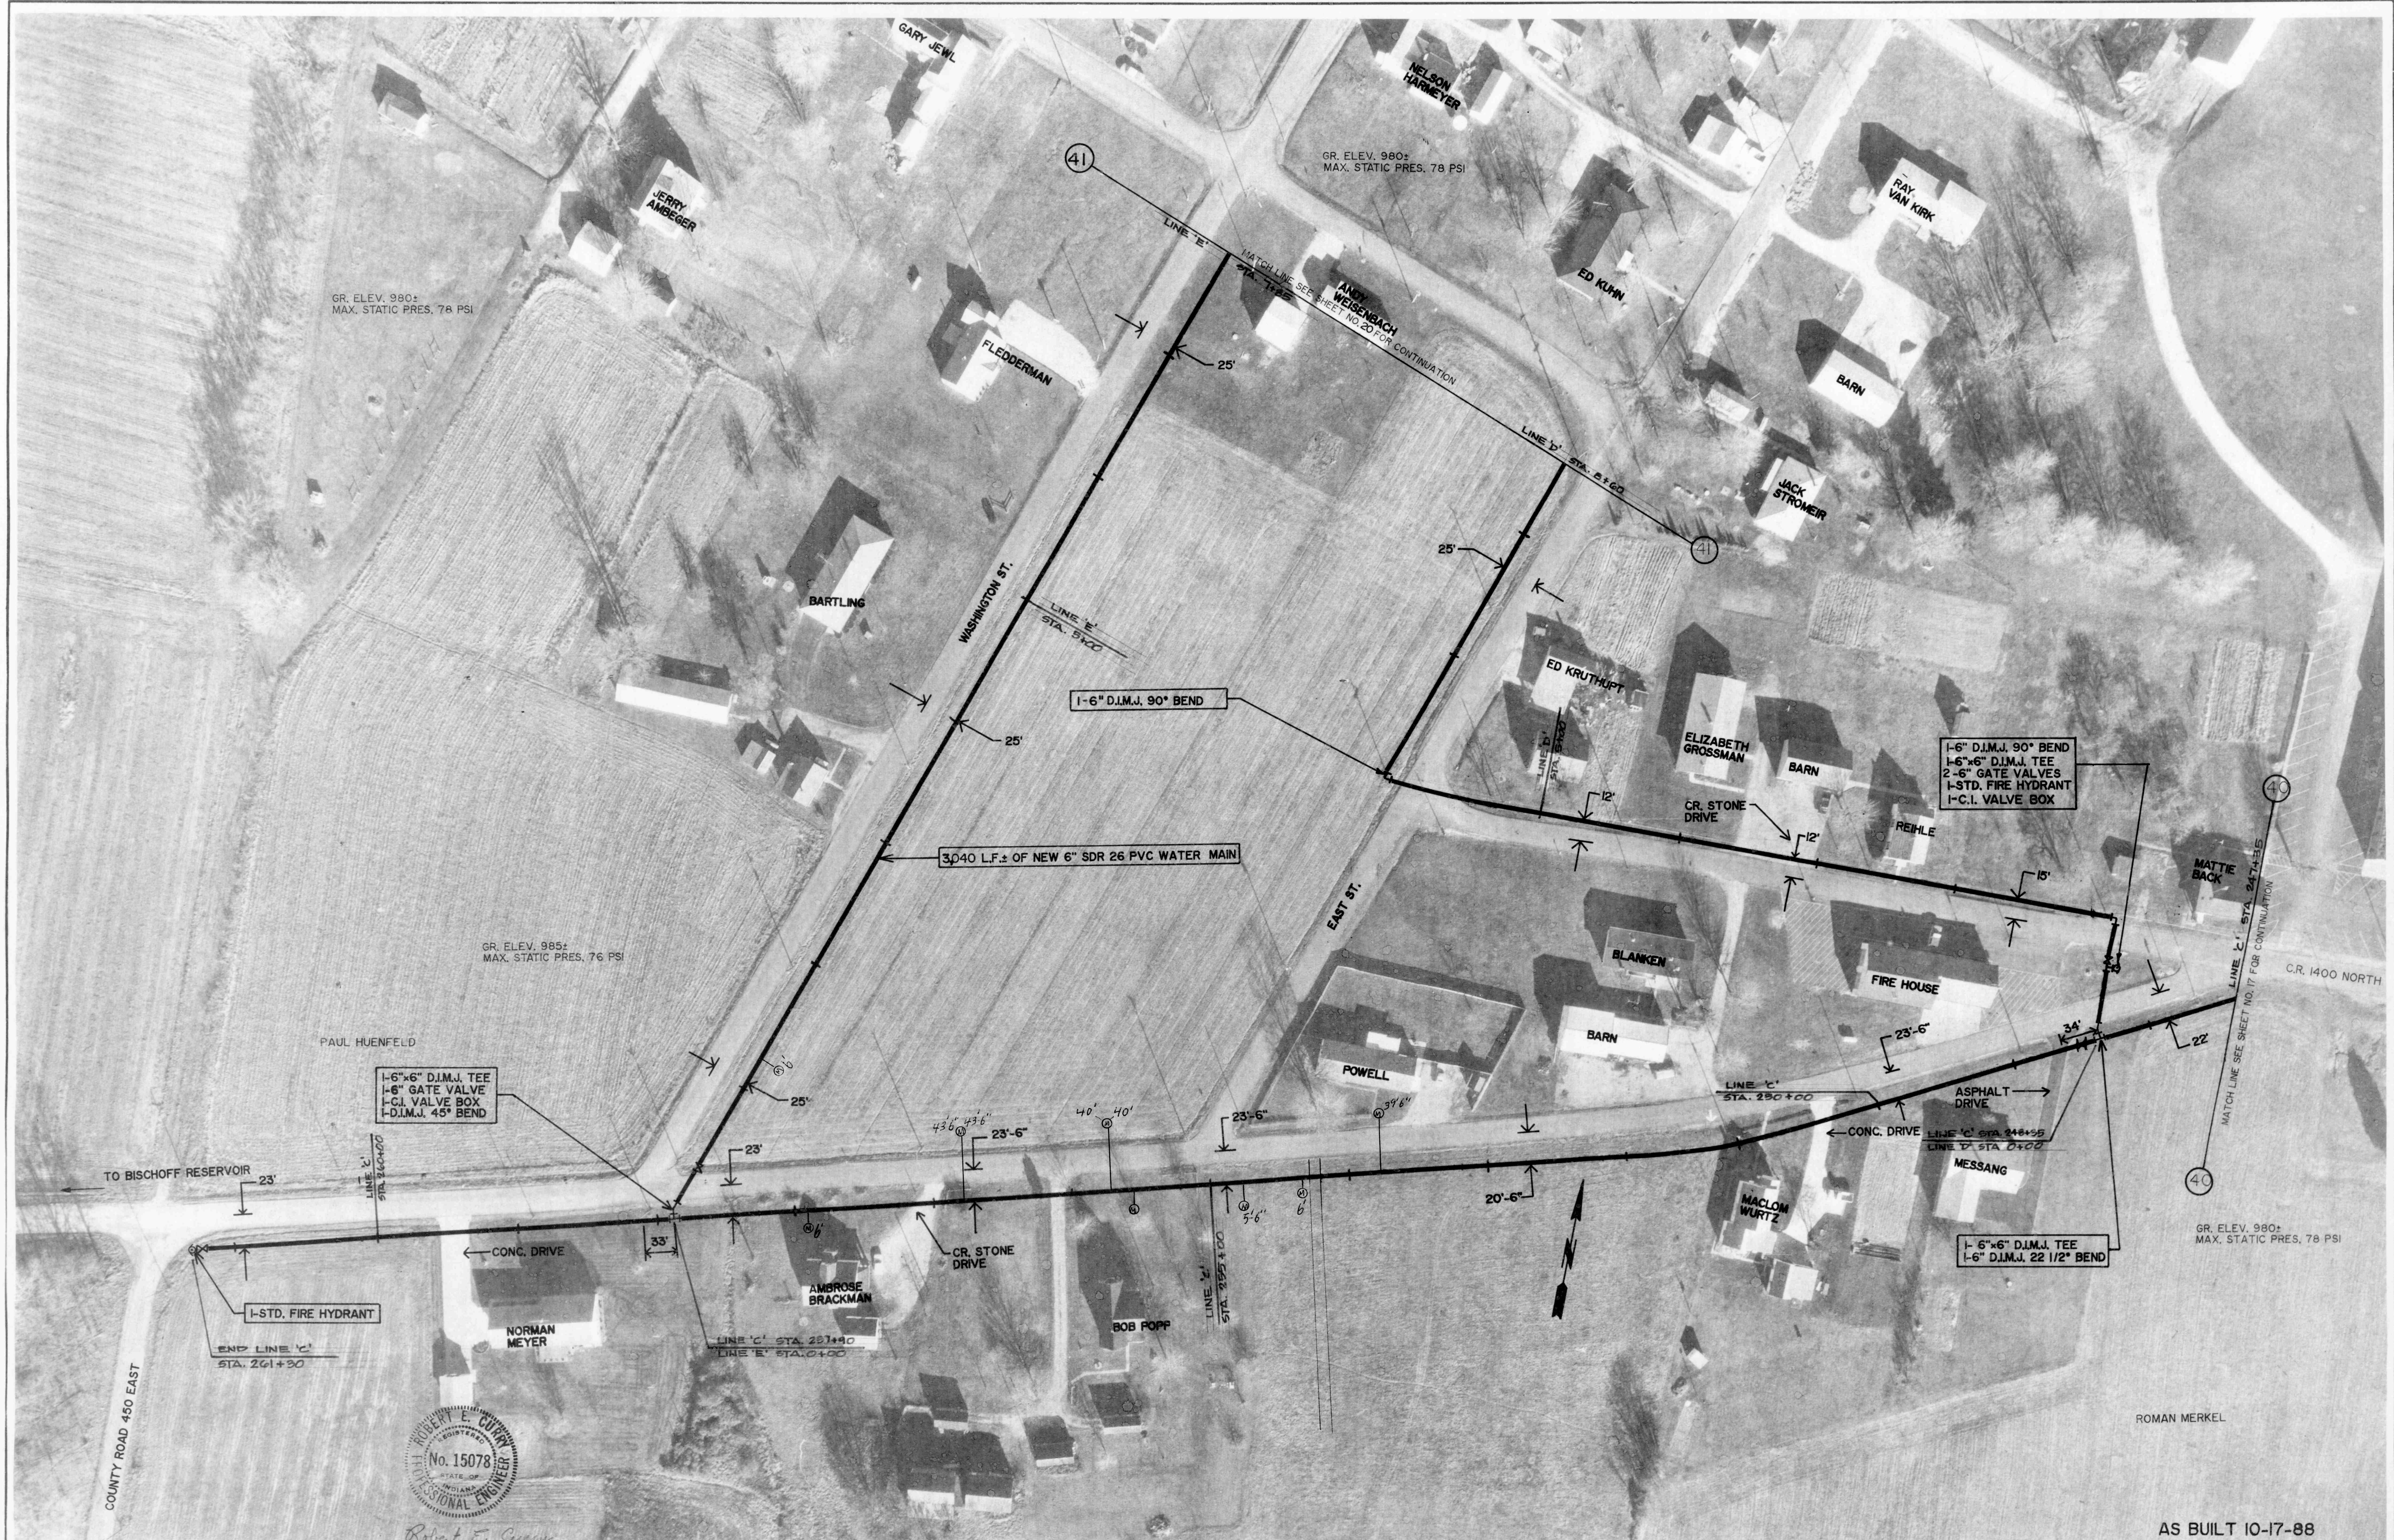

DRAWN BY
 DATE
 CERTIFIED BY *REC*
 DATE *4/15/87*

ROBERT E. CURRY & ASSOCIATES, INC.
 CONSULTING ENGINEERS
 3346 AVON ROAD
 PLAINFIELD, INDIANA 46168

ELROD WATER COMPANY, INC.
 RIPLEY COUNTY, INDIANA

WATER MAIN EXTENSIONS
 TO
 COMMUNITIES OF
 CLINTON, SPADES & MORRIS

AS BUILT 10-17-88

JOB NO.	SHT.
	19
SCALE 1" = 50'	OF 24