


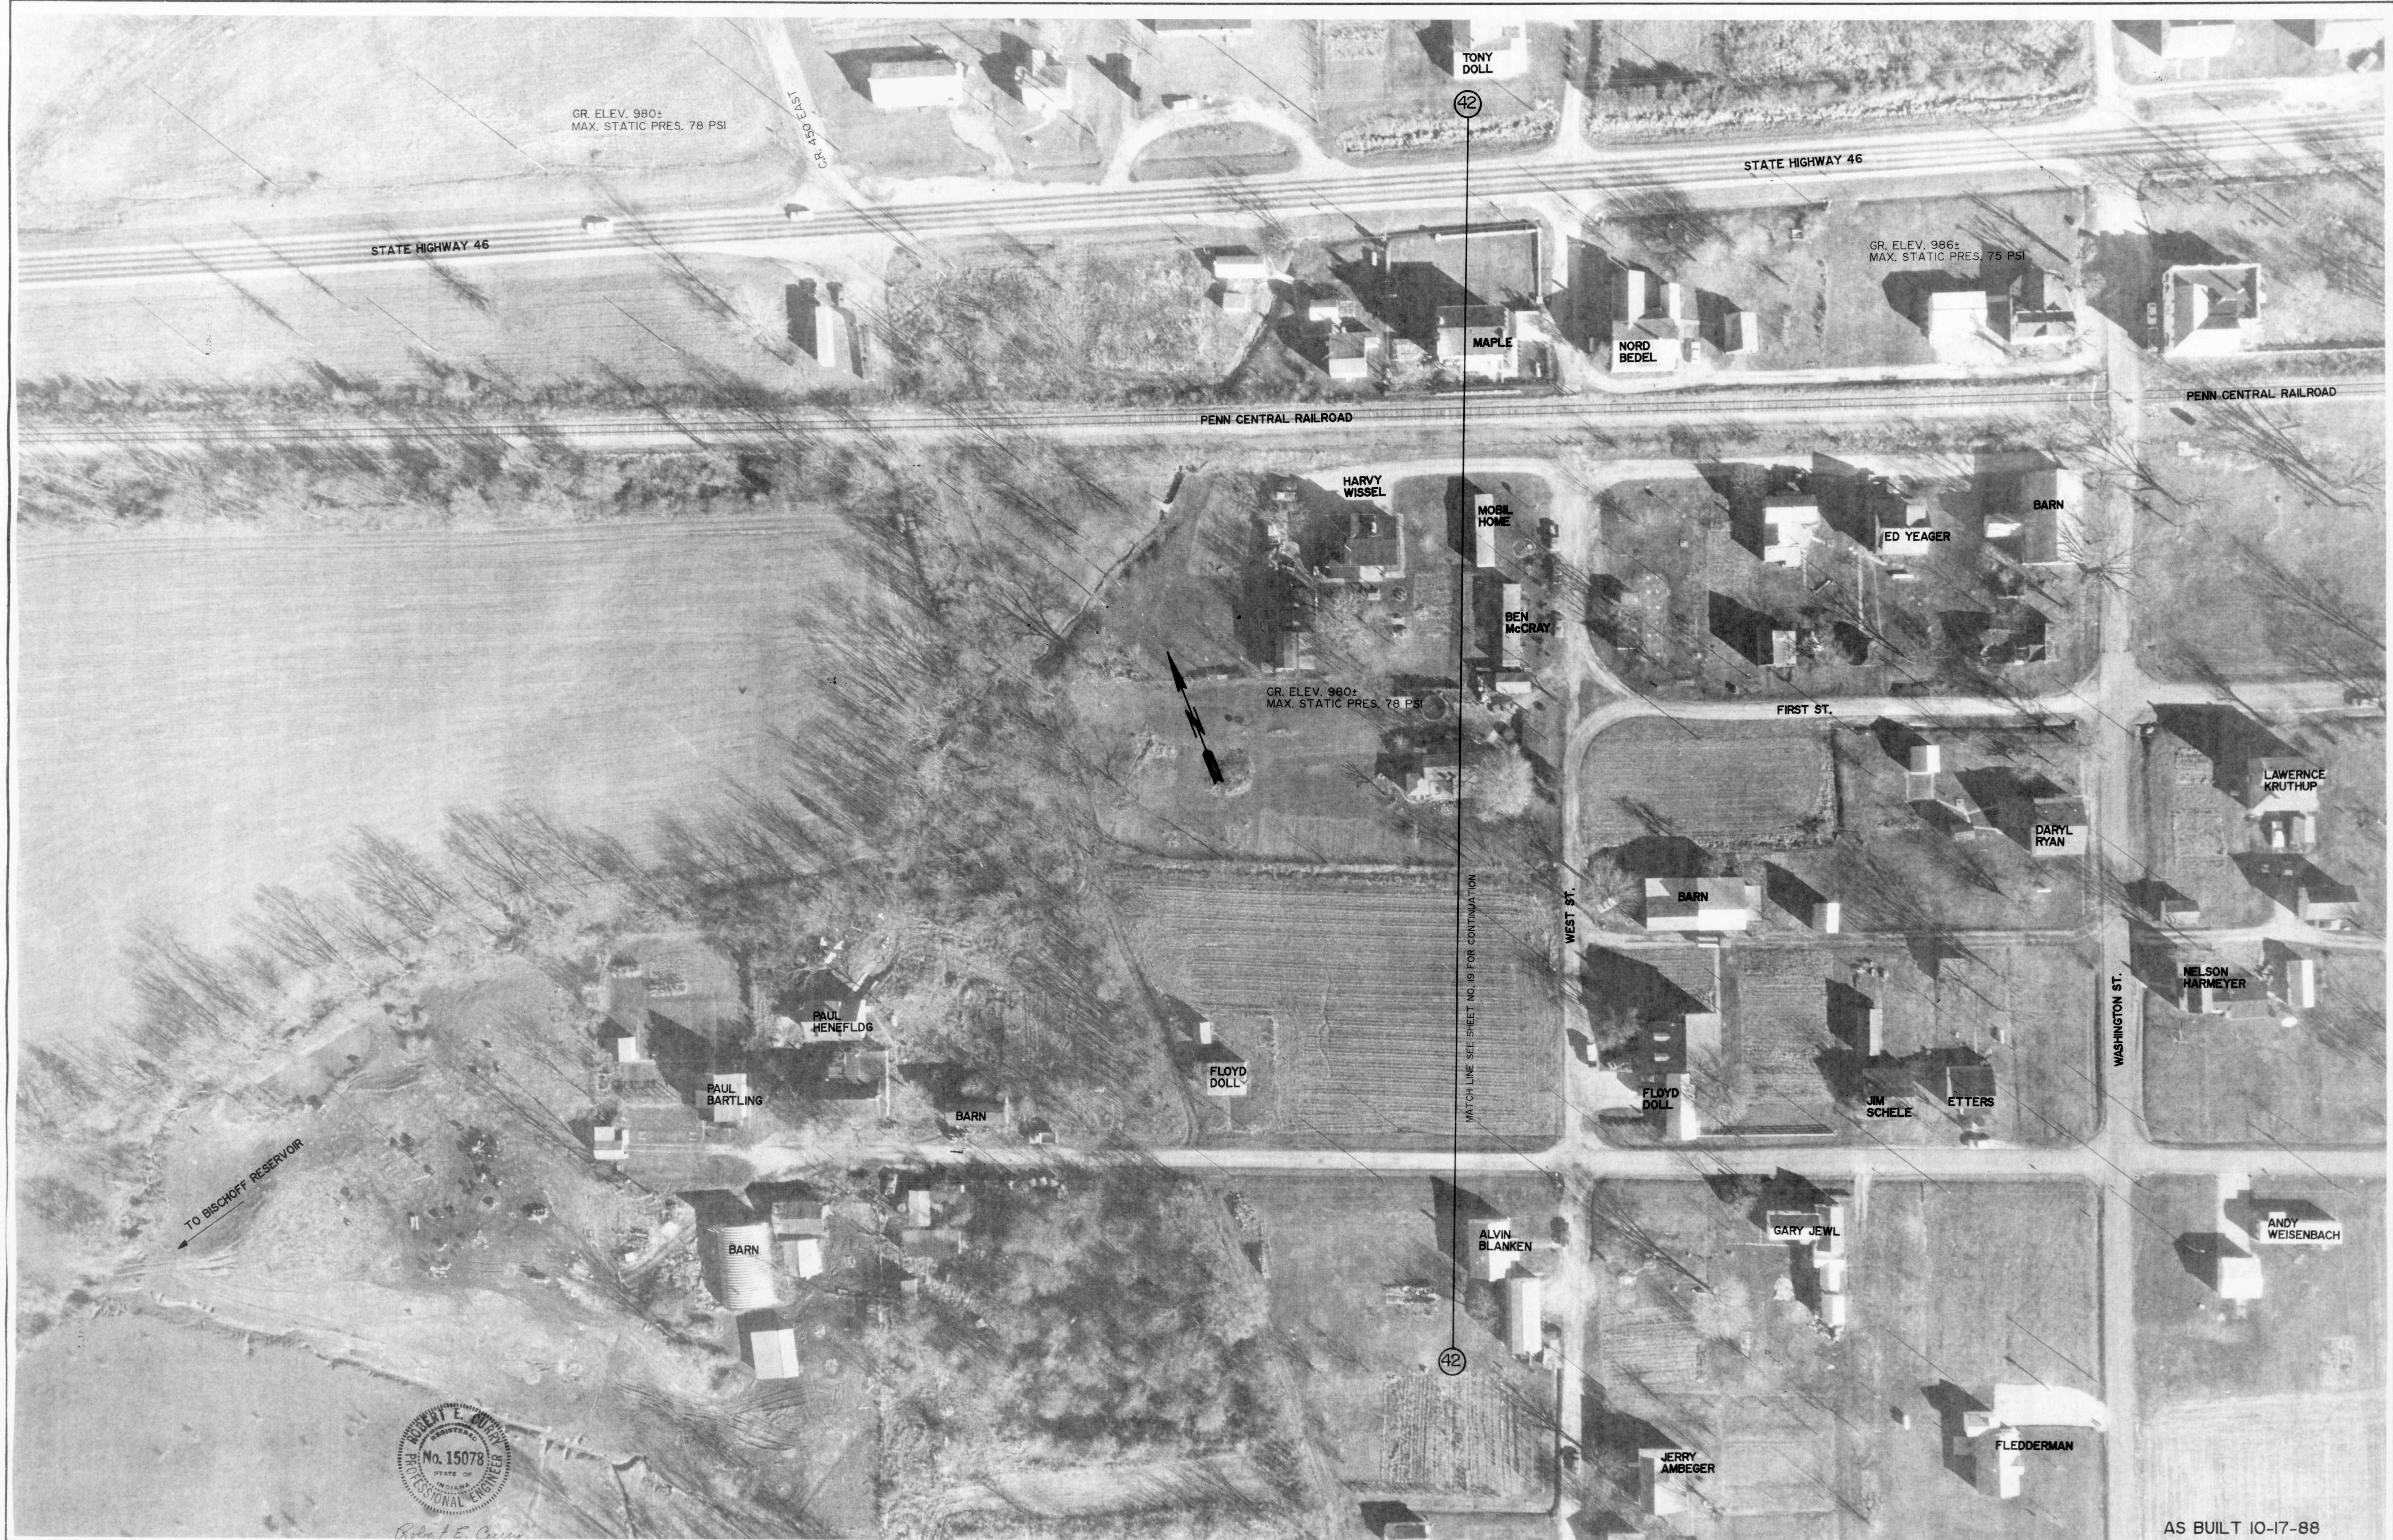

AS BUILT 10-17-88

REVISED	DRAWN BY		ROBERT E. CURRY & ASSOCIATES, INC. CONSULTING ENGINEERS 3346 AVON ROAD PLAINFIELD, INDIANA 46168	ELROD WATER COMPANY, INC. RIPLEY COUNTY, INDIANA	WATER MAIN EXTENSIONS TO COMMUNITIES OF CLINTON, SPADES & MORRIS	JOB NO.	SHT.
	DATE						21
	CERTIFIED BY	REC				SCALE 1" = 50'	OF
	DATE	4/10/88					24