


GR. ELEV. 980±
MAX. STATIC PRES. 78 PSI

GR. ELEV. 970±
MAX. STATIC PRES. 82 PSI

COUNTY ROAD 650 EAST
ST. NICHOLAS RD.

GR. ELEV. 960±
MAX. STATIC PRES. 86 PSI


GR. ELEV. 950±
MAX. STATIC PRES. 91 PSI

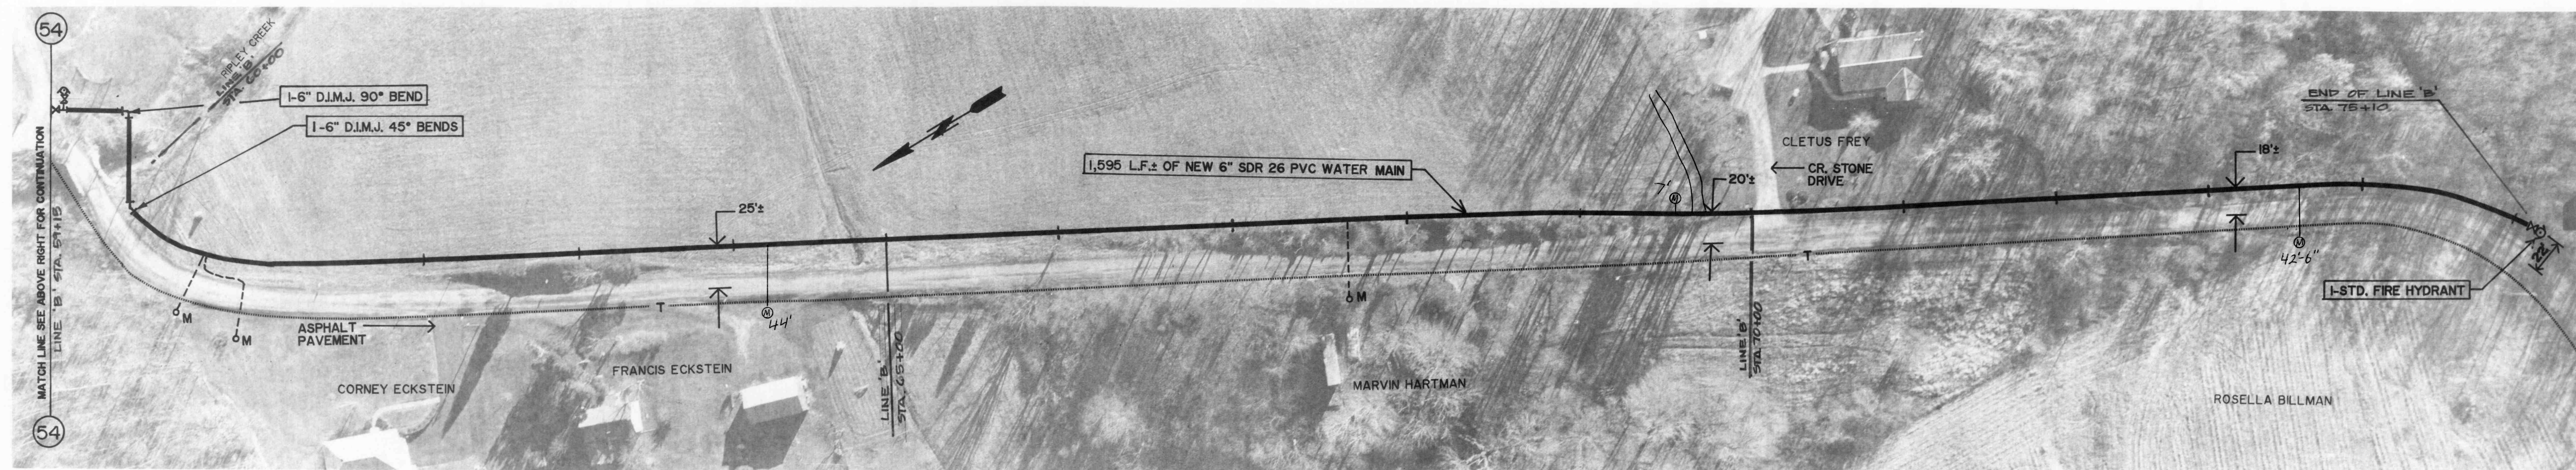

GR. ELEV. 950±
MAX. STATIC PRES. 91 PSI

COUNTY ROAD 650 EAST
ST. NICHOLAS RD.

GR. ELEV. 970±
MAX. STATIC PRES. 82 PSI

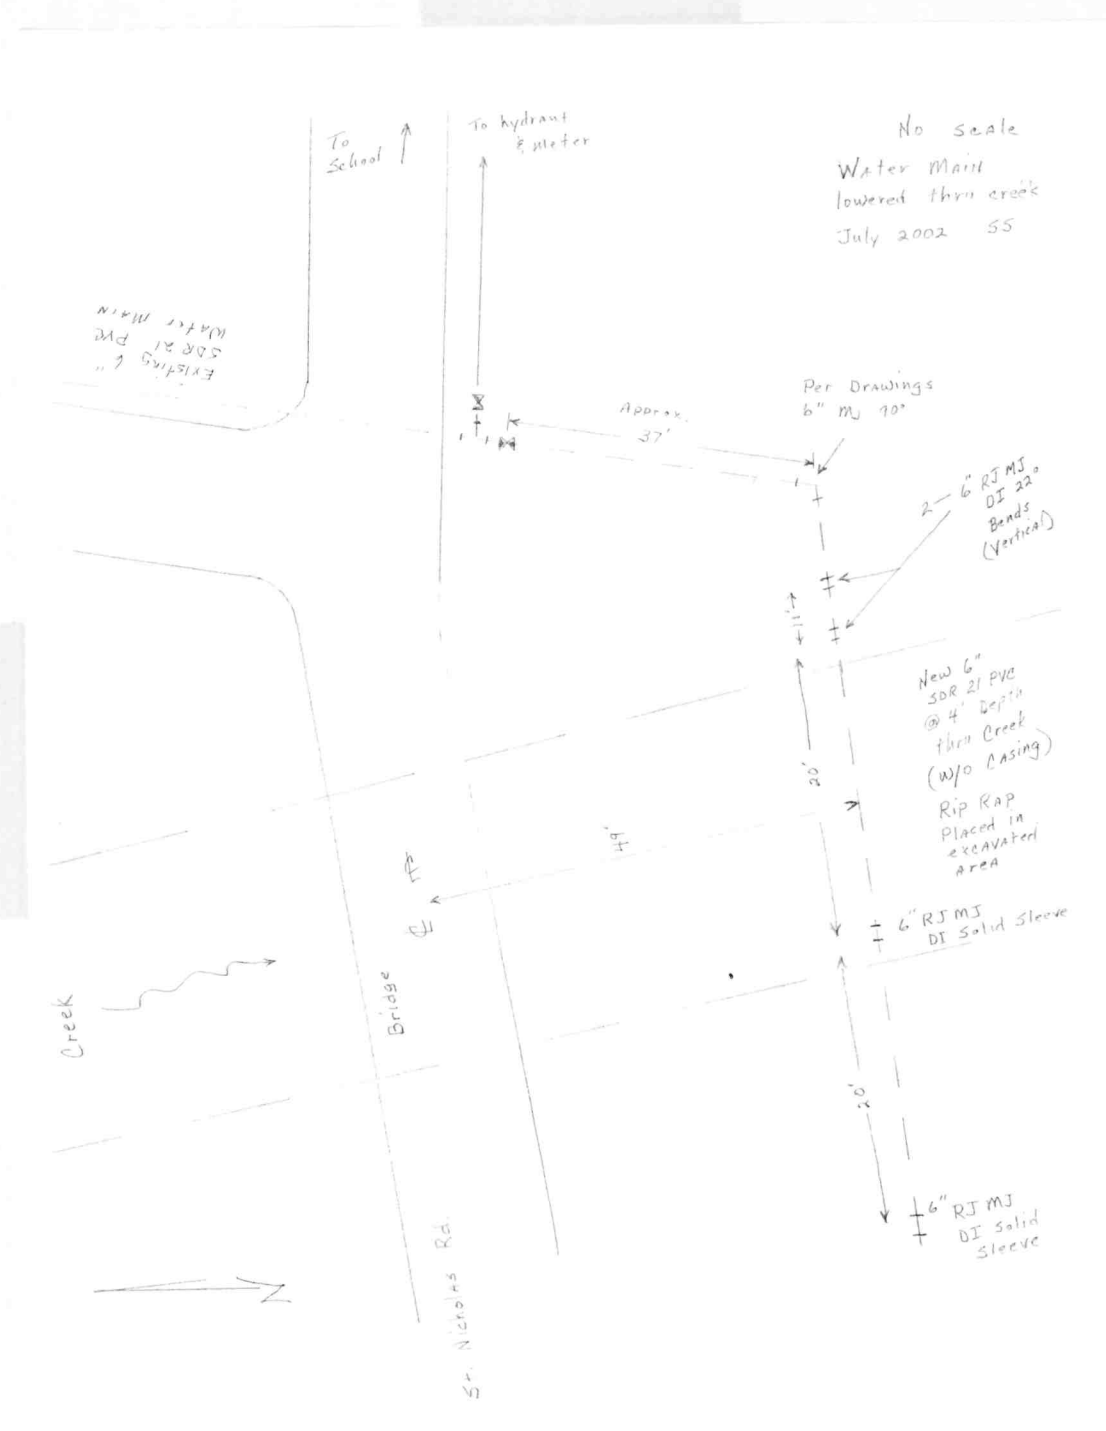

REVISIONS	DRAWN BY DATE CERTIFIED BY DATE	ROBERT E. CURRY & ASSOCIATES, INC. CONSULTING ENGINEERS 3346 AVON ROAD PLAINFIELD, INDIANA 46168	ELROD WATER COMPANY, INC. RIPLEY COUNTY, INDIANA	WATER MAIN EXTENSIONS TO COMMUNITIES OF CLINTON, SPAVES & MORRIS	AS BUILT 10-17-88 JOB NO. SHT. 23 SCALE 1" = 50' OF 24
-----------	--	---	---	---	--