


GR. ELEV. 990±
MAX. STATIC PRES. 73 PSI

SPADES ROAD


GR. ELEV. 993±
MAX. STATIC PRES. 72 PSI

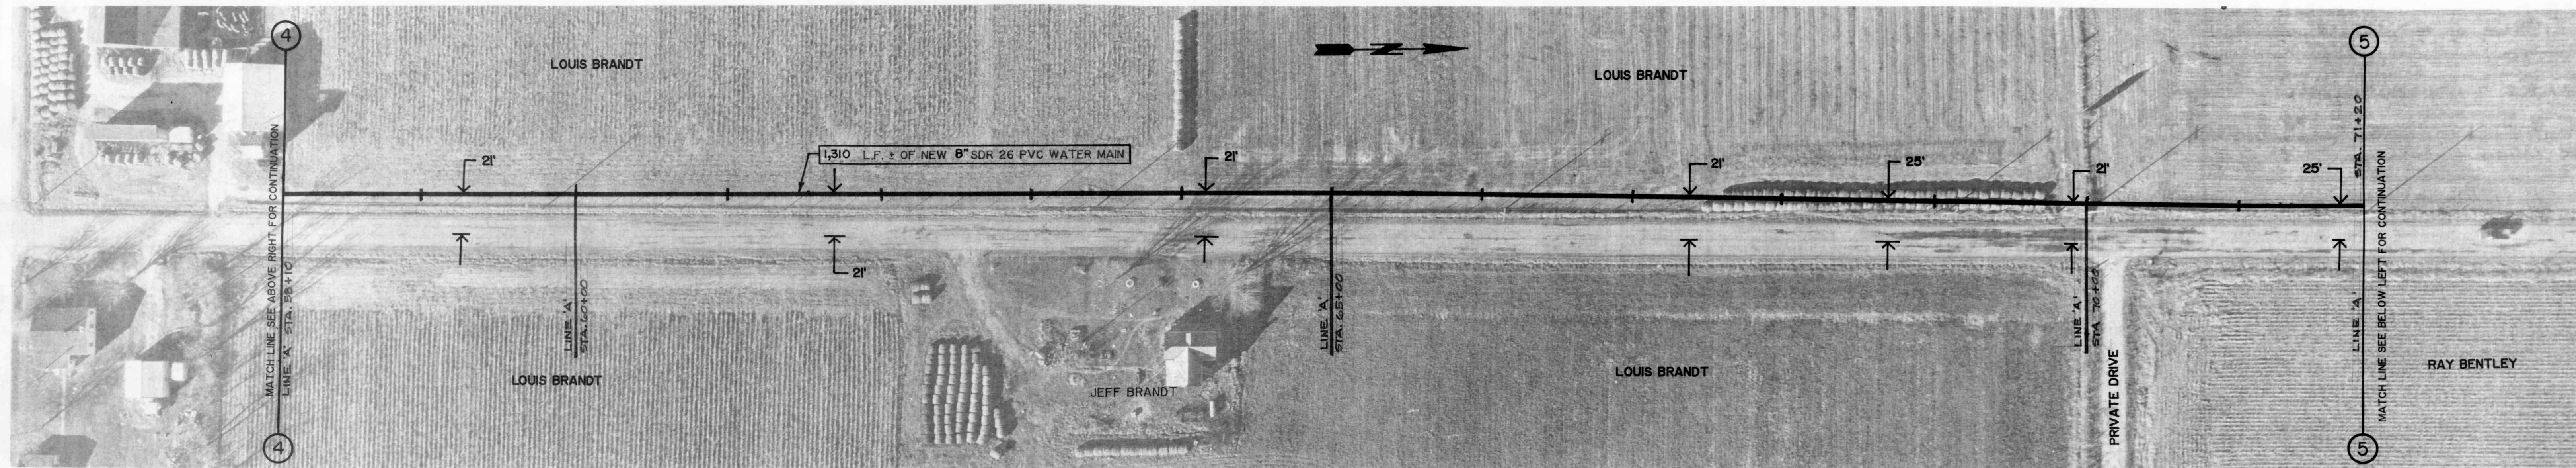

GR. ELEV. 990±
MAX. STATIC PRES. 73 PSI

SPADES ROAD

GR. ELEV. 990±
MAX. STATIC PRES. 73 PSI

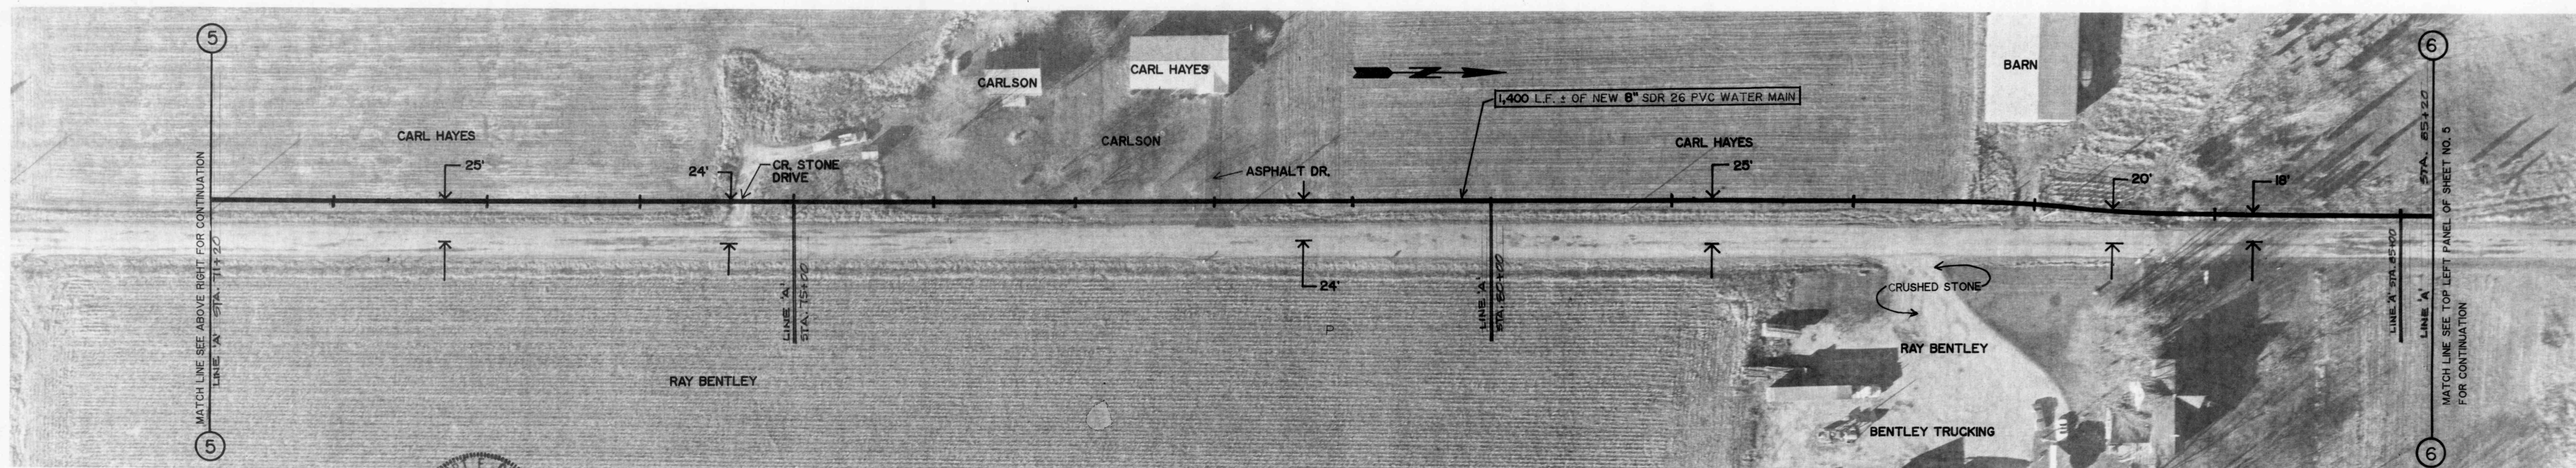

GR. ELEV. 990±
MAX. STATIC PRES. 73 PSI

SPADES ROAD

GR. ELEV. 990±
MAX. STATIC PRES. 73 PSI



AS BUILT 10-17-88

REVISIONS DATE CERTIFIED BY DATE	DRAWN BY DATE CERTIFIED BY DATE	ROBERT E. CURRY & ASSOCIATES, INC. CONSULTING ENGINEERS 3346 AVON ROAD PLAINFIELD, INDIANA 46168	ELROD WATER COMPANY, INC. RIPLEY COUNTY, INDIANA	WATER MAIN EXTENSIONS TO COMMUNITIES OF CLINTON, SPADES & MORRIS	JOB NO. SHT. 4 SCALE 1" = 50' OF 24
---	--	---	---	---	--