


GR. ELEV. 990±
MAX. STATIC PRES. 74 PSI


SPADES ROAD

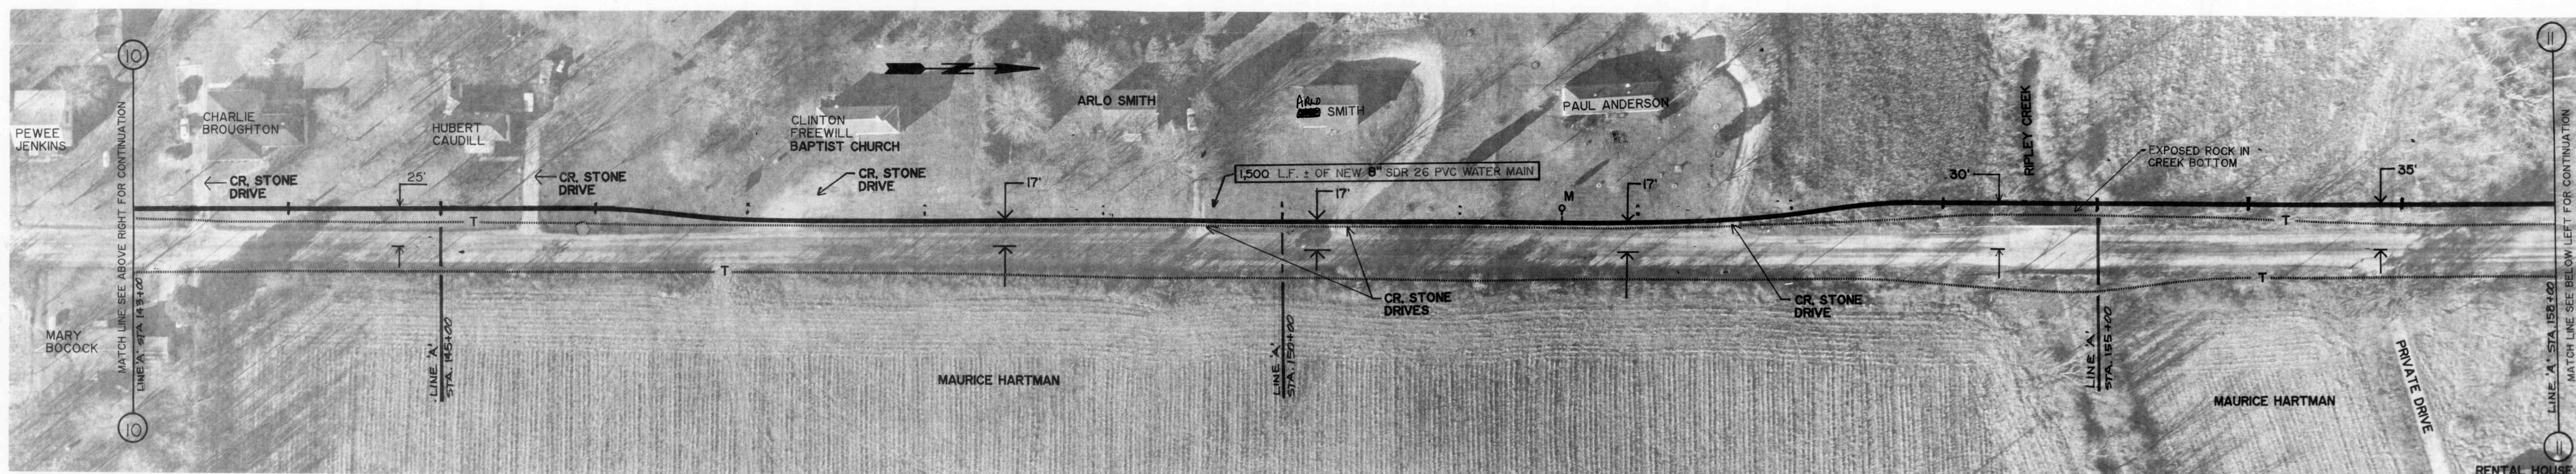

GR. ELEV. 990±
MAX. STATIC PRES. 74 PSI

SPADES ROAD

GR. ELEV. 960±
MAX. STATIC PRES. 87 PSI

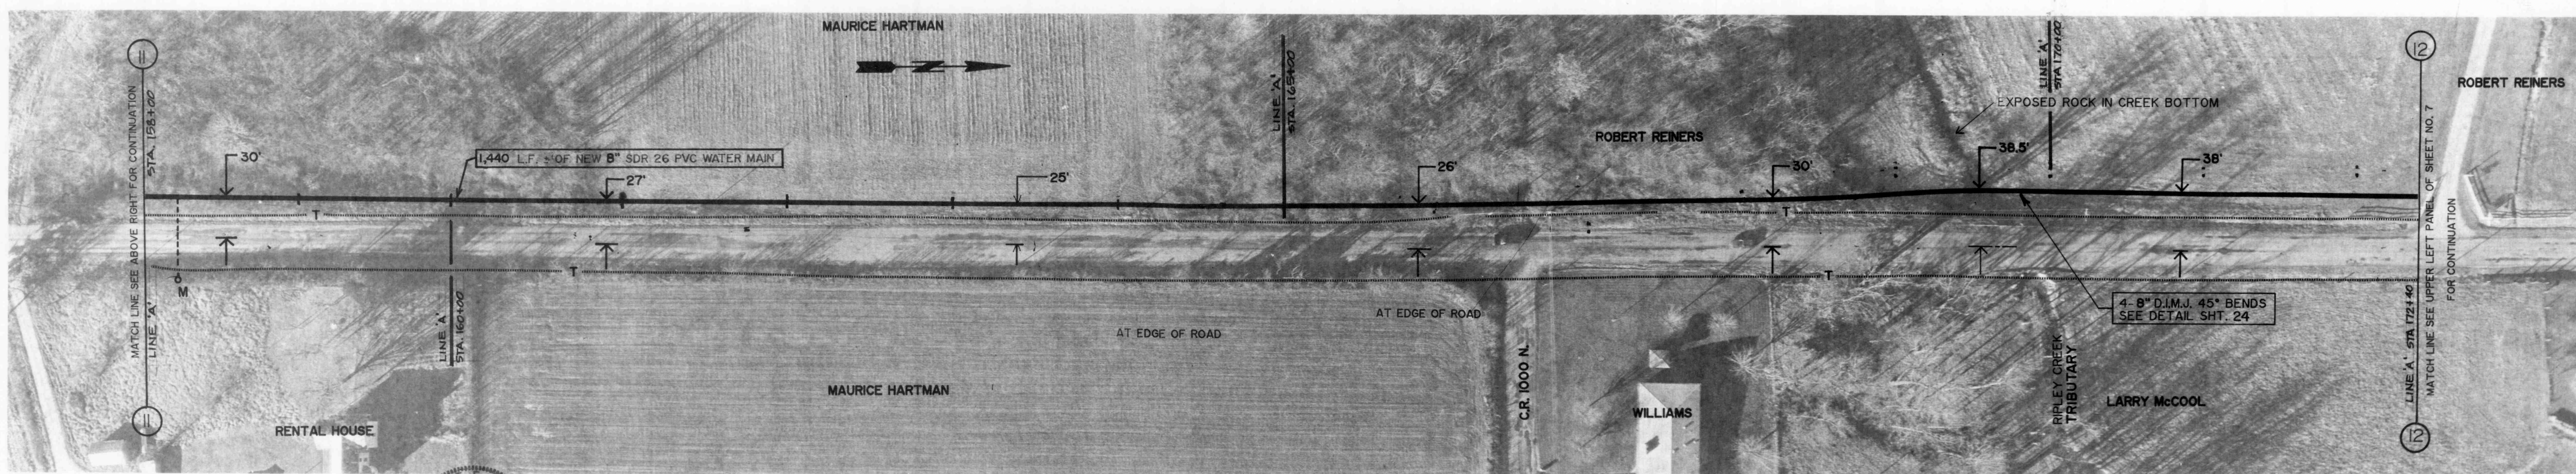

GR. ELEV. 960±
MAX. STATIC PRES. 87 PSI

SPADES ROAD

GR. ELEV. 960±
MAX. STATIC PRES. 87 PSI

AS BUILT 10-17-88



REVISIONS
DRAWN BY
DATE
CERTIFIED BY
DATE

ROBERT E. CURRY & ASSOCIATES, INC.
CONSULTING ENGINEERS
3346 AVON ROAD
PLAINFIELD, INDIANA 46168

ELROD WATER COMPANY, INC.
RIPLEY COUNTY, INDIANA

WATER MAIN EXTENSIONS
TO
COMMUNITIES OF
CLINTON, SPADES & MORRIS

JOB NO. SHT. 6
SCALE 1" = 50' OF 24