


GR. ELEV. 960±
MAX. STATIC PRES. 87 PSI

SPADES ROAD

GR. ELEV. 990±
MAX. STATIC PRES. 73 PSI

GR. ELEV. 990±
MAX. STATIC PRES. 73 PSI

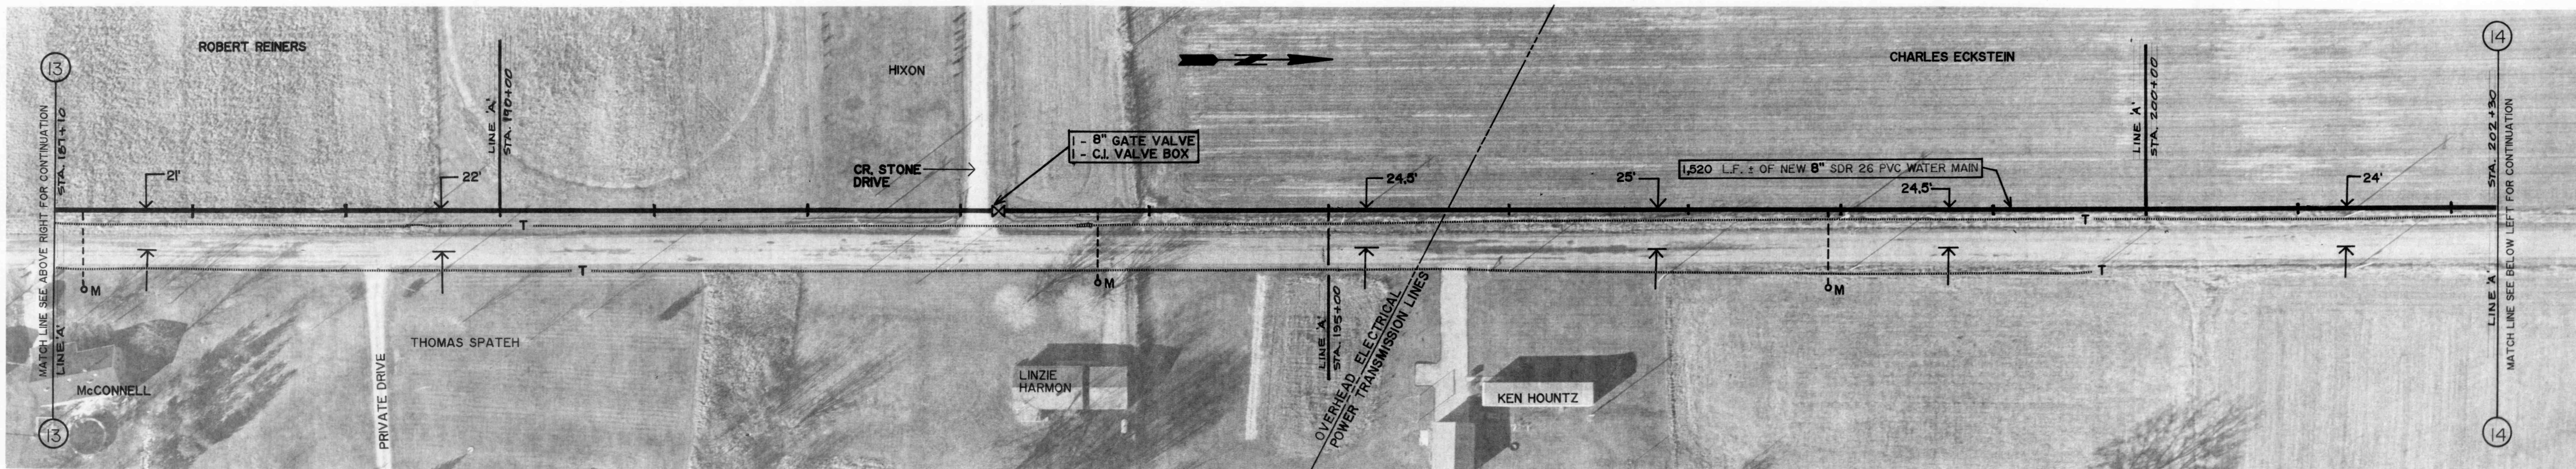


GR. ELEV. 990±
MAX. STATIC PRES. 73 PSI

SPADES ROAD

GR. ELEV. 1000±
MAX. STATIC PRES. 69 PSI

GR. ELEV. 1000±
MAX. STATIC PRES. 69 PSI

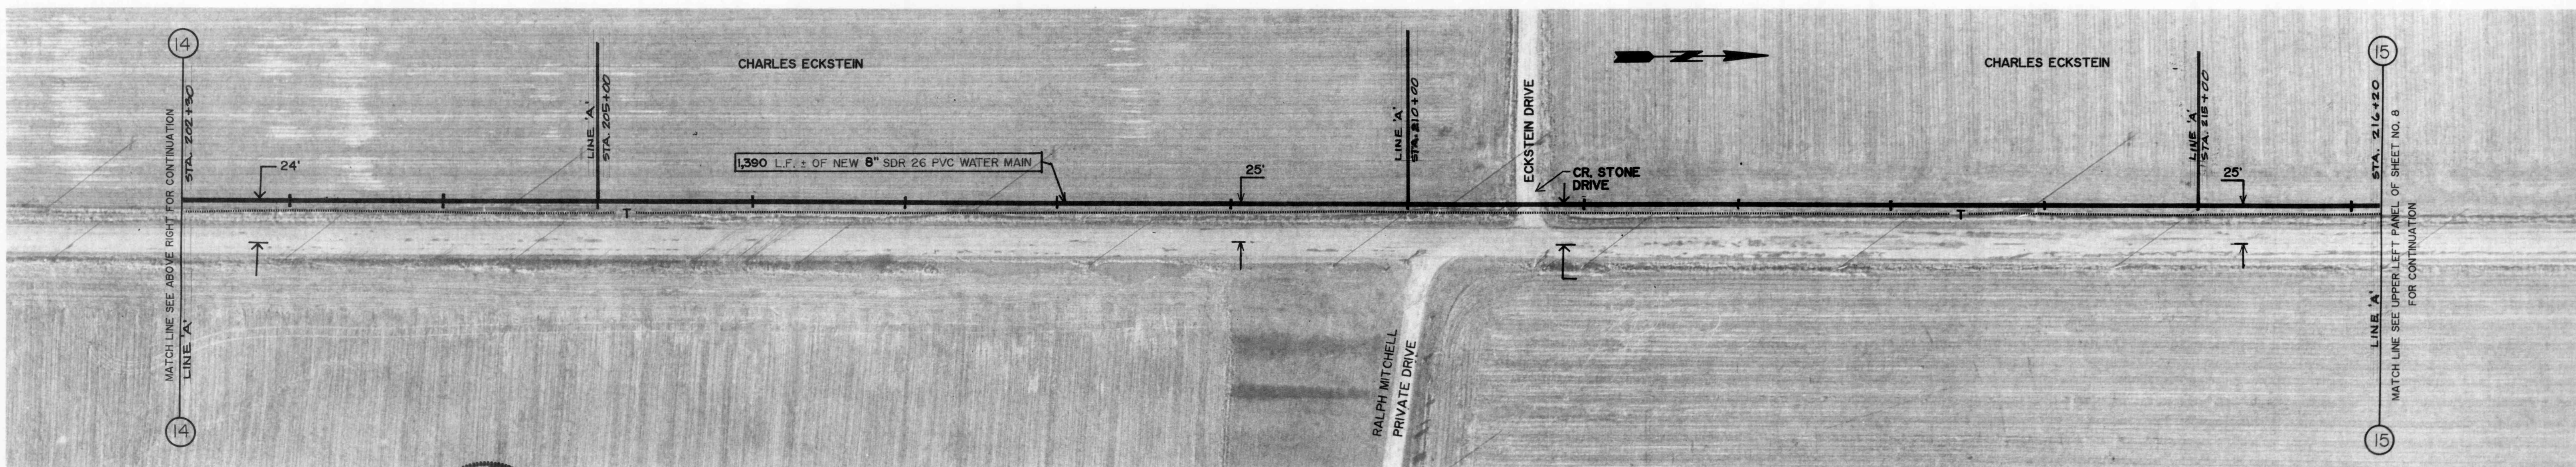

GR. ELEV. 1000±
MAX. STATIC PRES. 69 PSI

SPADES ROAD

GR. ELEV. 1000±
MAX. STATIC PRES. 69 PSI



ROBERT E. CURRY & ASSOCIATES, INC.
CONSULTING ENGINEERS
3346 AVON ROAD
PLAINFIELD, INDIANA 46168

ELROD WATER COMPANY, INC.
RIPLEY COUNTY, INDIANA

WATER MAIN EXTENSIONS
TO
COMMUNITIES OF
CLINTON, SPADES & MORRIS

AS BUILT 10-17-88

JOB NO.	SHT.
SCALE 1" = 50'	OF 24