


GR. ELEV. 1000±
MAX. STATIC PRES. 69 PSI

GR. ELEV. 1005±
MAX. STATIC PRES. 67 PSI

SPADES ROAD


GR. ELEV. 1000±
MAX. STATIC PRES. 69 PSI

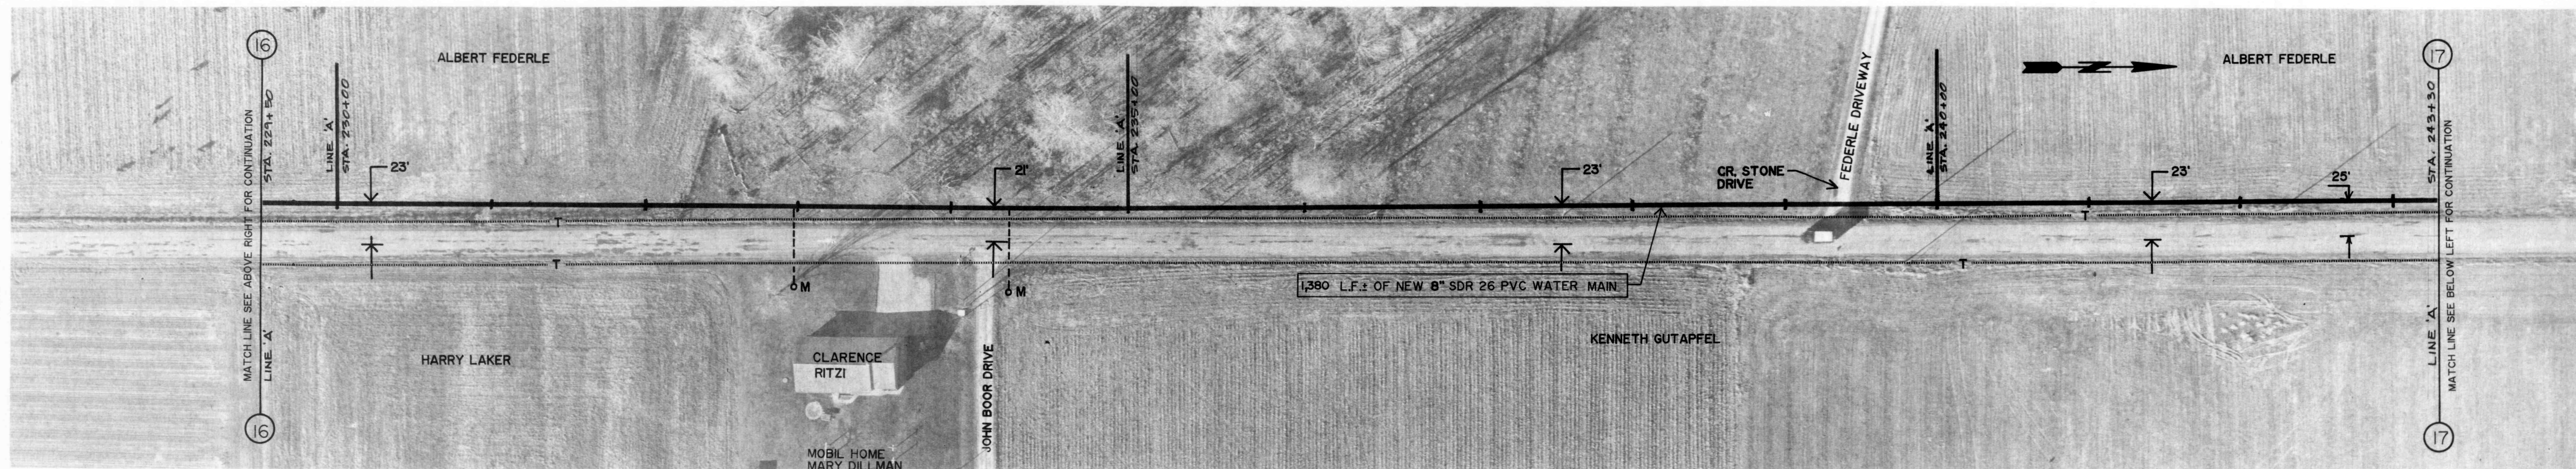

GR. ELEV. 1010±
MAX. STATIC PRES. 65 PSI

SPADES ROAD

GR. ELEV. 1010±
MAX. STATIC PRES. 65 PSI

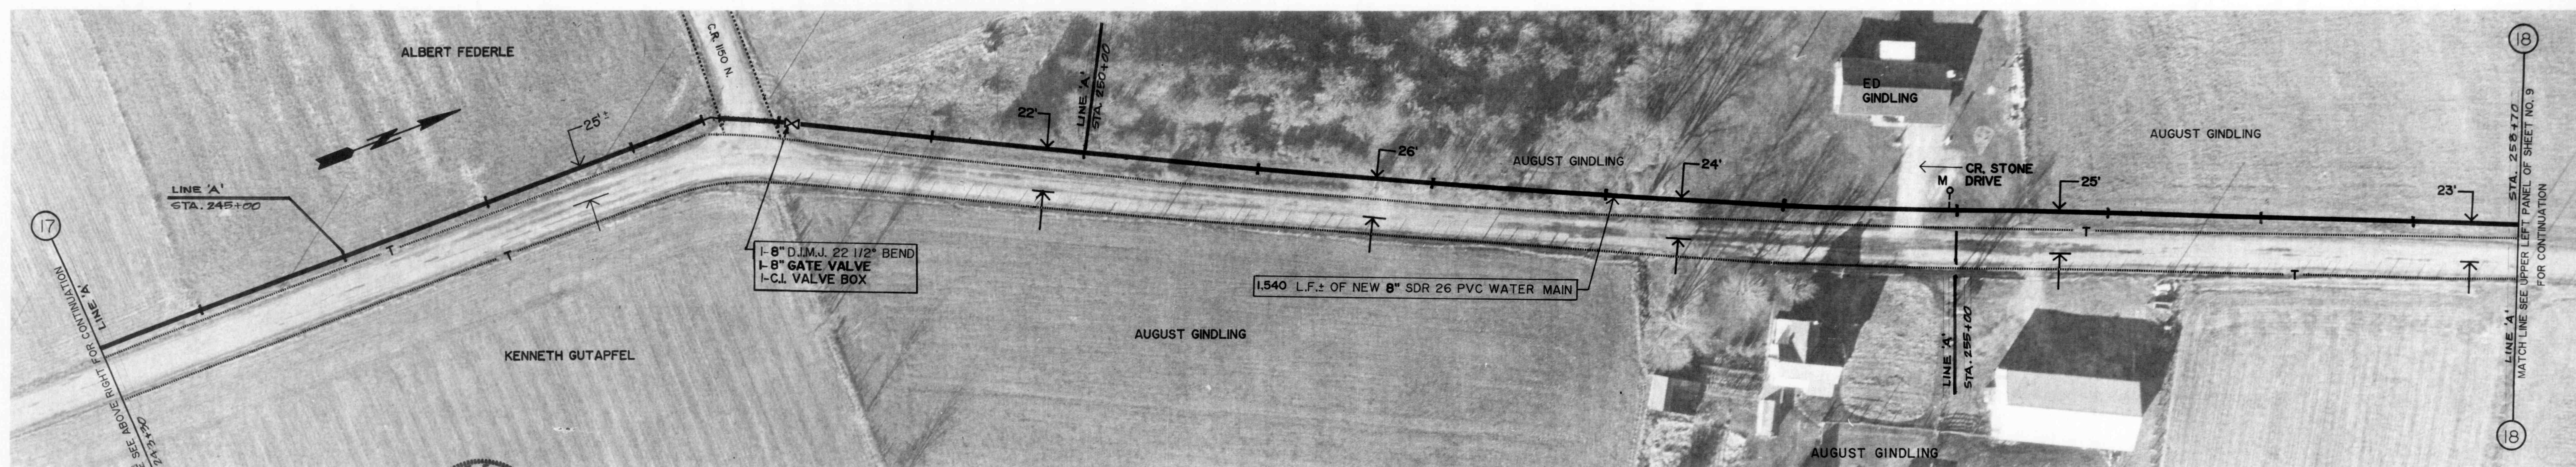

GR. ELEV. 1011±
MAX. STATIC PRES. 64 PSI

SPADES ROAD



AS BUILT 10-17-88

DRAWN BY	
DATE	
CERTIFIED BY	
DATE	

ROBERT E. CURRY & ASSOCIATES, INC.
CONSULTING ENGINEERS
3346 AVON ROAD
PLAINFIELD, INDIANA 46168

ELROD WATER COMPANY, INC.
RIPLEY COUNTY, INDIANA

WATER MAIN EXTENSIONS
TO
COMMUNITIES OF
CLINTON, SPADES & MORRIS

JOB NO.	SHT.
SCALE 1" = 50'	OF 24