


ELROD WATER COMPANY, INC. WATERWORKS IMPROVEMENTS

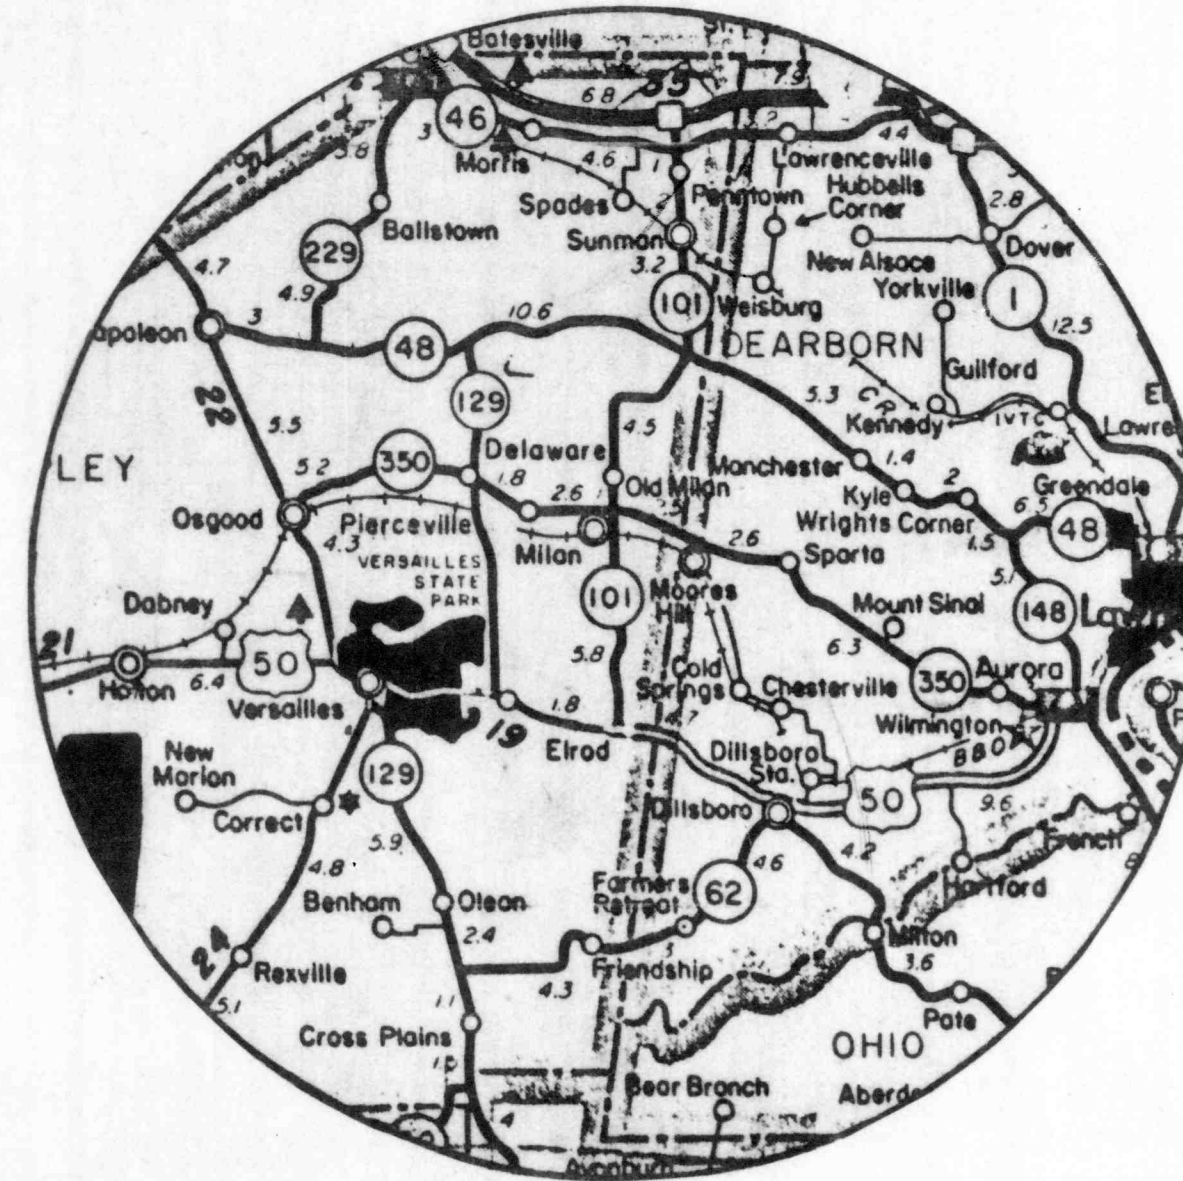

VICINITY PLAN

SCALE 1" = 5 MILES

DIVISION C WATER MAIN EXTENSIONS

ENGINEER

ROBERT E. CURRY & ASSOCIATES, INC.
ENGINEERS & ARCHITECTS
3346 AVON ROAD
PLAINFIELD, IN, 46168

AS BUILT 10-17-90

BOARD MEMBERS

| | |
|-------------------------------------|-----------------------------|
| ROBERT C. EVERAGE, PRESIDENT | JOYCE HUFFMAN, VICE - PRES. |
| HENRY WESTERMAN, TREASURER | ARLEENA NICKULIS, SECRETARY |
| ED ALLGEIER, MEMBER | DANIEL SCHMALTZ, MEMBER |
| JEFFERY LAUB, MEMBER | NELSON ELLIOTT, MEMBER |
| FRANK MARTIN, MEMBER | MARY ENGEL, OFFICE MGR. |
| JEFF MEINDERS, WATER SUPERINTENDENT | |