


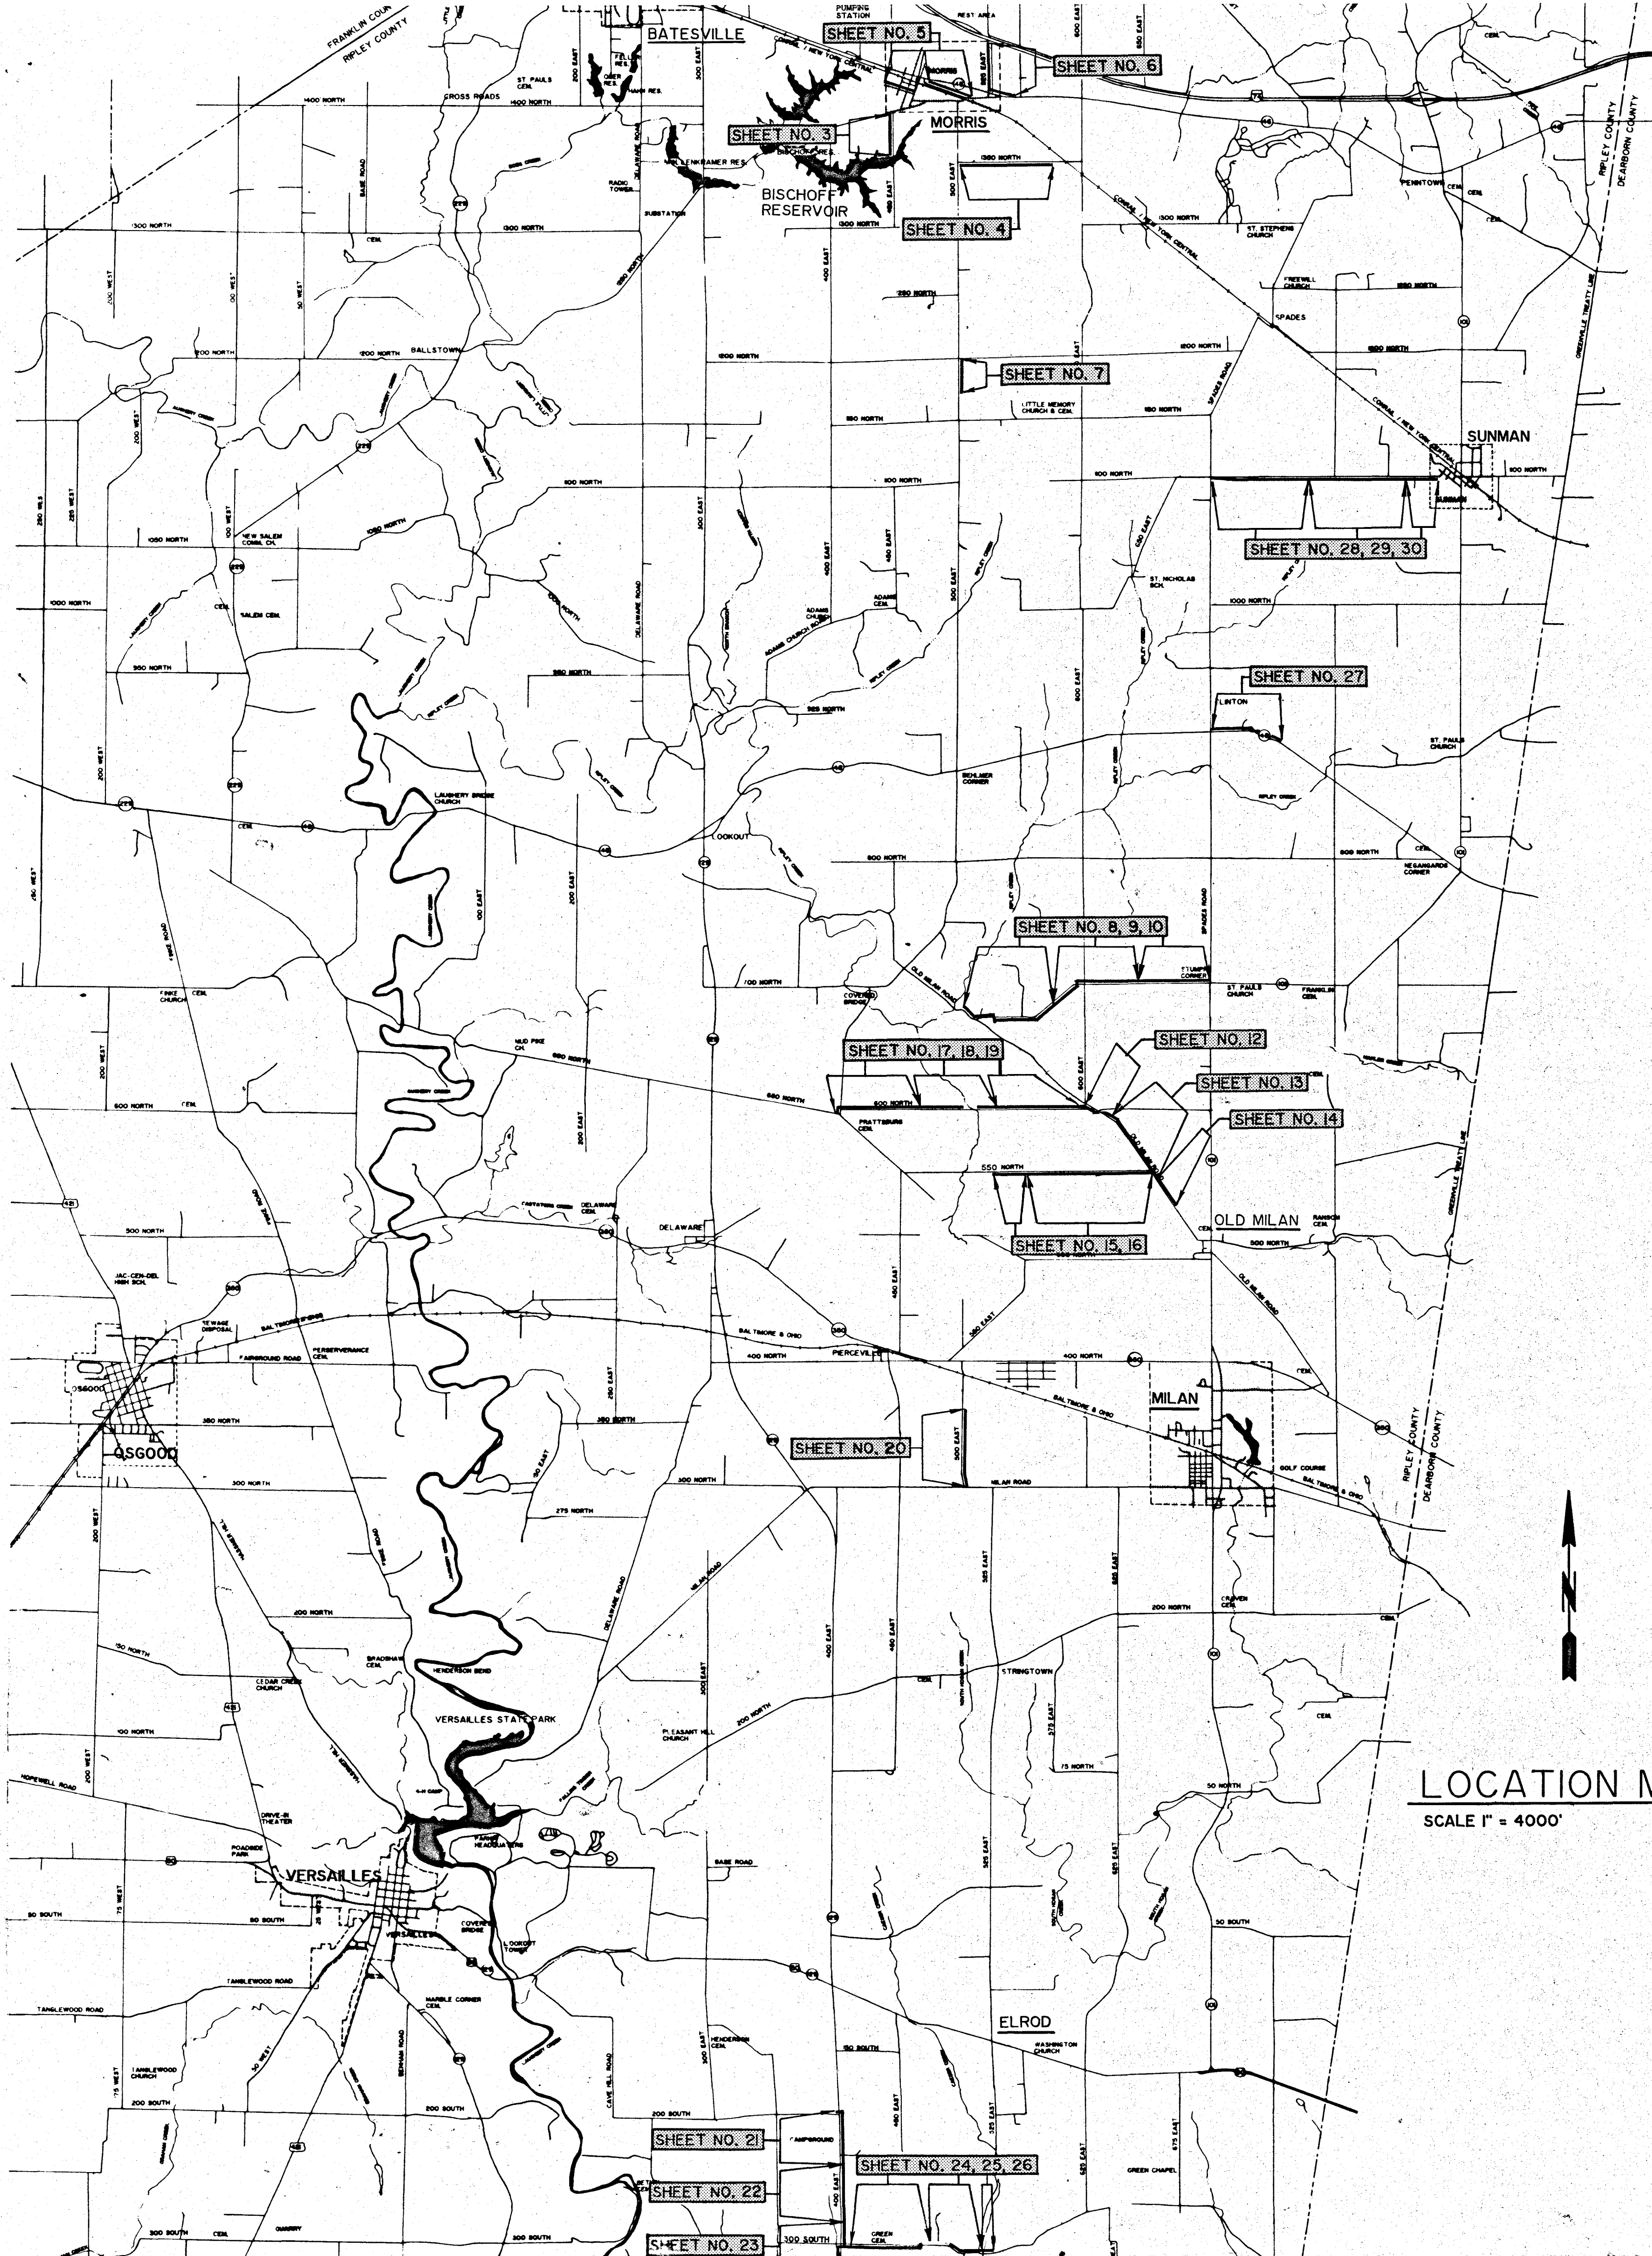

C.R. 650 EAST

INDEX	
SHEET NO.	DESCRIPTION
1	COVER SHEET
2	LOCATION MAP, INDEX, AND LEGEND
3	C. R. 450 EAST BEGINNING AT C. R. 1400 NORTH
4	C. R. 1350 NORTH BEGINNING AT C. R. 500 EAST
5	SECOND STREET IN THE TOWN OF MORRIS
6	RAILROAD AVENUE IN THE TOWN OF MORRIS
7	S. R. 45 & C. R. 525 EAST
8	C. R. 500 EAST BEGINNING AT C. R. 1200 NORTH
9	C. R. 700 NORTH
10	C. R. 700 NORTH BEGINNING AT S. R. 101
11	OLD MILAN ROAD DELETED FROM PROJECT
12	OLD MILAN ROAD
13	OLD MILAN ROAD
14	OLD MILAN ROAD
15	C. R. 500 NORTH BEGINNING AT OLD MILAN ROAD
16	C. R. 500 NORTH
17	C. R. 600 NORTH
18	C. R. 600 NORTH
19	C. R. 600 NORTH BEGINNING AT OLD MILAN ROAD
20	C. R. 500 EAST BEGINNING AT MILAN ROAD
21	C. R. 400 EAST
22	C. R. 400 EAST
23	C. R. 400 EAST BEGINNING AT C. R. 200 SOUTH
24	C. R. 300 SOUTH BEGINNING AT C. R. 400 EAST
25	C. R. 300 SOUTH
26	C. R. 475 EAST BEGINNING AT 300 SOUTH
27	C. R. 300 SOUTH
28	S. R. 48 BEGINNING AT SPADES ROAD
29	C. R. 1100 NORTH BEGINNING AT SPADES ROAD
30	C. R. 1100 NORTH
31	STANDARD DETAILS

LEGEND

SYMBOL	ITEM
	BENDS
	VALVE
	REDUCER
	TEE OR TAPPING SLEEVE (SEE NOTES)
	STANDARD HYDRANT
	NEW METER
	EXISTING METER
	NEW WATER MAIN
	EXISTING WATER MAIN
	CONTINUATION OF NEW WATER MAIN
	SEWER
	TELEPHONE
	GAS
	NEW SERVICES
	EXISTING SERVICES
	LOCATIONS REQUIRING GRANULAR BACKFILL AND PAVEMENT REPAIR

NOTE:

Contractor is hereby notified that the width of all easements is 15'-0" permanent water main easement. Any questions concerning locations or other right-of-way shall be verified by contacting William Ewan, Attorney; Jeff Meinders, Utility Superintendent; or Robert Curry, Project Engineer. Contractor shall stop construction if any questions arise concerning location or right-of-way and verify with Owner prior to resuming construction.

AS BUILT 10-17-90

Robert E. Curry & Associates, Inc.
Engineers and Architects
3346 Avon Road, Plainfield, IN 46168
(317)-272-3050

ELROD WATER COMPANY, INC.

WATER MAIN EXTENSIONS
DIVISION "C"

LOCATION MAP, INDEX, AND LEGEND

DATE 7-17-89 APPROVED BY Robert E. Curry DRAWING NUMBER 2 OF 31

