


910 L.F. ± OF 4" SDR 26
PVC WATER MAIN

LINE 'H'
STA 10+00

LINE 'H'
STA 7+65
MATCH LINE SEE BELOW LEFT FOR CONTINUATION

OLD MILAN ROAD

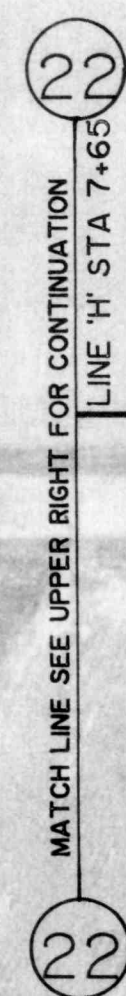

LINE 'H'
STA 5+00

765 L.F. ± OF 4" SDR 26
PVC WATER MAIN

1-4" SADDLE W/ 3/4"
CORP. STOP FACING NORTH

A right triangle is shown with a vertical leg labeled $42'$ and a horizontal leg labeled $140'$. The legs are perpendicular to each other, forming a right angle at their intersection.

BEGIN LINE 'H'
STA 0+00

ROBERT CLARK


EXISTING 3" WATER MAIN

STEPHEN BAYLOR

1-4" x 3" D.I.M.J. REDUCER
1-3" GATE VALVE & BOX

WILLIAM HUFFMAN

OLD MILAN ROAD

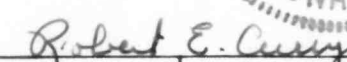

AS BUILT 10-17-90

JOB NO.	SHT.
SCALE 1" = 50'	14 OF 31