


GROUND ELEV. = 980±
MAX STATIC PRESSURE = 78 PSI±

C. R. 500 EAST


GROUND ELEV. = 990±
MAX STATIC PRESSURE = 74 PSI±

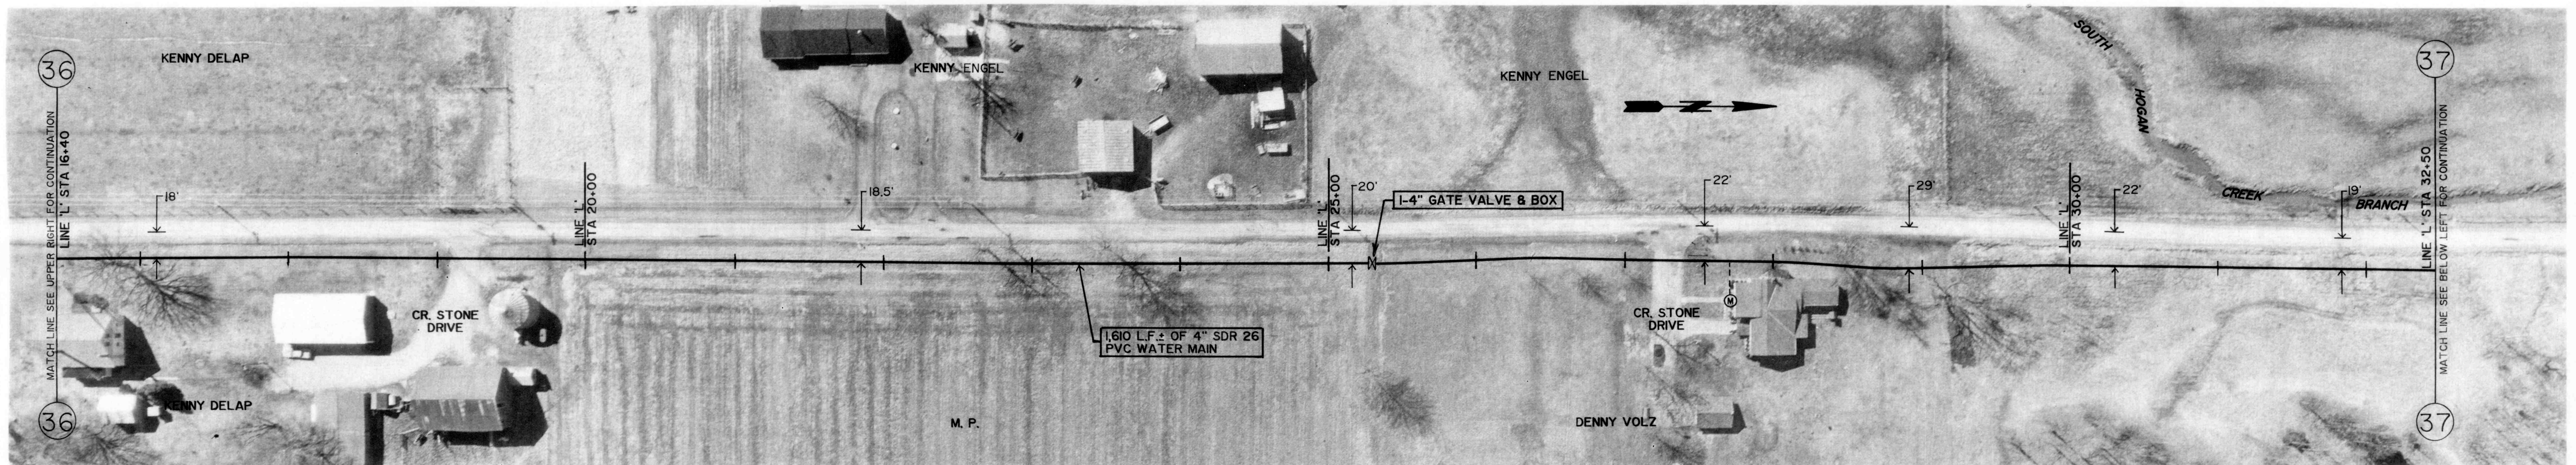

GROUND ELEV. = 990±
MAX STATIC PRESSURE = 74 PSI±

C. R. 500 EAST


GROUND ELEV. = 990±
MAX STATIC PRESSURE = 74 PSI±

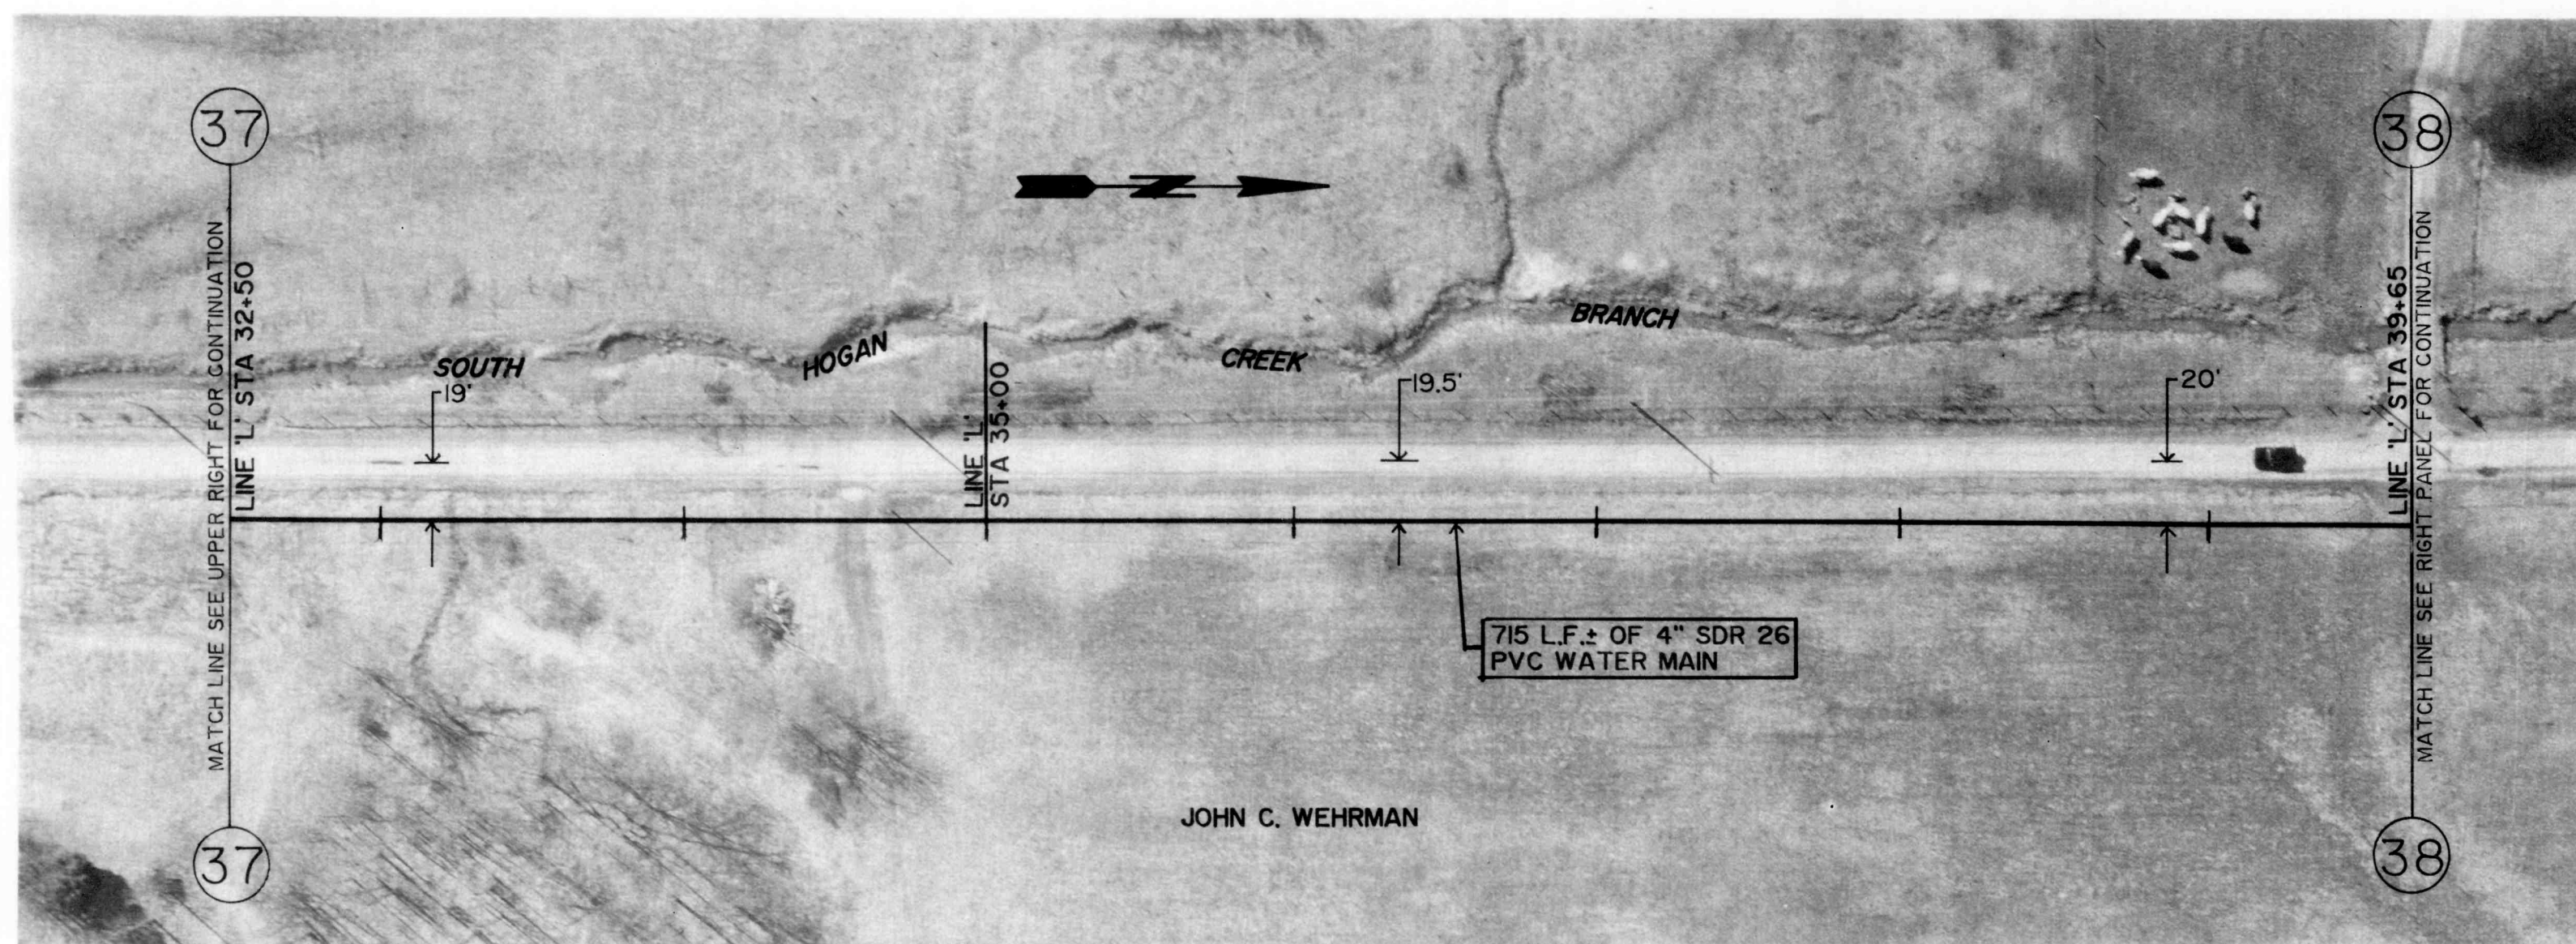

GROUND ELEV. = 990±
MAX STATIC PRESSURE = 74 PSI±


C. R. 500 EAST

GROUND ELEV. = 990±
MAX STATIC PRESSURE = 74 PSI±

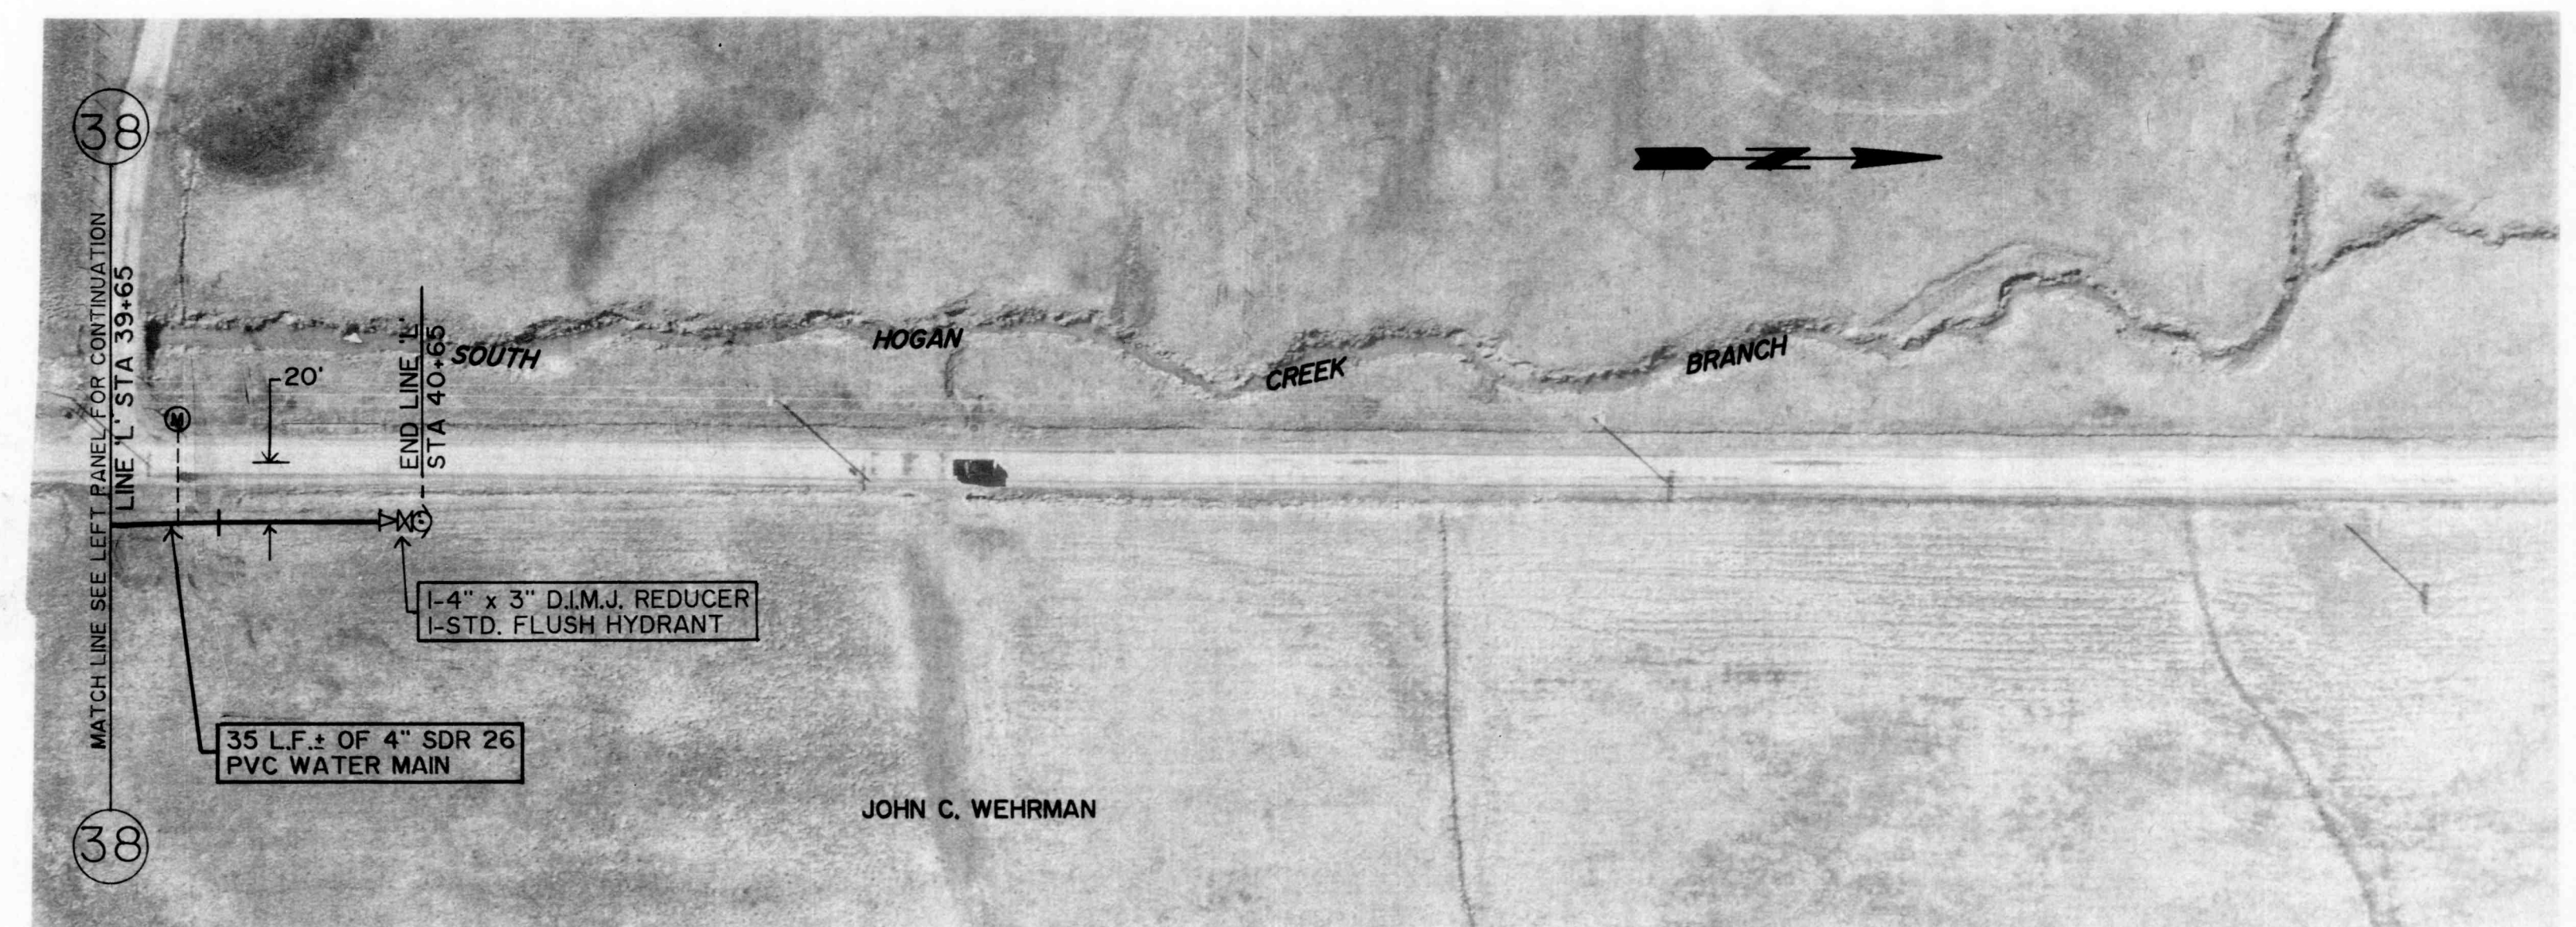

GROUND ELEV. = 990±
MAX STATIC PRESSURE = 74 PSI±

C. R. 500 EAST

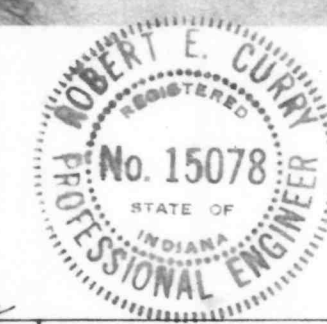

REVISIONS *Robert E. Curry*

DRAWN BY	D. D. E.
DATE	7-17-89
CERTIFIED BY	ROBERT E. CURRY
DATE	7-17-89

ROBERT E. CURRY & ASSOCIATES, INC.
CONSULTING ENGINEERS

ELROD WATER COMPANY INC.
DIVISION "C" DISTRIBUTION SYSTEM EXTENSIONS

C. R. 500 EAST BEGINNING AT MILAN ROAD
4" WATER MAIN

AS BUILT 10-17-90

JOB NO.	SHT.
	20
SCALE	OF
1" = 50'	31