



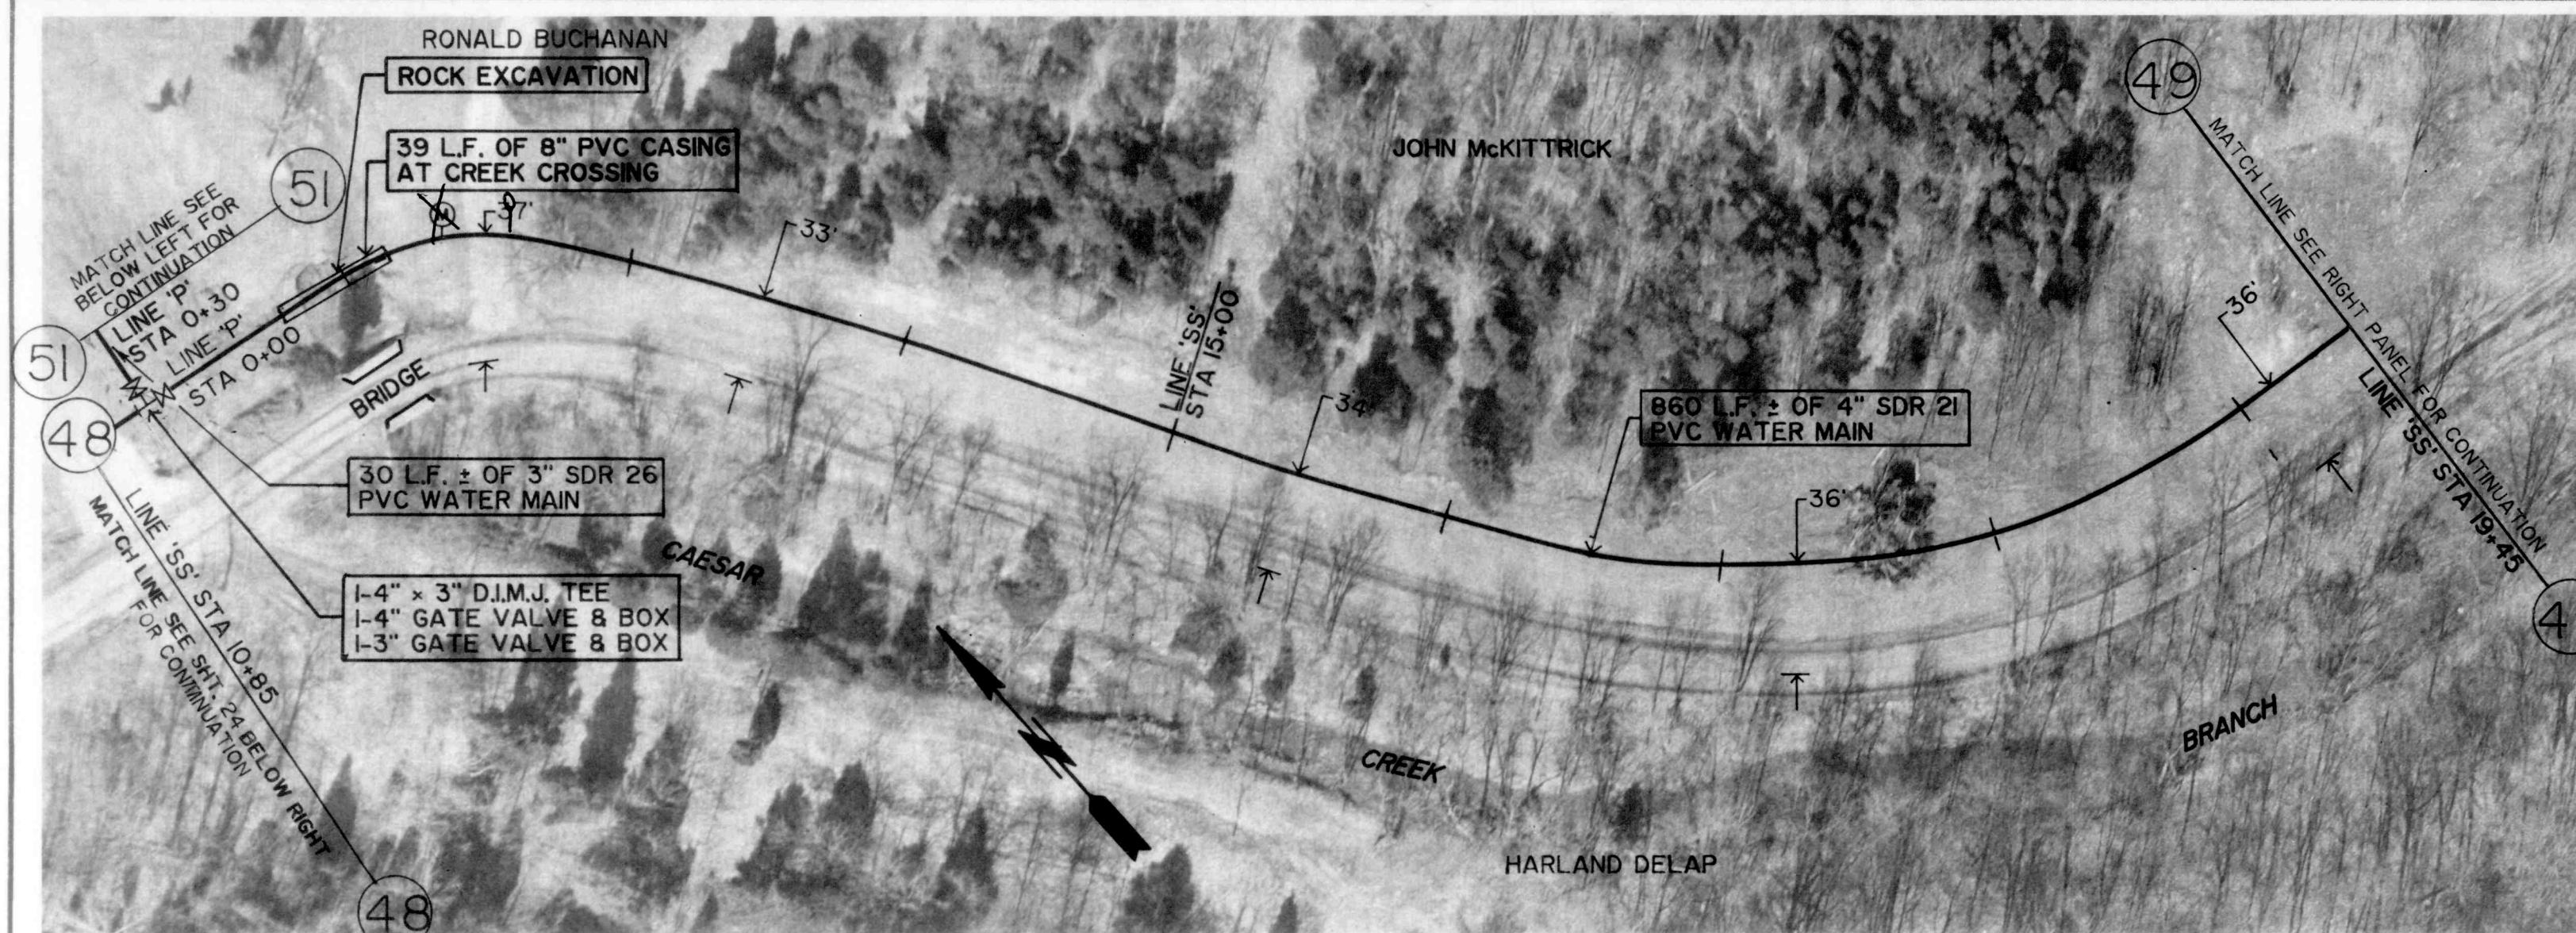

GROUND ELEV. = 880±
MAX STATIC PRESSURE = 112 PSI±

C. R. 300 SOUTH


GROUND ELEV. = 870±
MAX STATIC PRESSURE = 116 PSI±

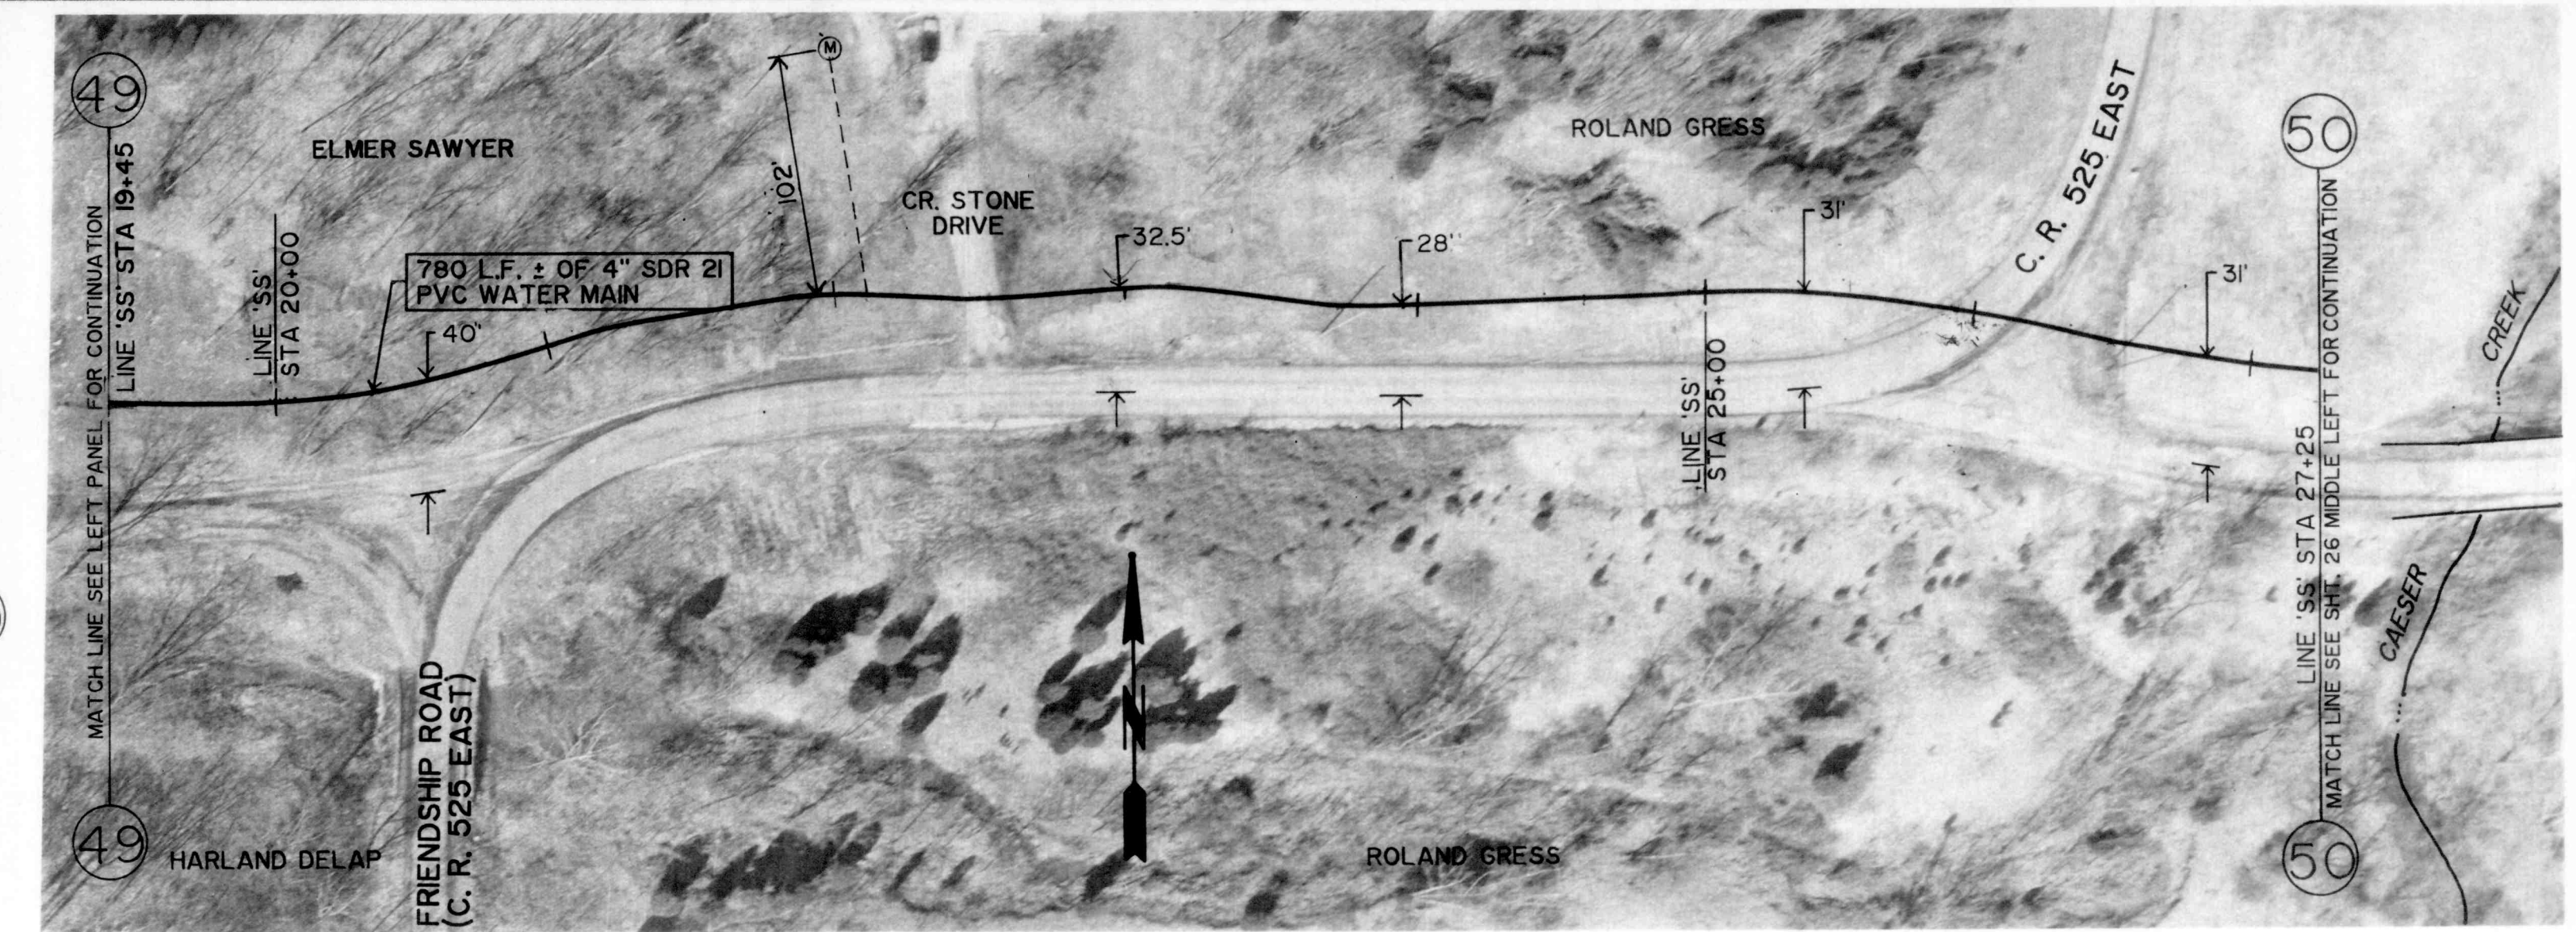

GROUND ELEV. = 870±
MAX STATIC PRESSURE = 116 PSI±

C. R. 300 SOUTH

GROUND ELEV. = 870±
MAX STATIC PRESSURE = 116 PSI±

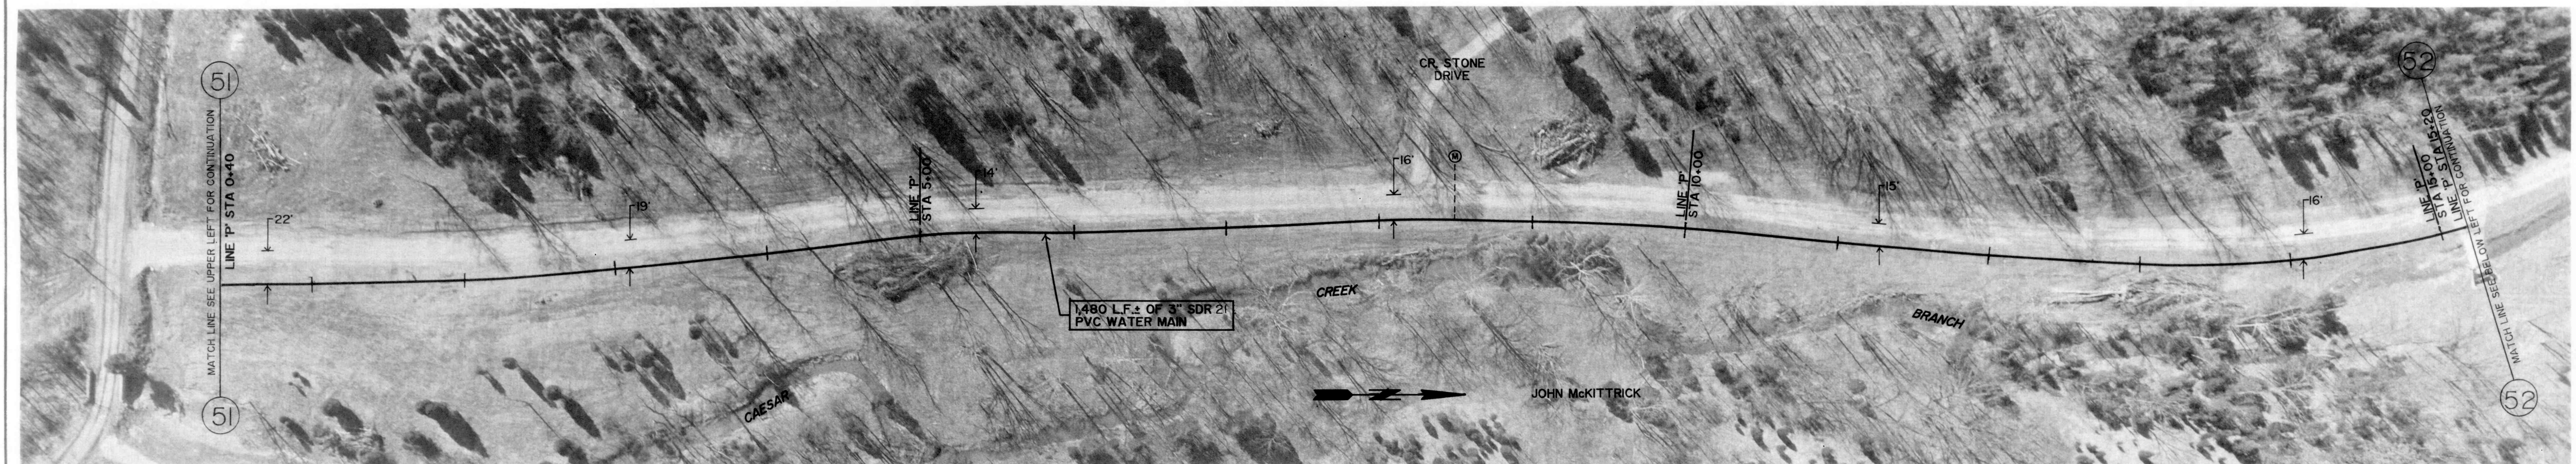

GROUND ELEV. = 880±
MAX STATIC PRESSURE = 112 PSI±

C. R. 475 EAST


GROUND ELEV. = 880±
MAX STATIC PRESSURE = 112 PSI±



GROUND ELEV. = 880±
MAX STATIC PRESSURE = 112 PSI±

C. R. 475 EAST

GROUND ELEV. = 880±
MAX STATIC PRESSURE = 112 PSI±

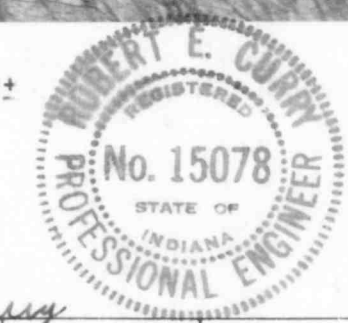

REVISIONS

DRAWN BY D. D. E.
DATE 7-17-89
CERTIFIED BY ROBERT E. CURRY
DATE 7-17-89

ROBERT E. CURRY & ASSOCIATES, INC.
CONSULTING ENGINEERS

ELROD WATER COMPANY INC.
DIVISION "C" DISTRIBUTION SYSTEM EXTENSIONS

C. R. 300 SOUTH
C. R. 475 EAST BEGINNING AT C. R. 300 SOUTH
4" & 3" WATER MAINS

AS BUILT 10-17-90

JOB NO. SHT. 25
SCALE 1" = 50' OF 31