


GROUND ELEV. = 1000±
MAX STATIC PRESSURE = 69 PSI±

C. R. 1100 NORTH


GROUND ELEV. = 990±
MAX STATIC PRESSURE = 74 PSI±

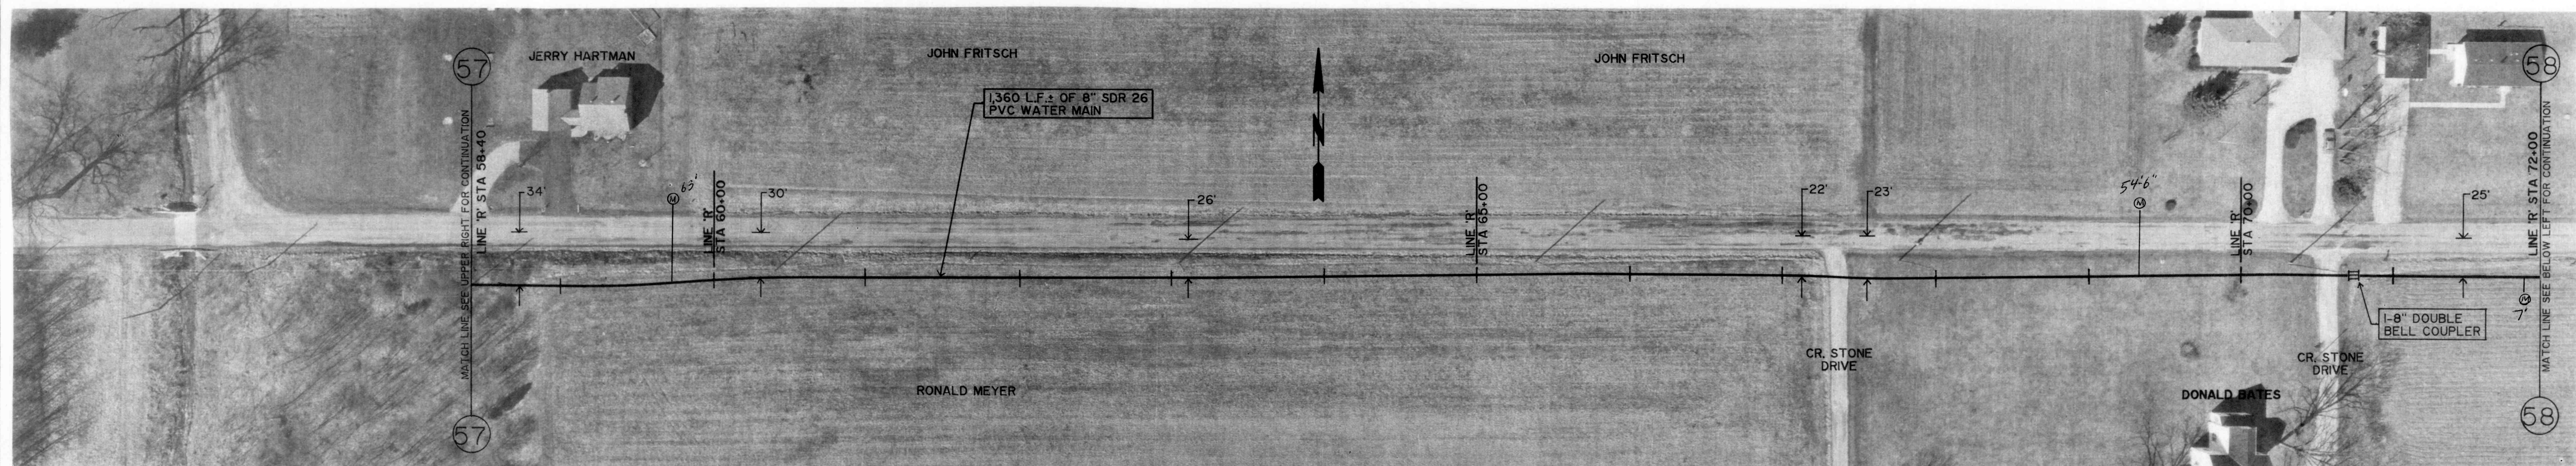

GROUND ELEV. = 990±
MAX STATIC PRESSURE = 74 PSI±

C. R. 1100 NORTH


GROUND ELEV. = 1020±
MAX STATIC PRESSURE = 61 PSI±

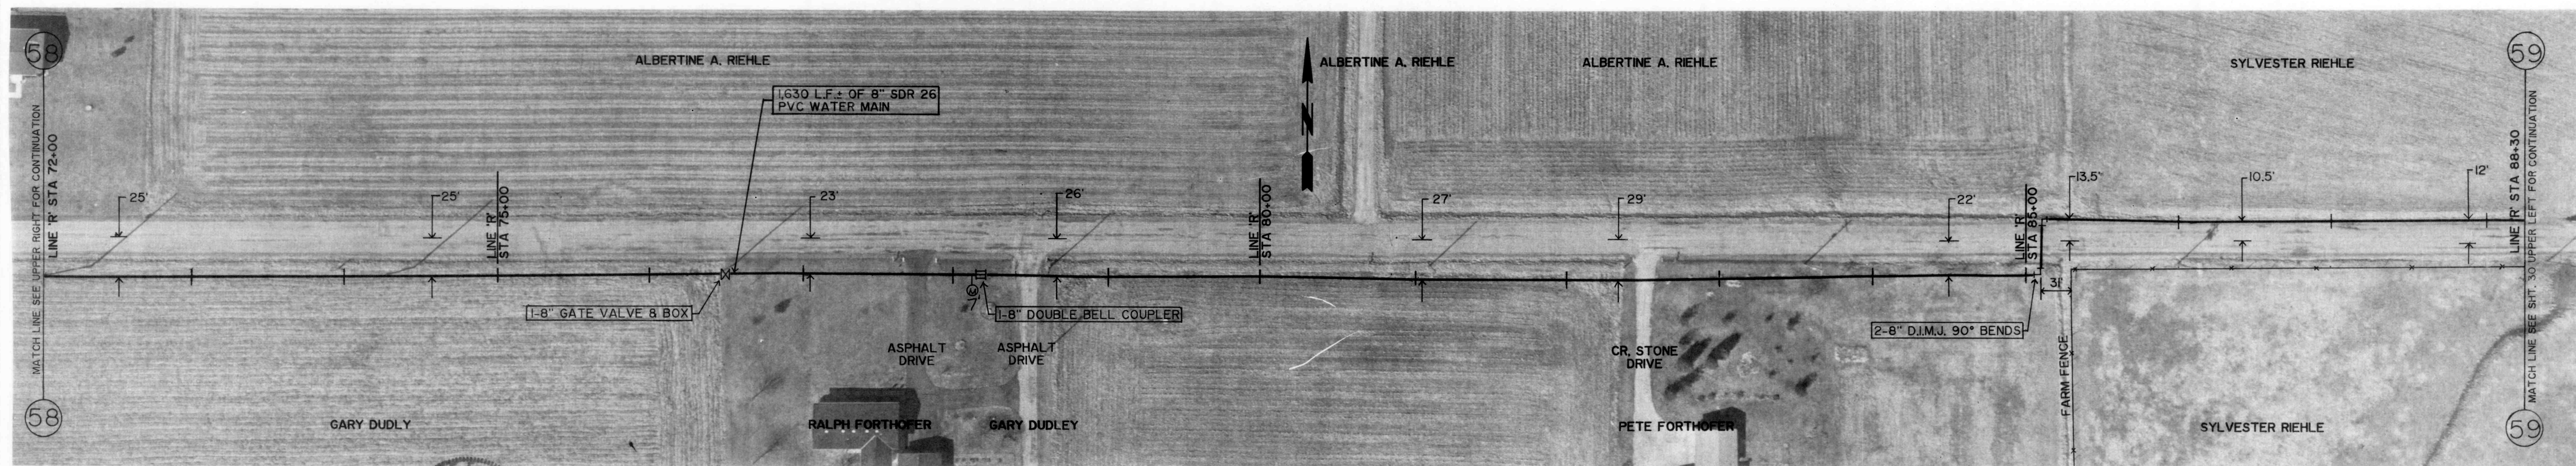

GROUND ELEV. = 1020±
MAX STATIC PRESSURE = 61 PSI±

C. R. 1100 NORTH

GROUND ELEV. = 1010±
MAX STATIC PRESSURE = 65 PSI±

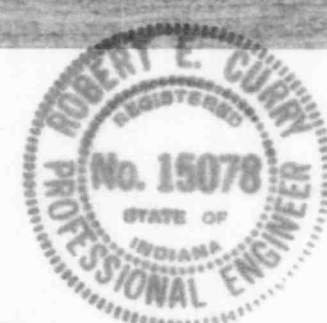

REVISIONS

Robert E. Curry

DRAWN BY	D. D. E.
DATE	7-17-89
CERTIFIED BY	ROBERT E. CURRY
DATE	7-17-89

ROBERT E. CURRY & ASSOCIATES, INC.
CONSULTING ENGINEERS

ELROD WATER COMPANY INC.
DIVISION "C" DISTRIBUTION SYSTEM EXTENSIONS

C. R. 1100 NORTH
8" WATER MAIN

AS BUILT 10-17-90

JOB NO.	SHT.
	29
SCALE	OF
1" = 50'	31