


GROUND ELEV. = 985±
MAX STATIC PRESSURE = 76 PSI±

C. R. 450 EAST

GROUND ELEV. = 980±
MAX STATIC PRESSURE = 78 PSI±

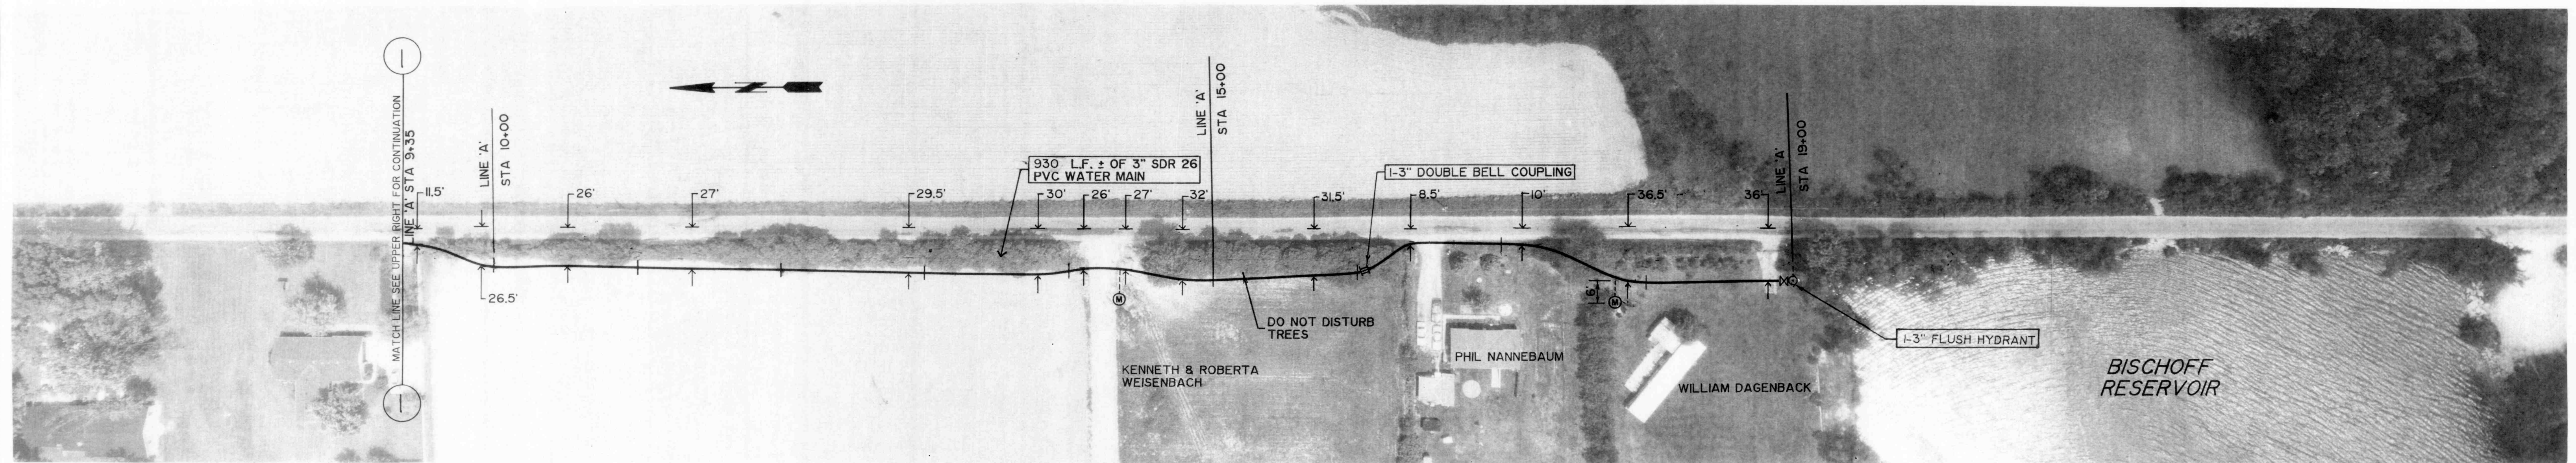

GROUND ELEV. = 980±
MAX STATIC PRESSURE = 78 PSI±

C. R. 450 EAST

GROUND ELEV. = 960±
MAX STATIC PRESSURE = 87 PSI±



Robert E. Curry

REVISIONS	DRAWN BY	D.D.E.	ROBERT E. CURRY & ASSOCIATES, INC. CONSULTING ENGINEERS	ELROD WATER COMPANY INC. DIVISION "C" DISTRIBUTION SYSTEM EXTENSIONS	C. R. 450 EAST BEGINNING AT C. R. 1400 NORTH	AS BUILT 10-17-90	
	DATE	7-17-89				JOB NO.	SHT. 3
	CERTIFIED BY	ROBERT E. CURRY				SCALE	OF 31
	DATE	7-17-89				1" = 50'	