
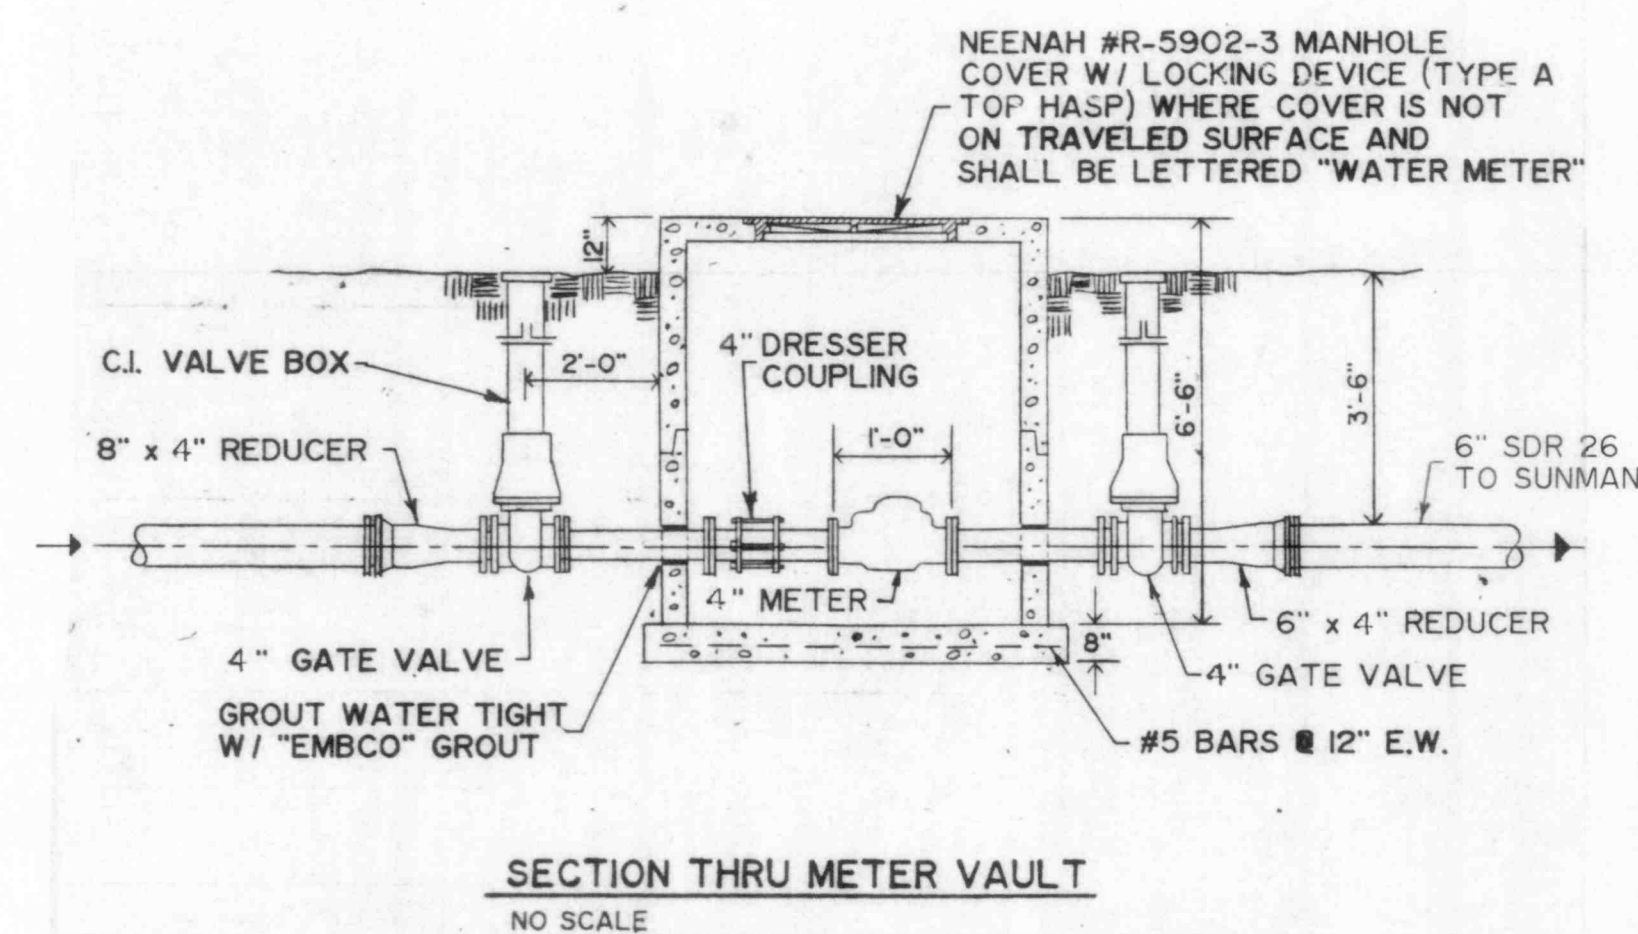


GROUND ELEV. = 1010±
MAX STATIC PRESSURE = 65 PSI±

GROUND ELEV. = 1010±
MAX STATIC PRESSURE = 65 PSI±

C. R. 1100 NORTH

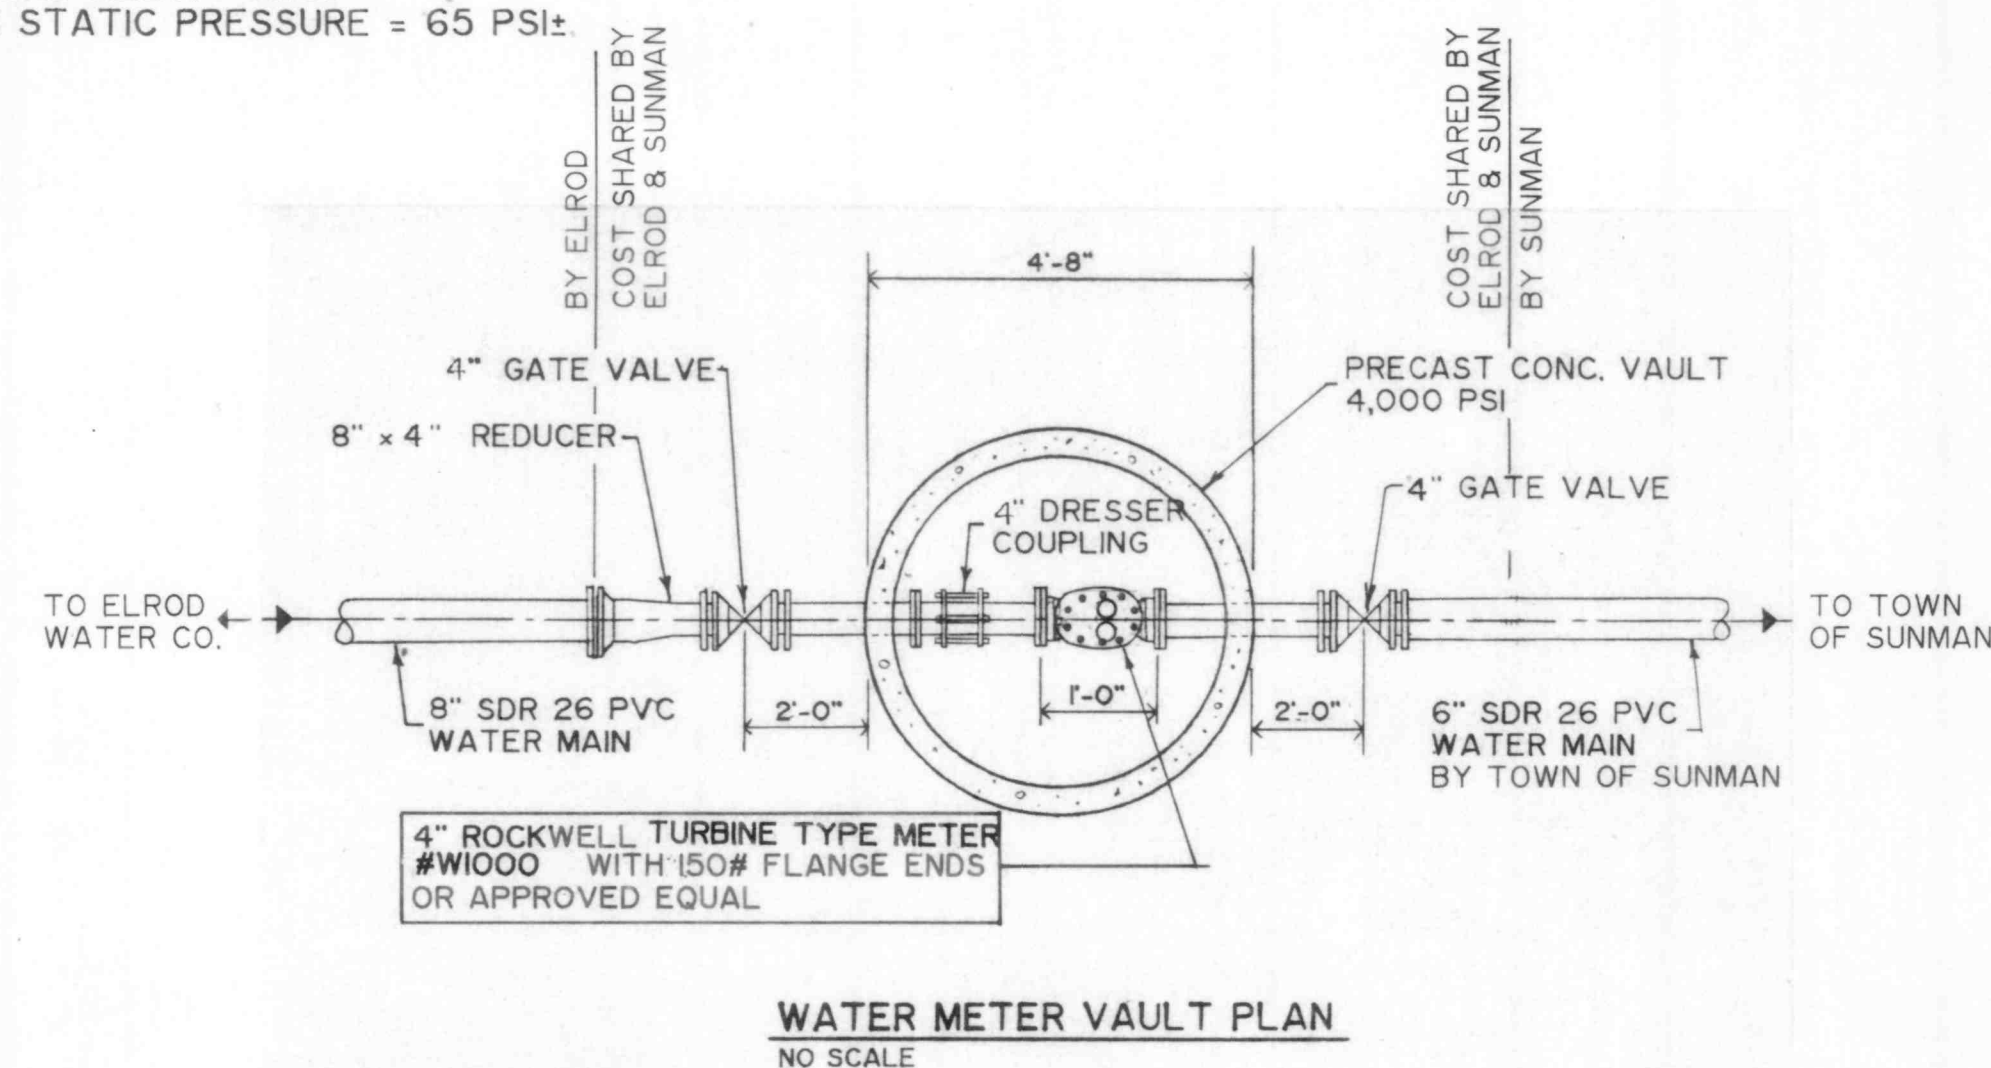

CHANGE ORDER NO. 1			
ITEM NO.	DESCRIPTION OF AL DITIONAL WORK	UNITS	QUANTITY
1e	8" SDR 26 PVC WATER MAIN	L. F.	30
2a	4" RESILIENT GATE VALVE & C.I. VALVE BOX	Each	2
3a	DUCTILE IRON MECHANICAL JOINT FITTINGS	Pounds	960
9a	PRECAST CONCRETE METER VAULT & MANHOLE COVER, TURBINE TYPE WATER METER	Each	1
9b	ROCKWELL MODEL #W1000 OR APPROVED EQUAL	Each	1
9c	4" DRESSER COUPLING	Each	1



Robert E. Curry

REVISIONS	DRAWN BY	D. D. E.	ROBERT E. CURRY & ASSOCIATES, INC. CONSULTING ENGINEERS	ELROD WATER COMPANY INC. DIVISION "C" DISTRIBUTION SYSTEM EXTENSIONS	C. R. 1100 NORTH 8" WATER MAIN	CHANGE ORDER NO. 1 FOR METER VAULT & CONNECTION TO TOWN OF SUNMAN REVISED(5-29-90) (8 - 28 -90)		AS BUILT 10-17-90	
	DATE	7-17-89						JOB NO.	SHT. 30
	CERTIFIED BY	ROBERT E. CURRY						SCALE	OF 31
	DATE	7-17-89						1" = 50'	