


GROUND ELEV. = 990±
MAX STATIC PRESSURE = 74 PSI±


C. R. 1350 NORTH

GROUND ELEV. = 990±
MAX STATIC PRESSURE = 74 PSI±

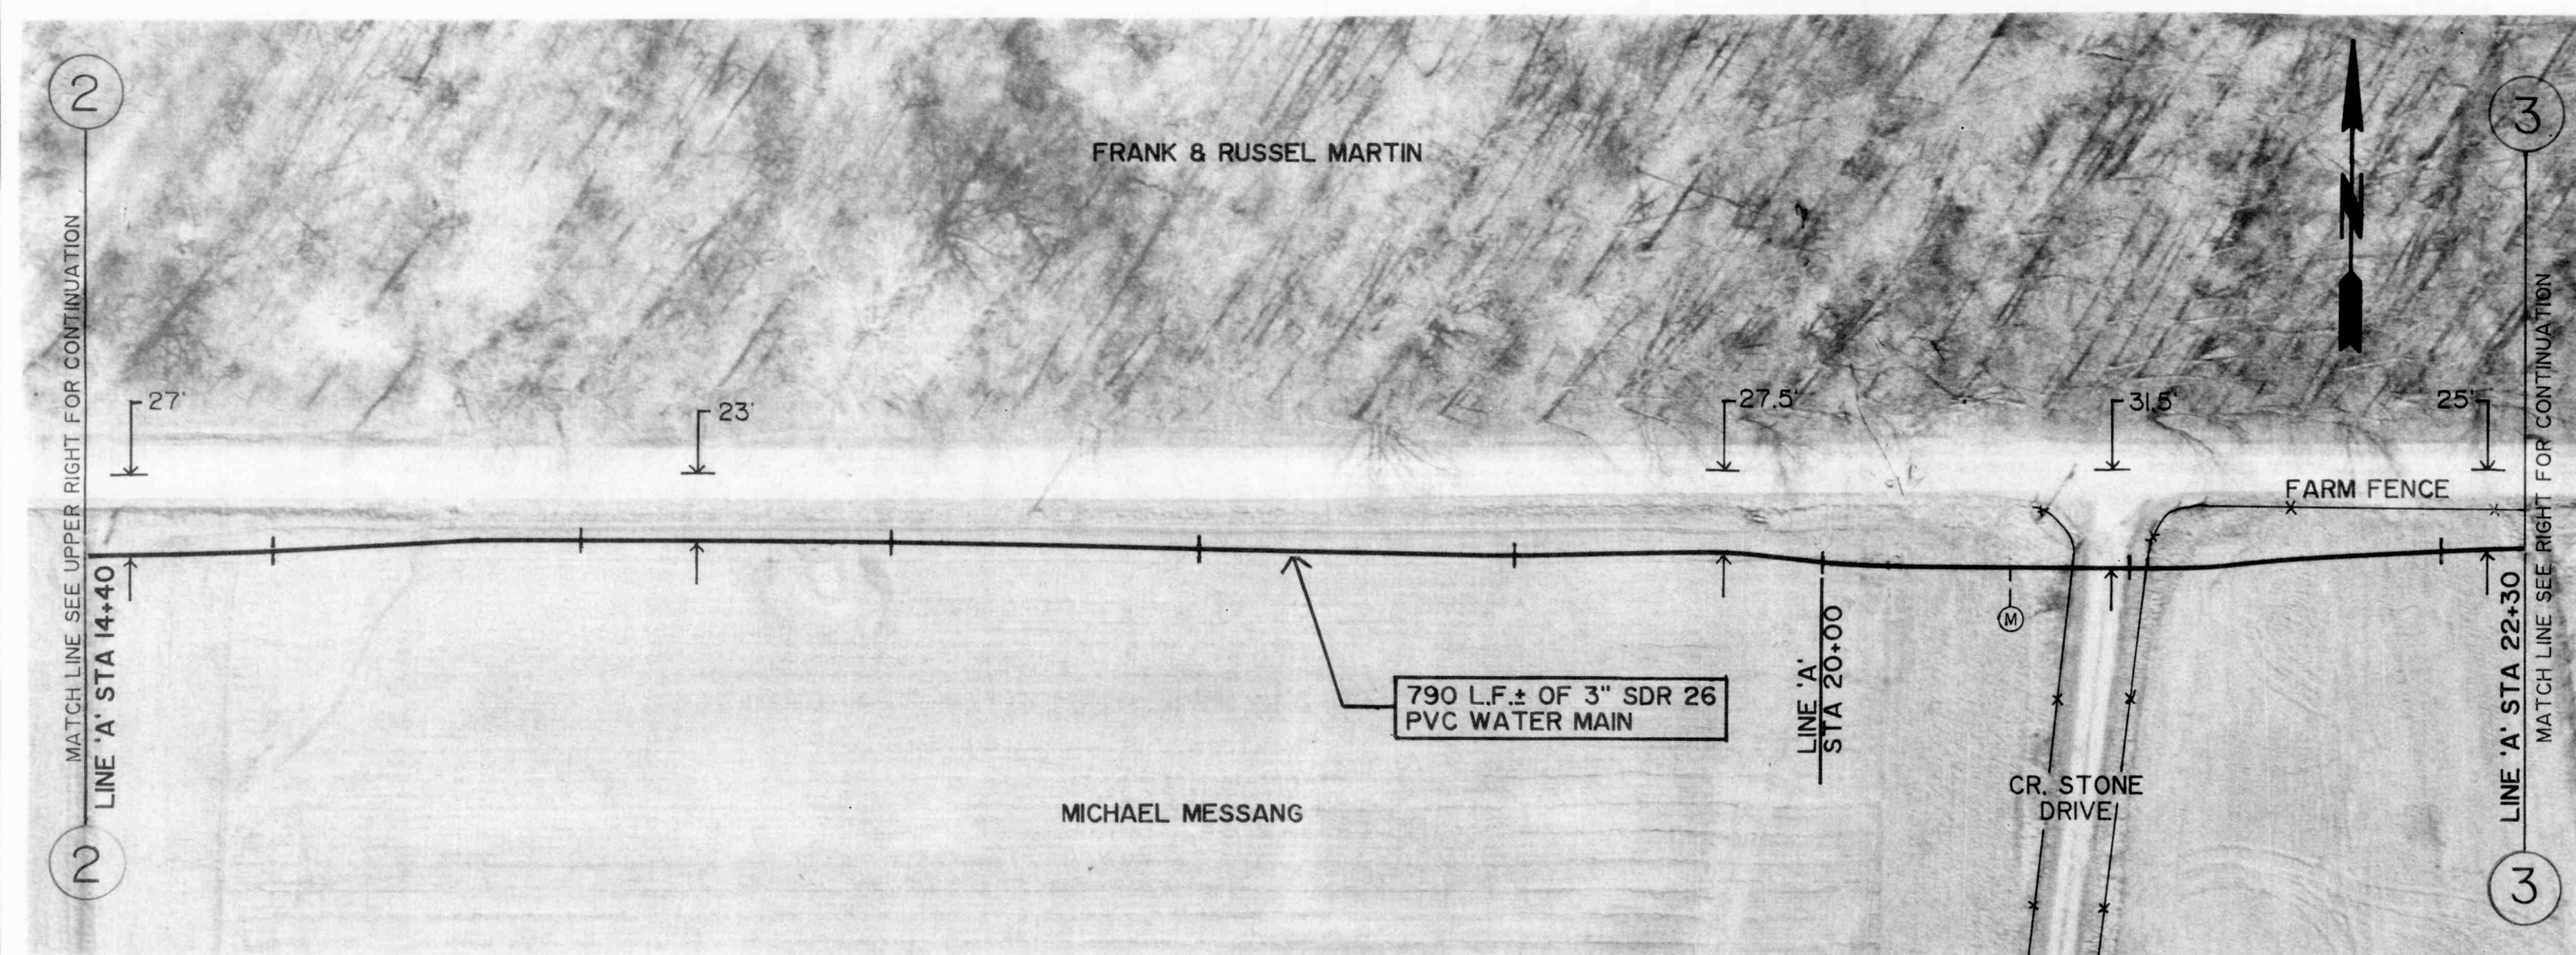


GROUND ELEV. = 990±
MAX STATIC PRESSURE = 74 PSI±

C. R. 1350 NORTH

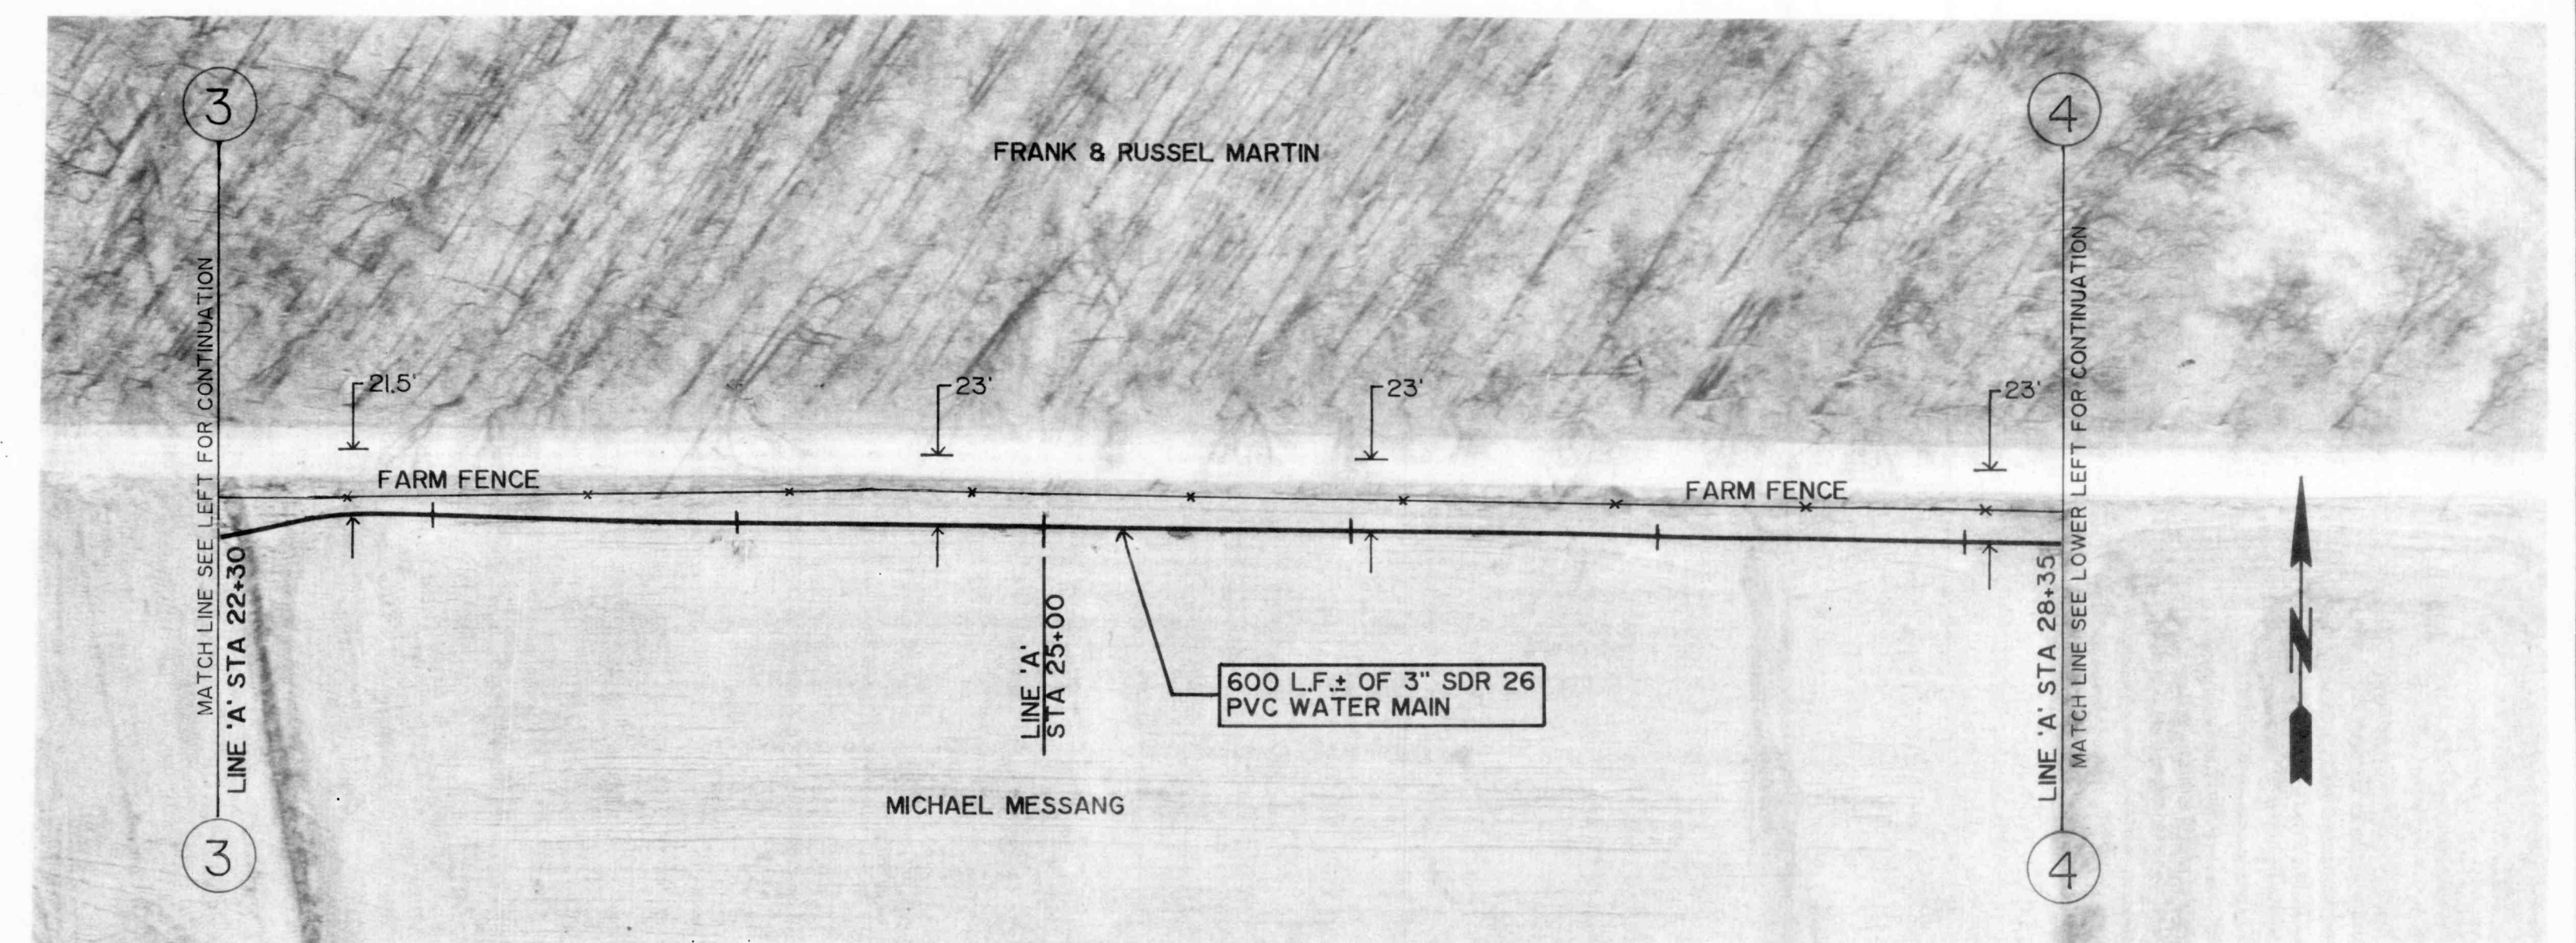

GROUND ELEV. = 990±
MAX STATIC PRESSURE = 74 PSI±

C. R. 1350 NORTH

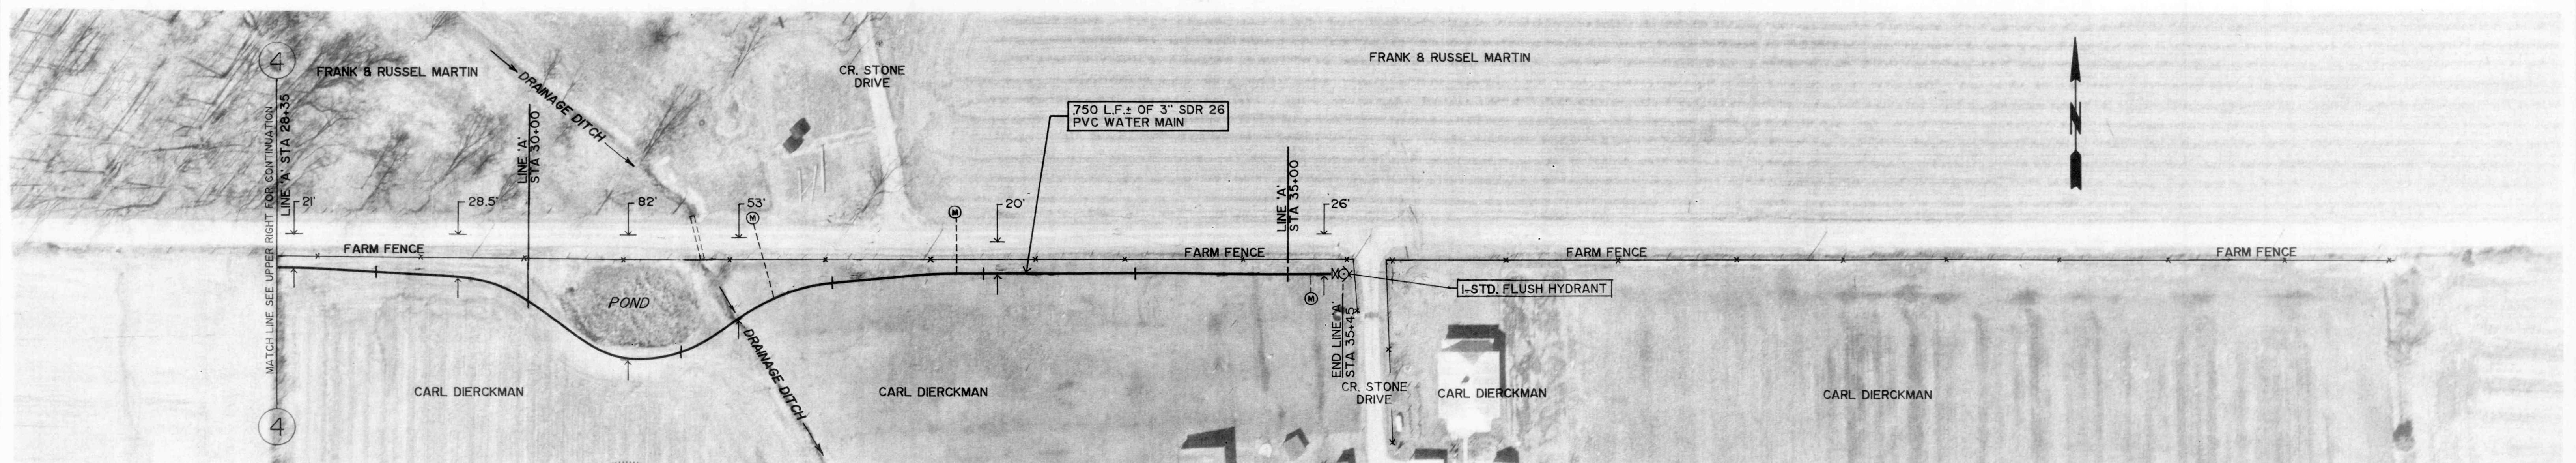

GROUND ELEV. = 990±
MAX STATIC PRESSURE = 74 PSI±

C. R. 1350 NORTH

GROUND ELEV. = 990±
MAX STATIC PRESSURE = 74 PSI±

REVISIONS
9/18/89: ADDED TWO WATER METERS

DRAWN BY	D. D. E.
DATE	7-17-89
CERTIFIED BY	ROBERT E. CURRY
DATE	7-17-89

ROBERT E. CURRY & ASSOCIATES, INC.
CONSULTING ENGINEERS

ELROD WATER COMPANY INC.
DIVISION "C" DISTRIBUTION SYSTEM EXTENSIONS

C. R. 1350 NORTH BEGINNING AT C. R. 500 EAST
3" WATER MAIN

AS BUILT 10-17-90

JOB NO.	SHT. 4
SCALE 1" = 50'	OF 31