


GROUND ELEV. = 980±
MAX STATIC PRESSURE = 78 PSI±

SECOND STREET


GROUND ELEV. = 980±
MAX STATIC PRESSURE = 78 PSI±

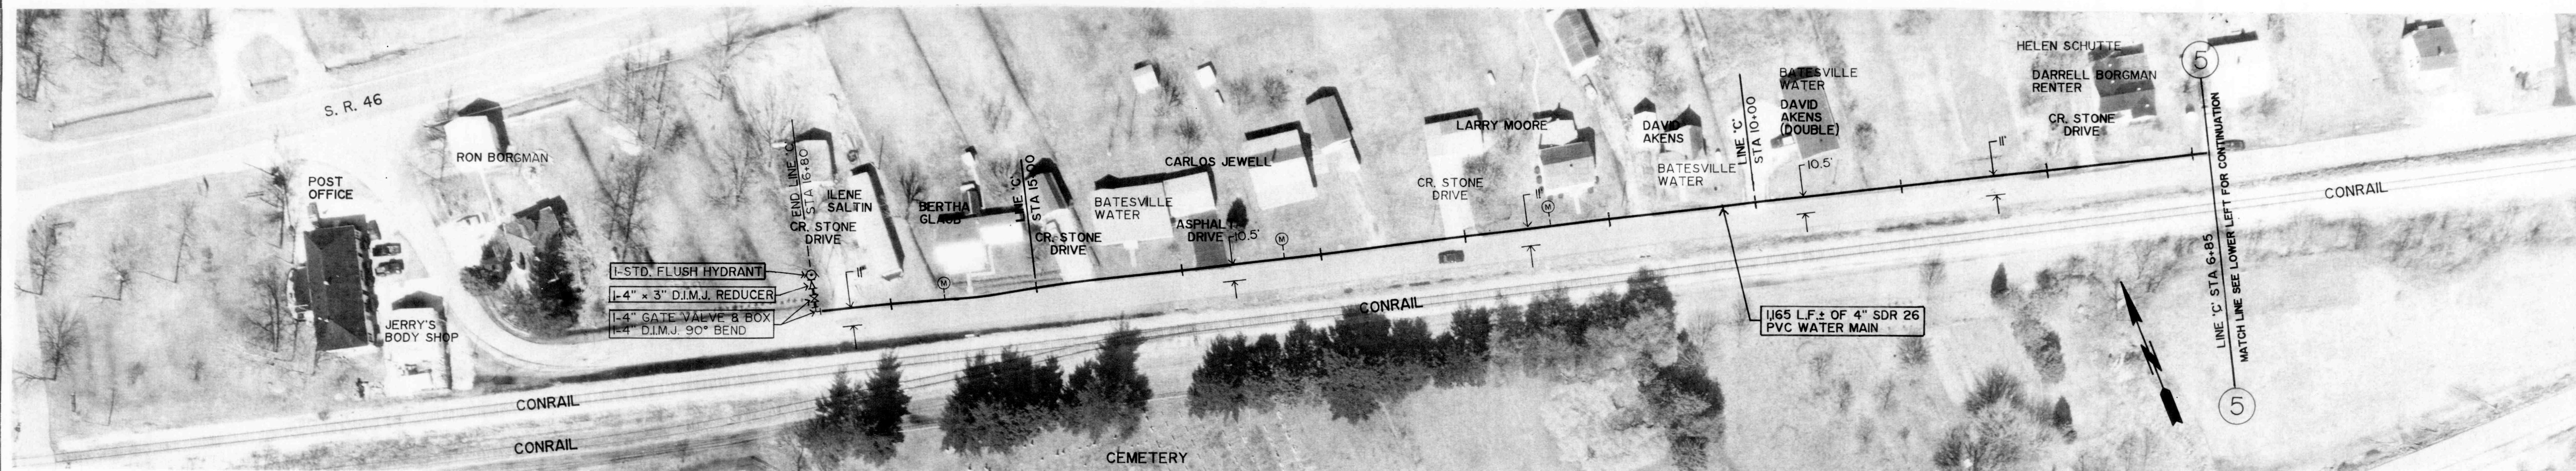

GROUND ELEV. = 980±
MAX STATIC PRESSURE = 78 PSI±

RAILROAD AVENUE


GROUND ELEV. = 990±
MAX STATIC PRESSURE = 74 PSI±

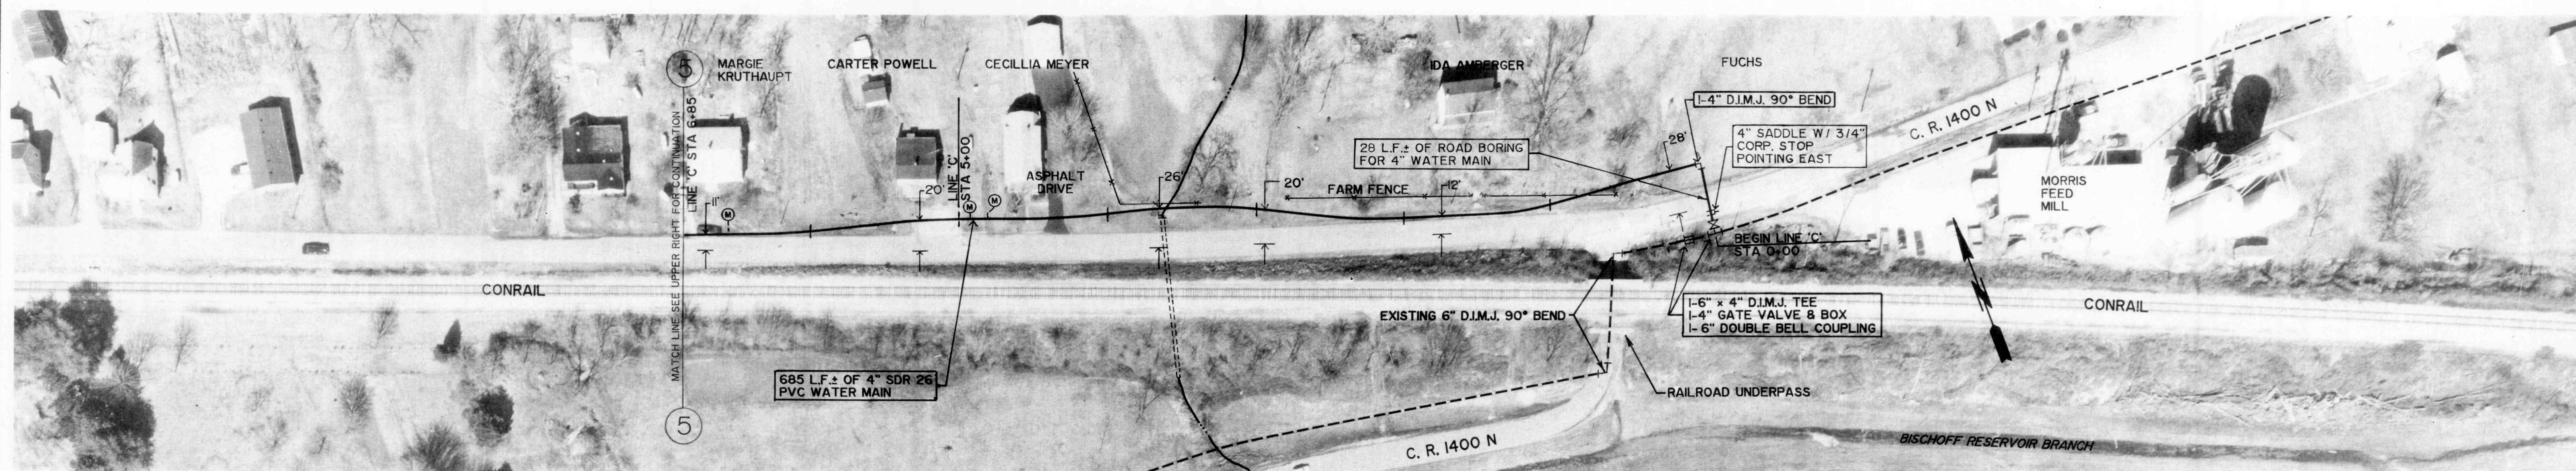

GROUND ELEV. = 990±
MAX STATIC PRESSURE = 74 PSI±

RAILROAD AVENUE

GROUND ELEV. = 980±
MAX STATIC PRESSURE = 78 PSI±

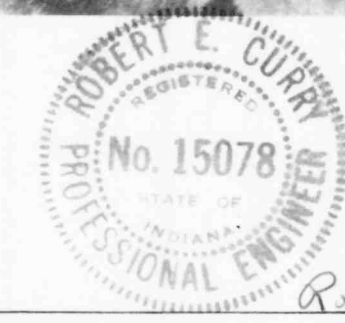

REVISIONS

DRAWN BY	D. D. E.
DATE	7-17-89
CERTIFIED BY	ROBERT E. CURRY
DATE	7-17-89

ROBERT E. CURRY & ASSOCIATES, INC.
CONSULTING ENGINEERS

ELROD WATER COMPANY INC.
DIVISION "C" DISTRIBUTION SYSTEM EXTENSIONS

SECOND STREET IN THE TOWN OF MORRIS
RAILROAD AVENUE IN THE TOWN OF MORRIS
4" WATER MAINS

AS BUILT 10-17-90

JOB NO.	SHT.
	5
SCALE	OF
1" = 50'	31