



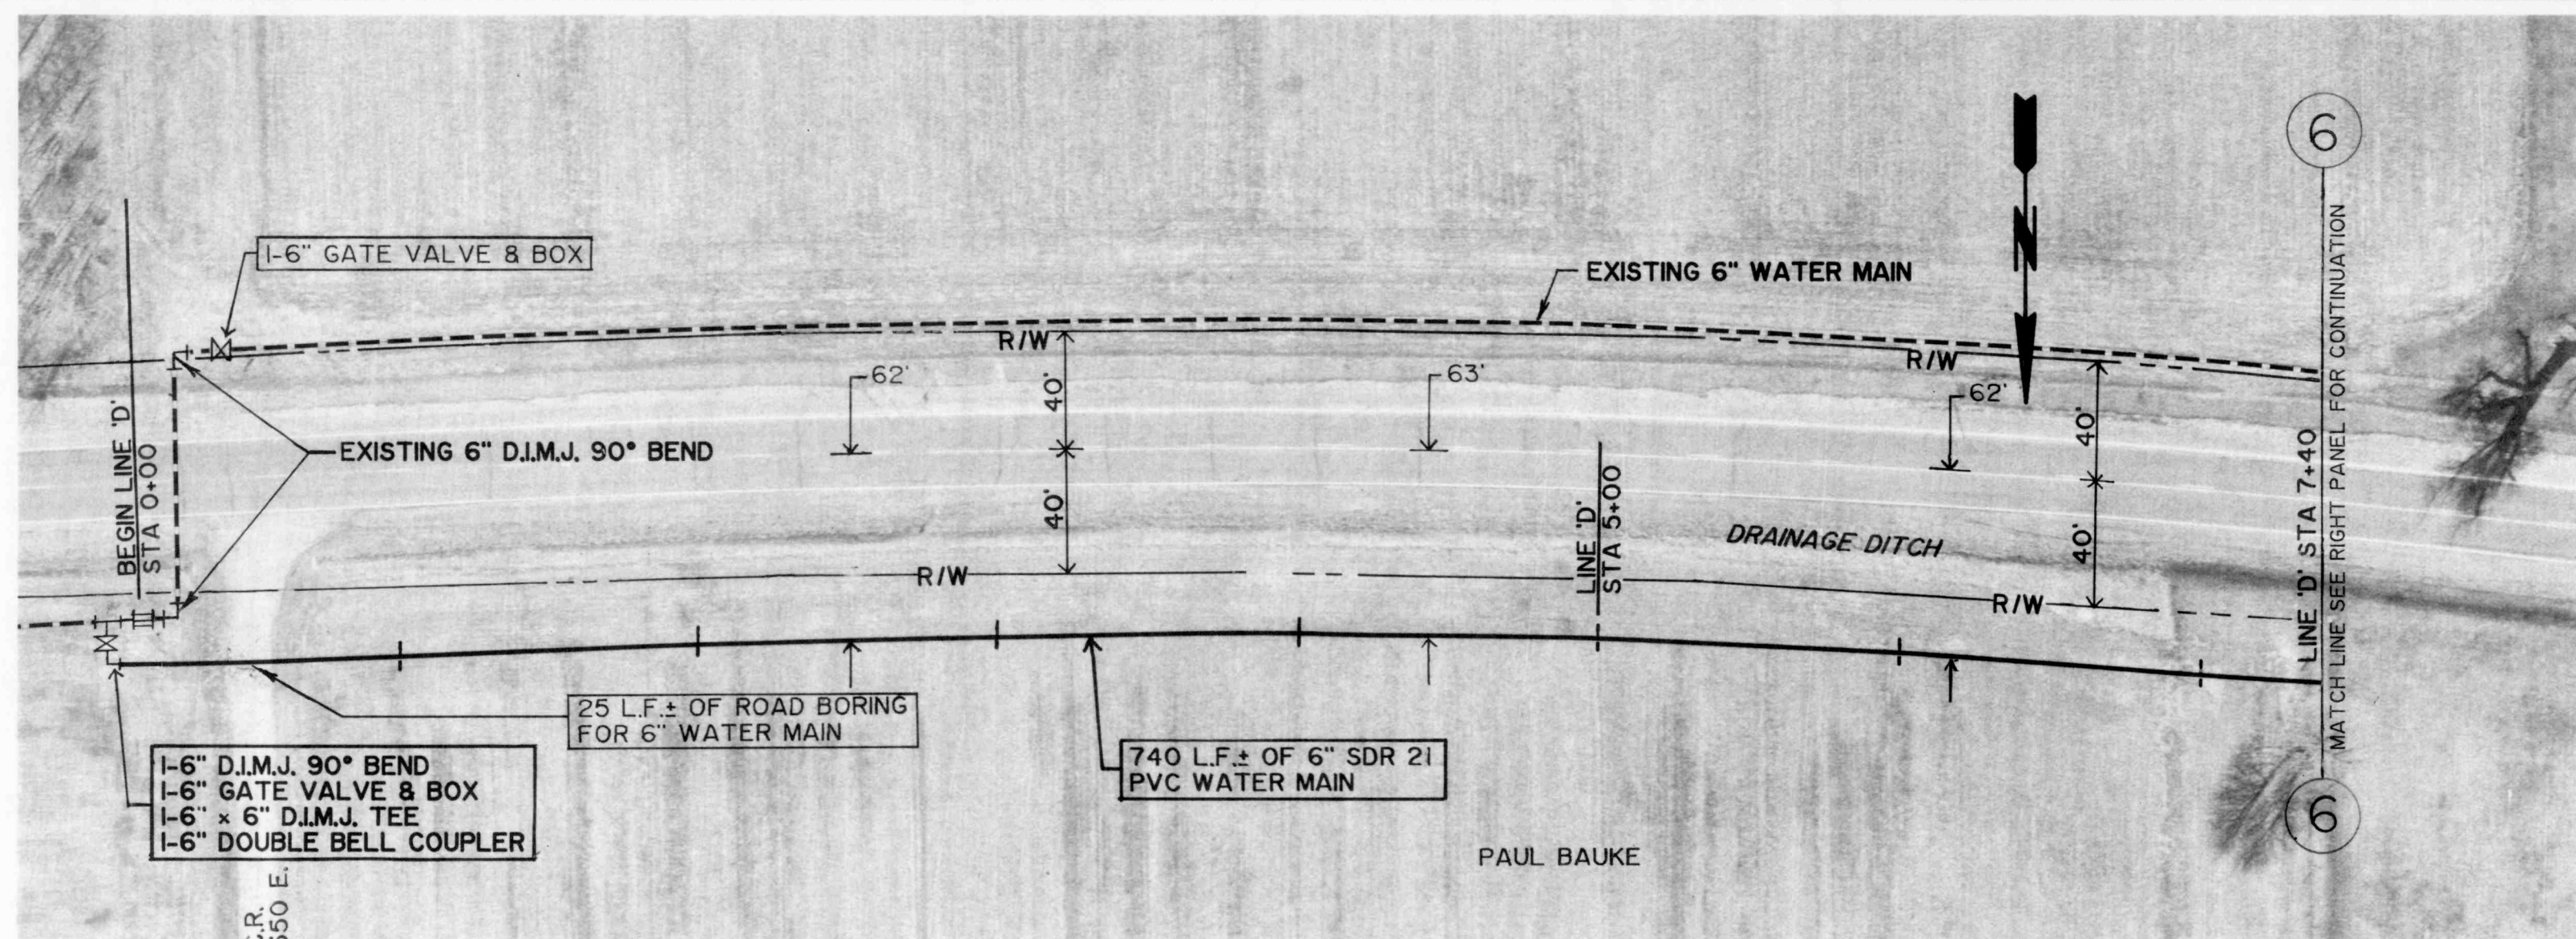

GROUND ELEV. = 980±
MAX STATIC PRESSURE = 78 PSI±

S. R. 46


GROUND ELEV. = 985±
MAX STATIC PRESSURE = 76 PSI±

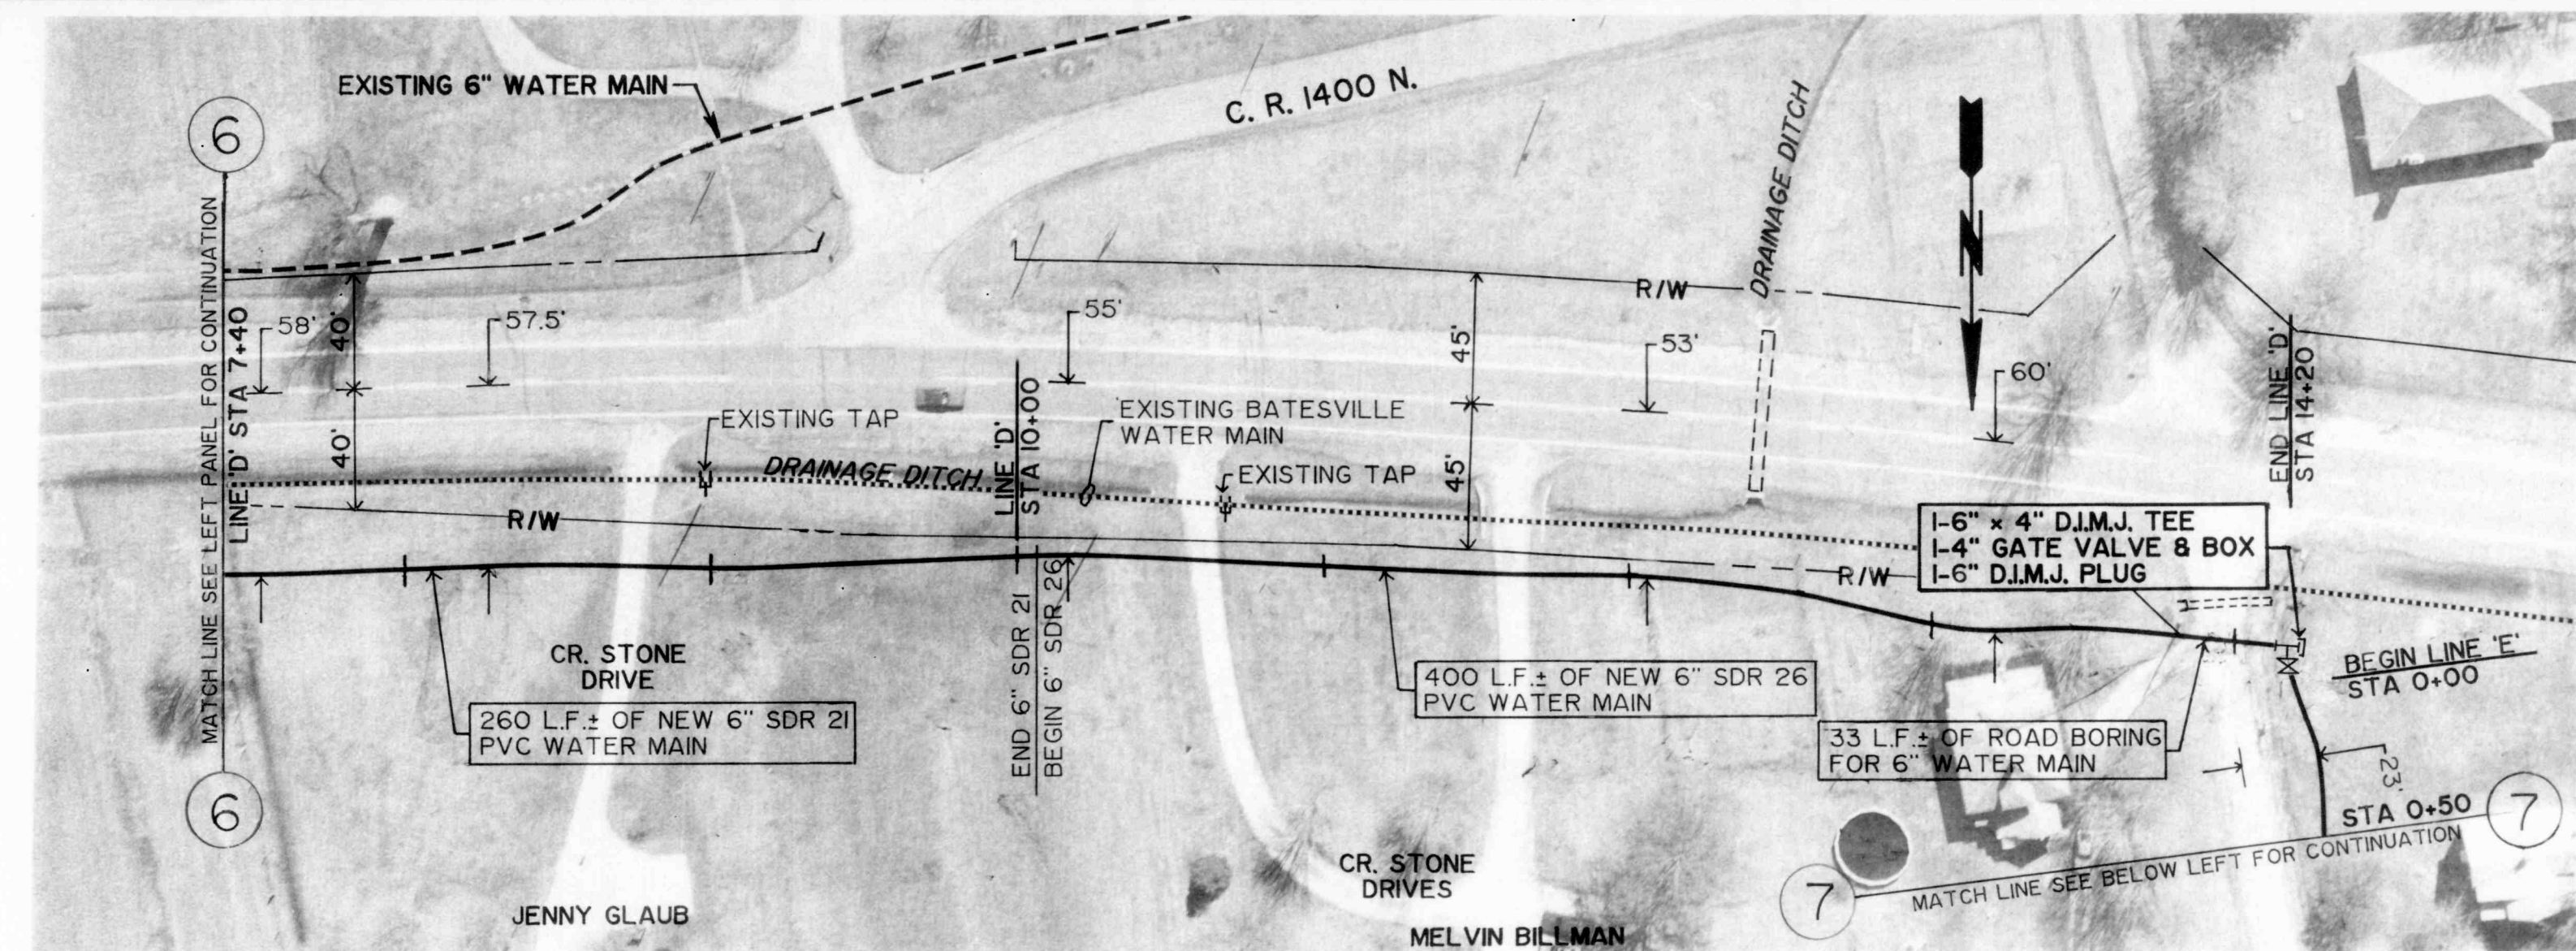

GROUND ELEV. = 985±
MAX STATIC PRESSURE = 76 PSI±

S. R. 46 & C. R. 525 EAST

GROUND ELEV. = 990±
MAX STATIC PRESSURE = 74 PSI±

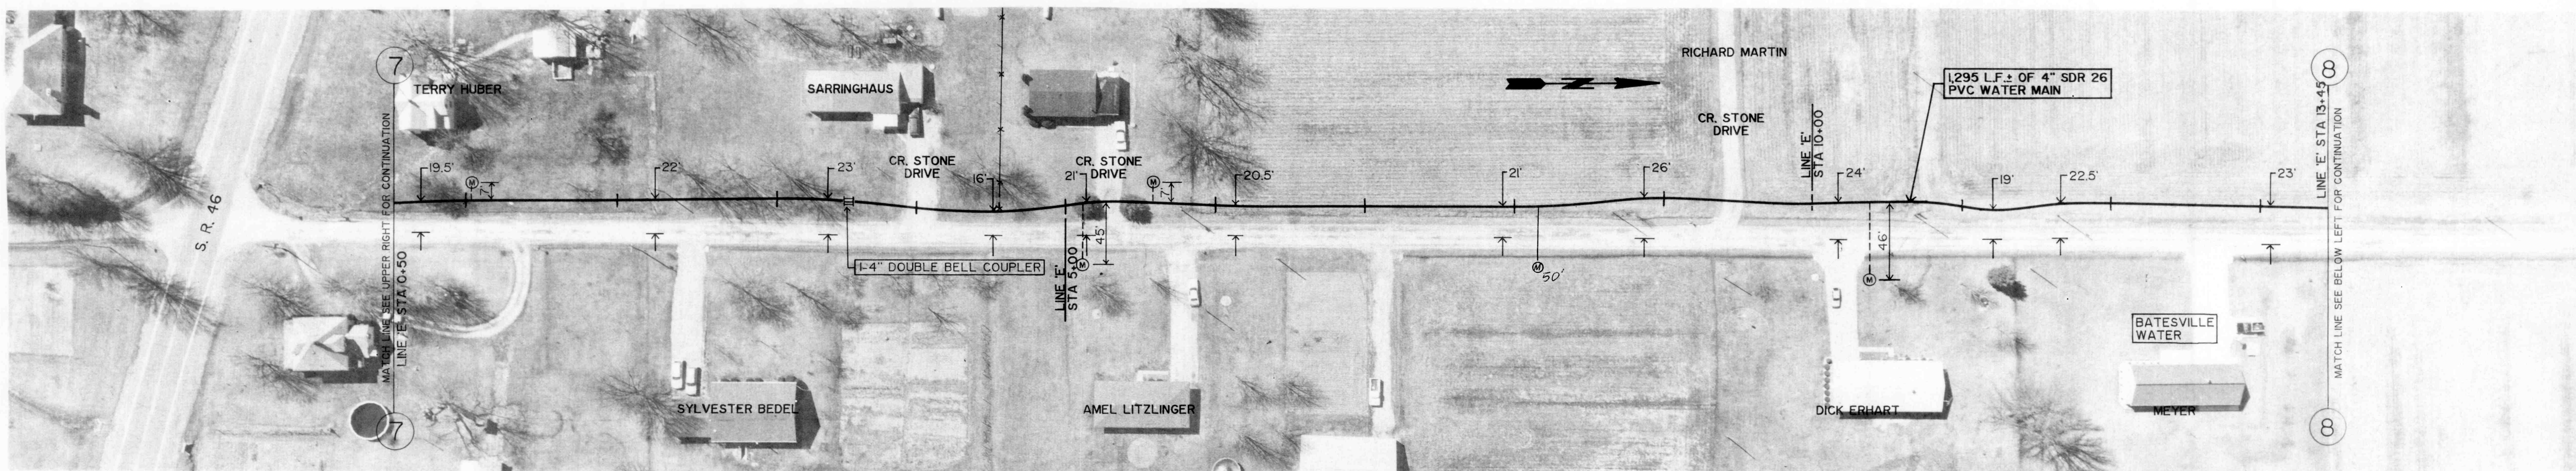

GROUND ELEV. = 990±
MAX STATIC PRESSURE = 74 PSI±

C. R. 525 EAST


GROUND ELEV. = 990±
MAX STATIC PRESSURE = 74 PSI±



GROUND ELEV. = 990±
MAX STATIC PRESSURE = 74 PSI±

GROUND ELEV. = 990±
MAX STATIC PRESSURE = 74 PSI±

C. R. 525 EAST

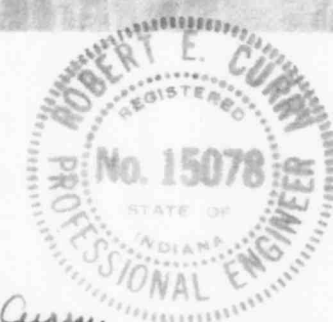

REVISIONS

DRAWN BY	D. D. E.
DATE	7-17-89
CERTIFIED BY	ROBERT E. CURRY
DATE	7-17-89

ROBERT E. CURRY & ASSOCIATES, INC.
CONSULTING ENGINEERS

ELROD WATER COMPANY INC.
DIVISION "C" DISTRIBUTION SYSTEM EXTENSIONS

S. R. 46 & C. R. 525 EAST
6" & 4" WATER MAINS

AS BUILT 10-17-90

JOB NO.	SHT.
SCALE	OF
1" = 50'	31