



C. R. 650 EAST (DOES NOT APPLY)

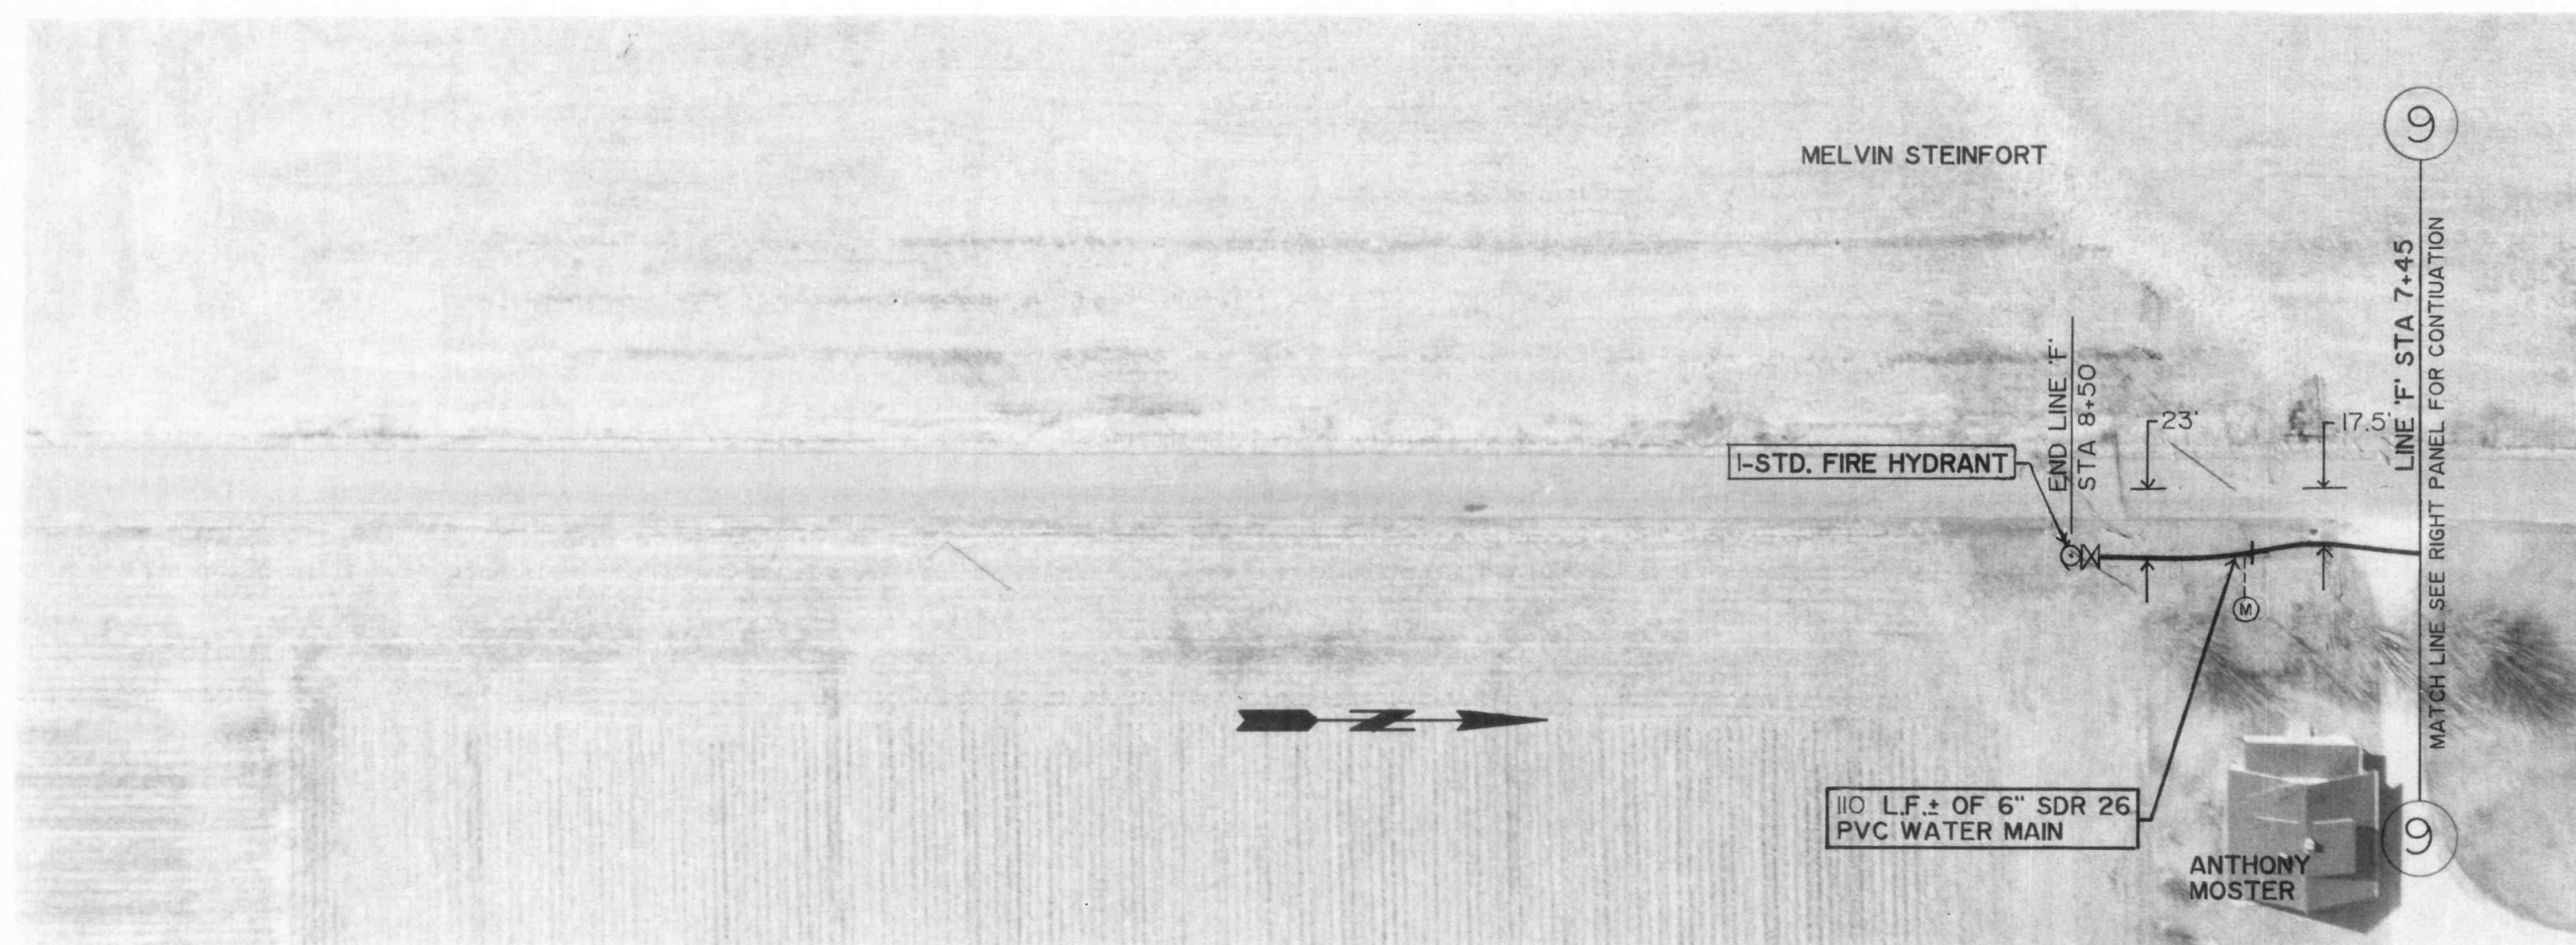

C. R. 500 EAST

GROUND ELEV. = 1000±
MAX STATIC PRESSURE = 69 PSI±

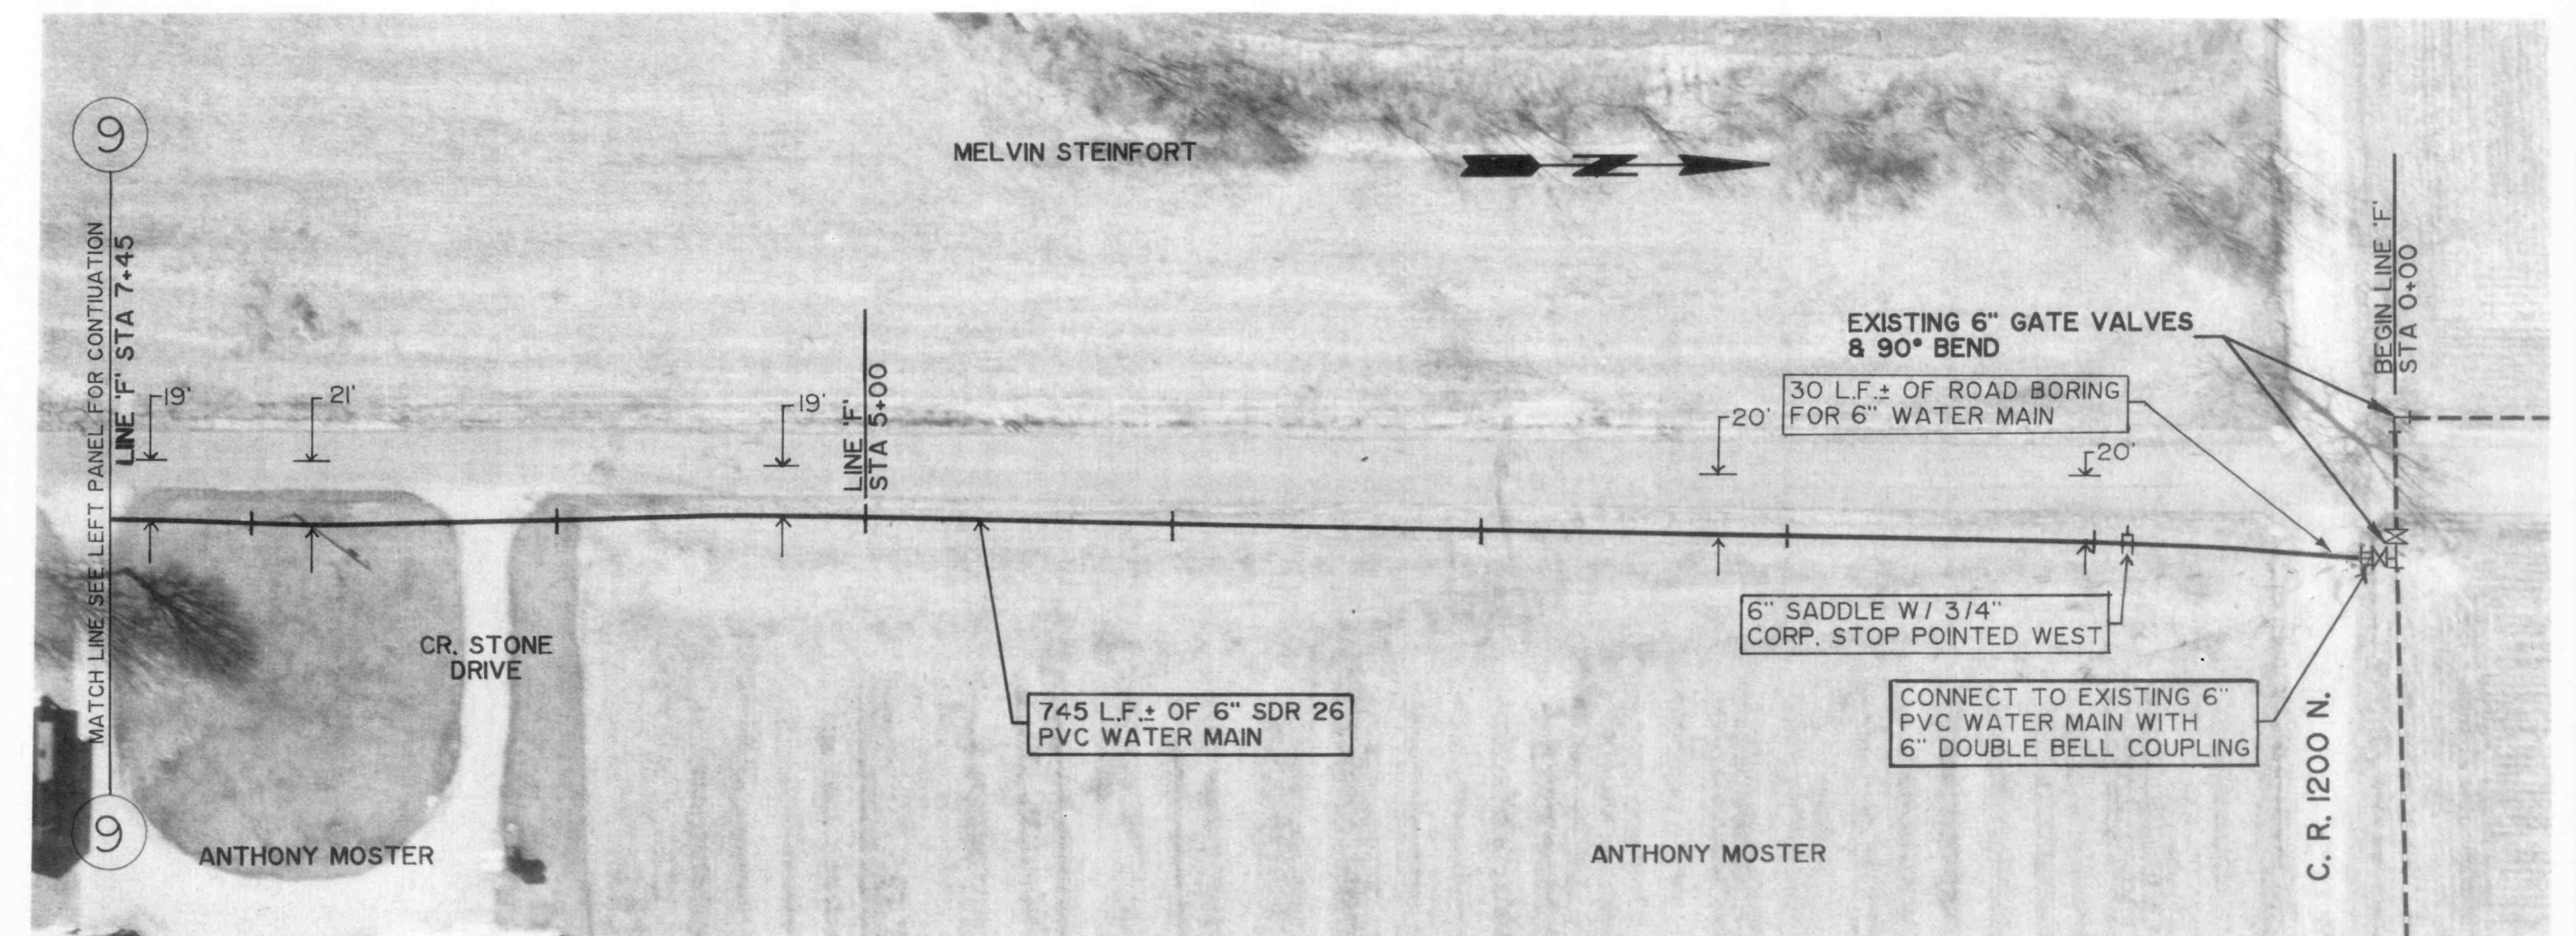

C. R. 500 EAST

GROUND ELEV. = 1000±
MAX STATIC PRESSURE = 69 PSI±



Robert E. Curry

REVISIONS

DRAWN BY	D. D. E.
DATE	7-17-89
CERTIFIED BY	ROBERT E. CURRY
DATE	7-17-89

ROBERT E. CURRY & ASSOCIATES, INC.
CONSULTING ENGINEERS

ELROD WATER COMPANY INC.
DIVISION "C" DISTRIBUTION SYSTEM EXTENSIONS

C. R. 500 EAST BEGINNING AT C. R. 1200 NORTH
6" WATER MAIN

AS BUILT 10-17-90

JOB NO.	SHT.
SCALE 1" = 50'	7 OF 31