


ELROD WATER COMPANY, INC. WATERWORKS IMPROVEMENTS

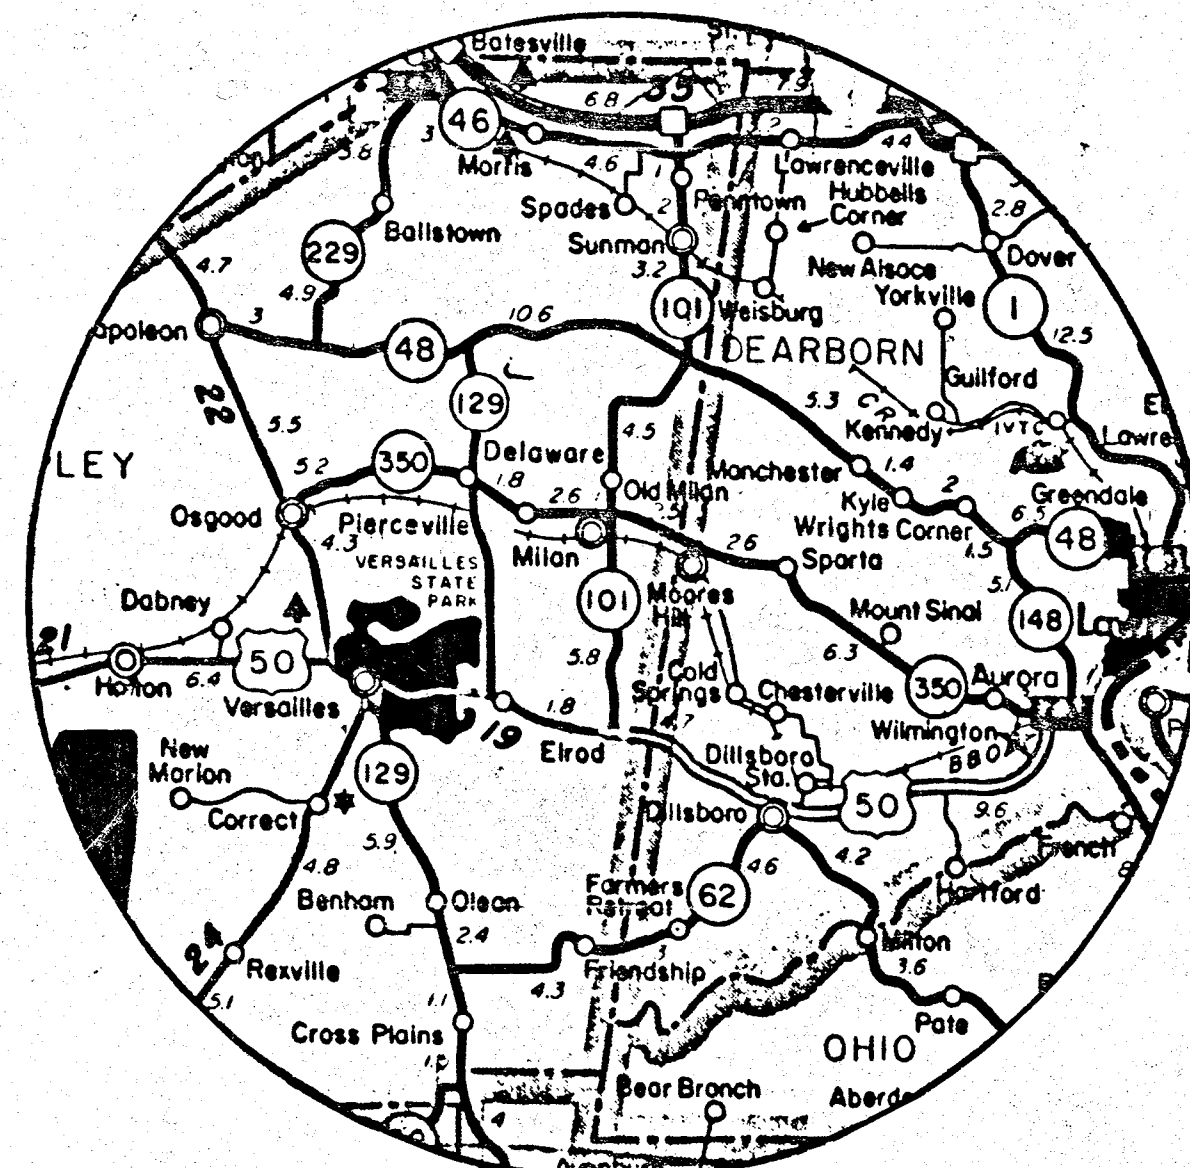

VICINITY PLAN

SCALE 1" = 5 MILES

DIVISION D WATER MAIN EXTENSIONS

ENGINEER

ROBERT E. CURRY & ASSOCIATES, INC.
ENGINEERS & ARCHITECTS
3346 AVON ROAD
PLAINFIELD, IN, 46168

RECORD DRAWINGS, SHEETS NO. 1 OF 43 THROUGH
43 OF 43 PREPARED BY M. D. WESSLER & ASSOC.
JUNE 23, 1994

BOARD MEMBERS

ROBERT C. EVERAGE, PRESIDENT	JOYCE HUFFMAN, VICE-PRES.
HENRY WESTERMAN, TREASURER	ARLEENA NICKJUS, SECRETARY
ED ALLGEIER, MEMBER	DANIEL SCHMALTZ, MEMBER
JEFFERY LAUB, MEMBER	NELSON ELLIOTT, MEMBER
FRANK MARTIN, MEMBER	MARY ENGEL, OFFICE MGR.
JEFF MEINDERS, WATER SUPERINTENDENT	